


GENE & FRISCILLA, RONEZ  
9-6-61 D.V. 804 PG. 725  
N 88° 53' E

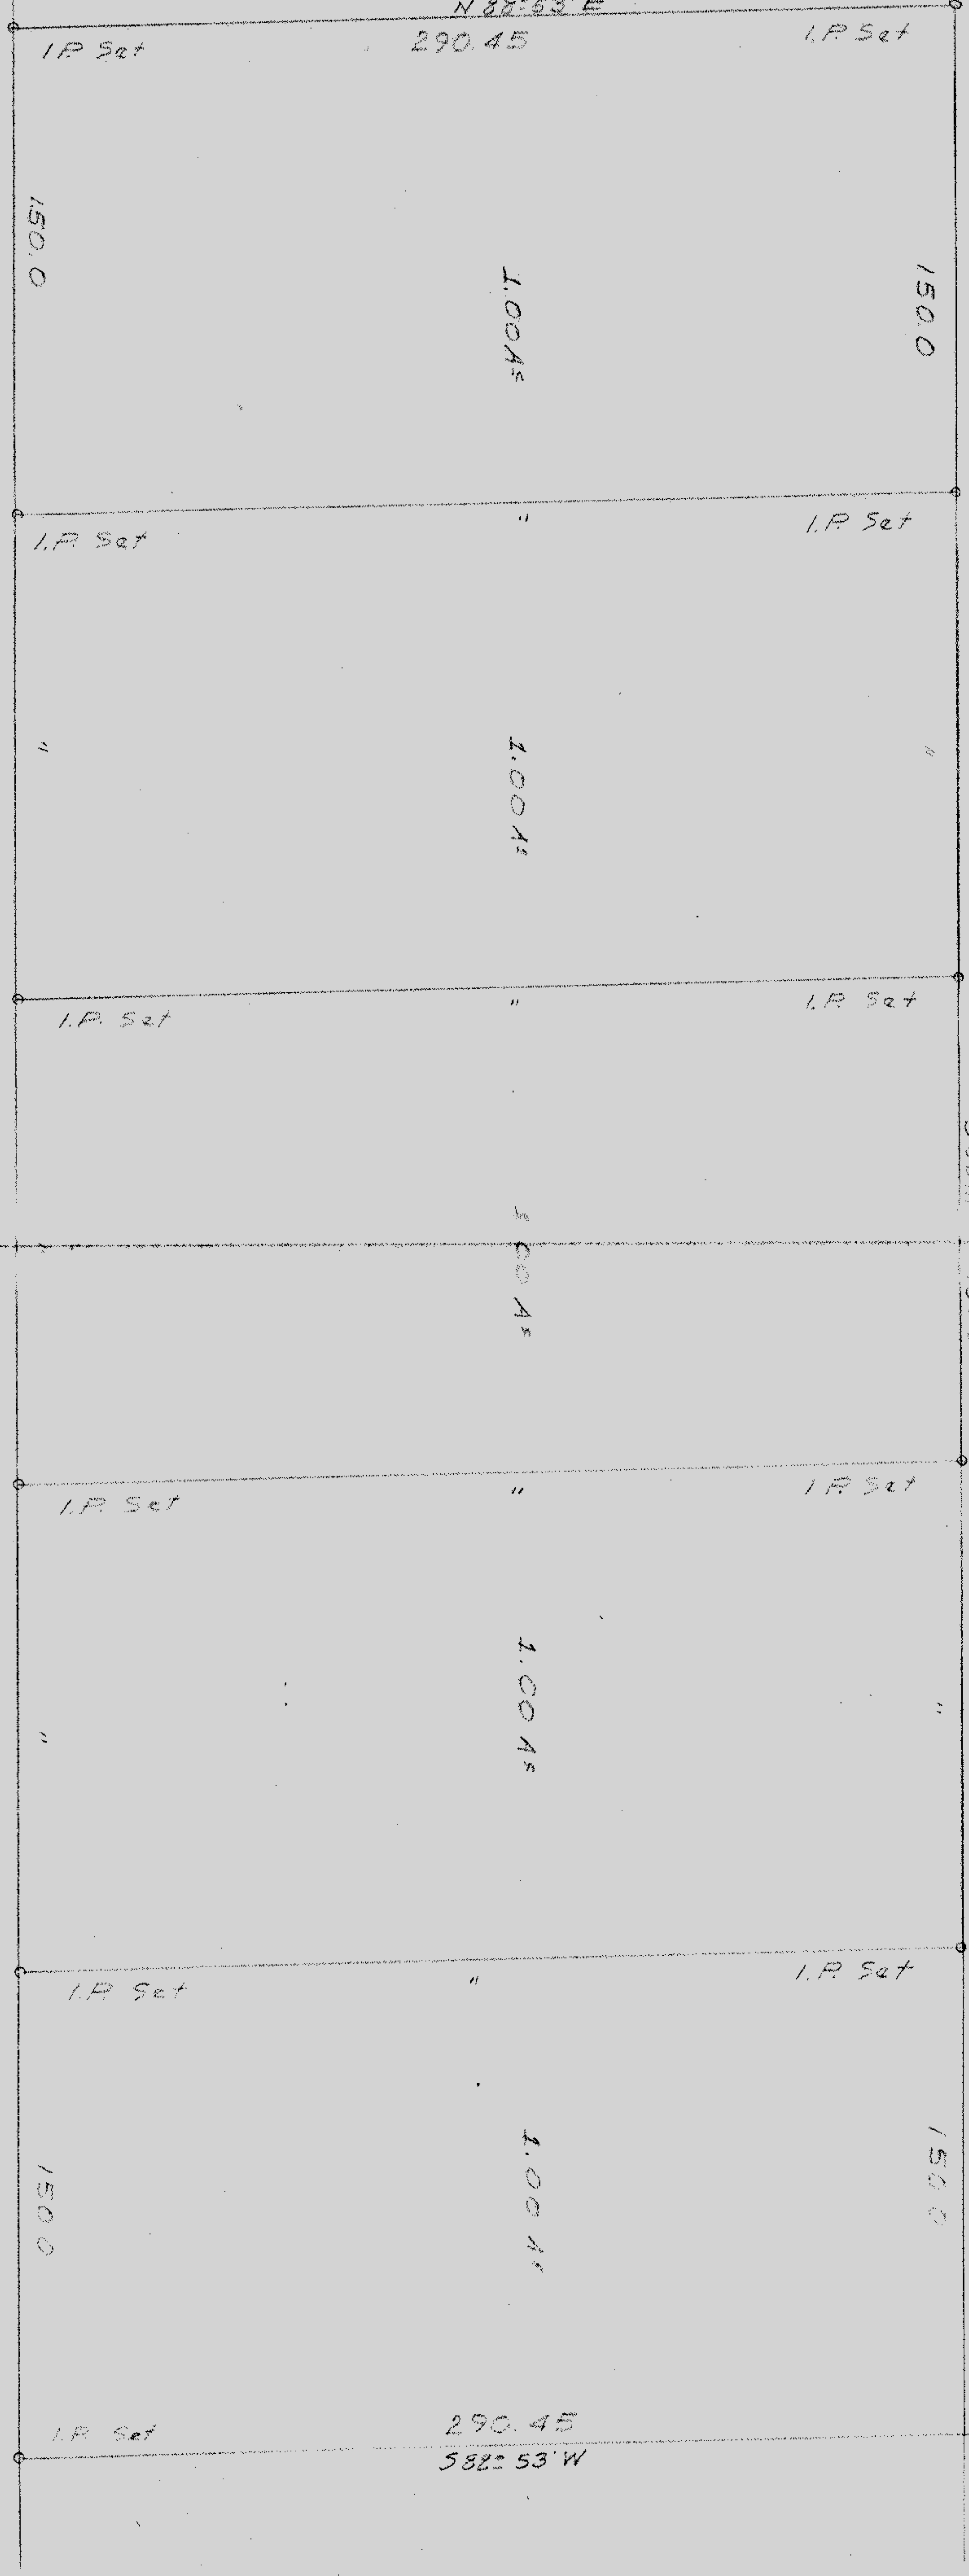

VERMILION

ROAD

North 7500

60'

43704

IP NOT SET  
UNPICKED CORN

CLIPED FOR H.C. PATES  
MURIEL TWP. OLD TRUB LORAIN CO. OHIO  
DATE 11-25-61 AUGUST 1963  
SECTION 2 TWP 11N R 14E V 18E

PPN 08-12-005-000-777

MAP PG 8 F