


07-00-021-101-034
7-00-021-A

PPN 07-00-021-101-034

MAP PG 7-00-021-A
43719

Margaret Curran 10/28/55
D.V. 846-381
N 87° 51' E

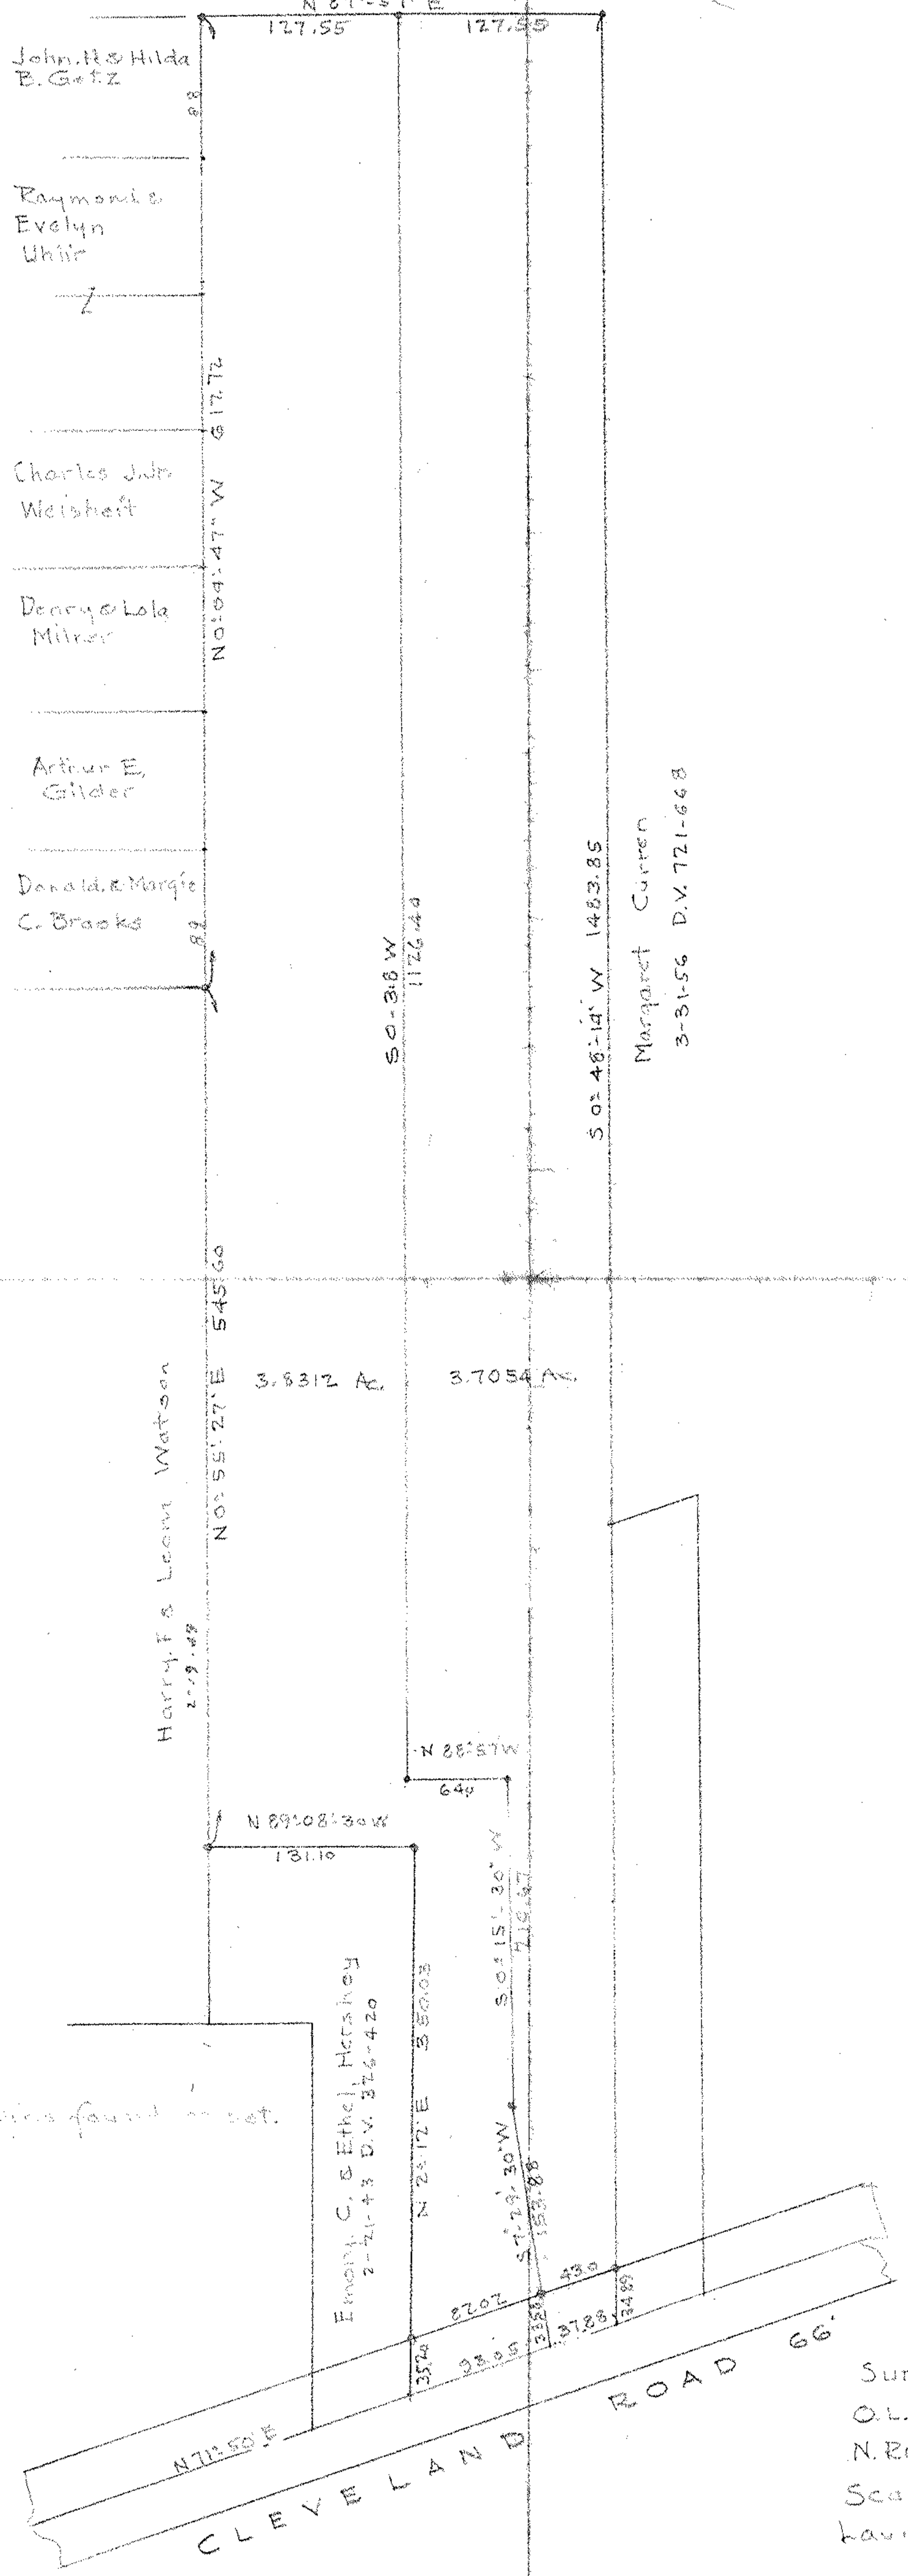

• Iron pins found on lot.

Survey for Clara Demison
O.L. 21 Ridgville Twp.
N. Ridgville City, Lorain Co. Ohio
Scale 1" = 100' 12/4/62
Lavender & Huffman Surveyors.