


MAP PG 6-86
43730



EDWARD F. HOBAN, BISHOP

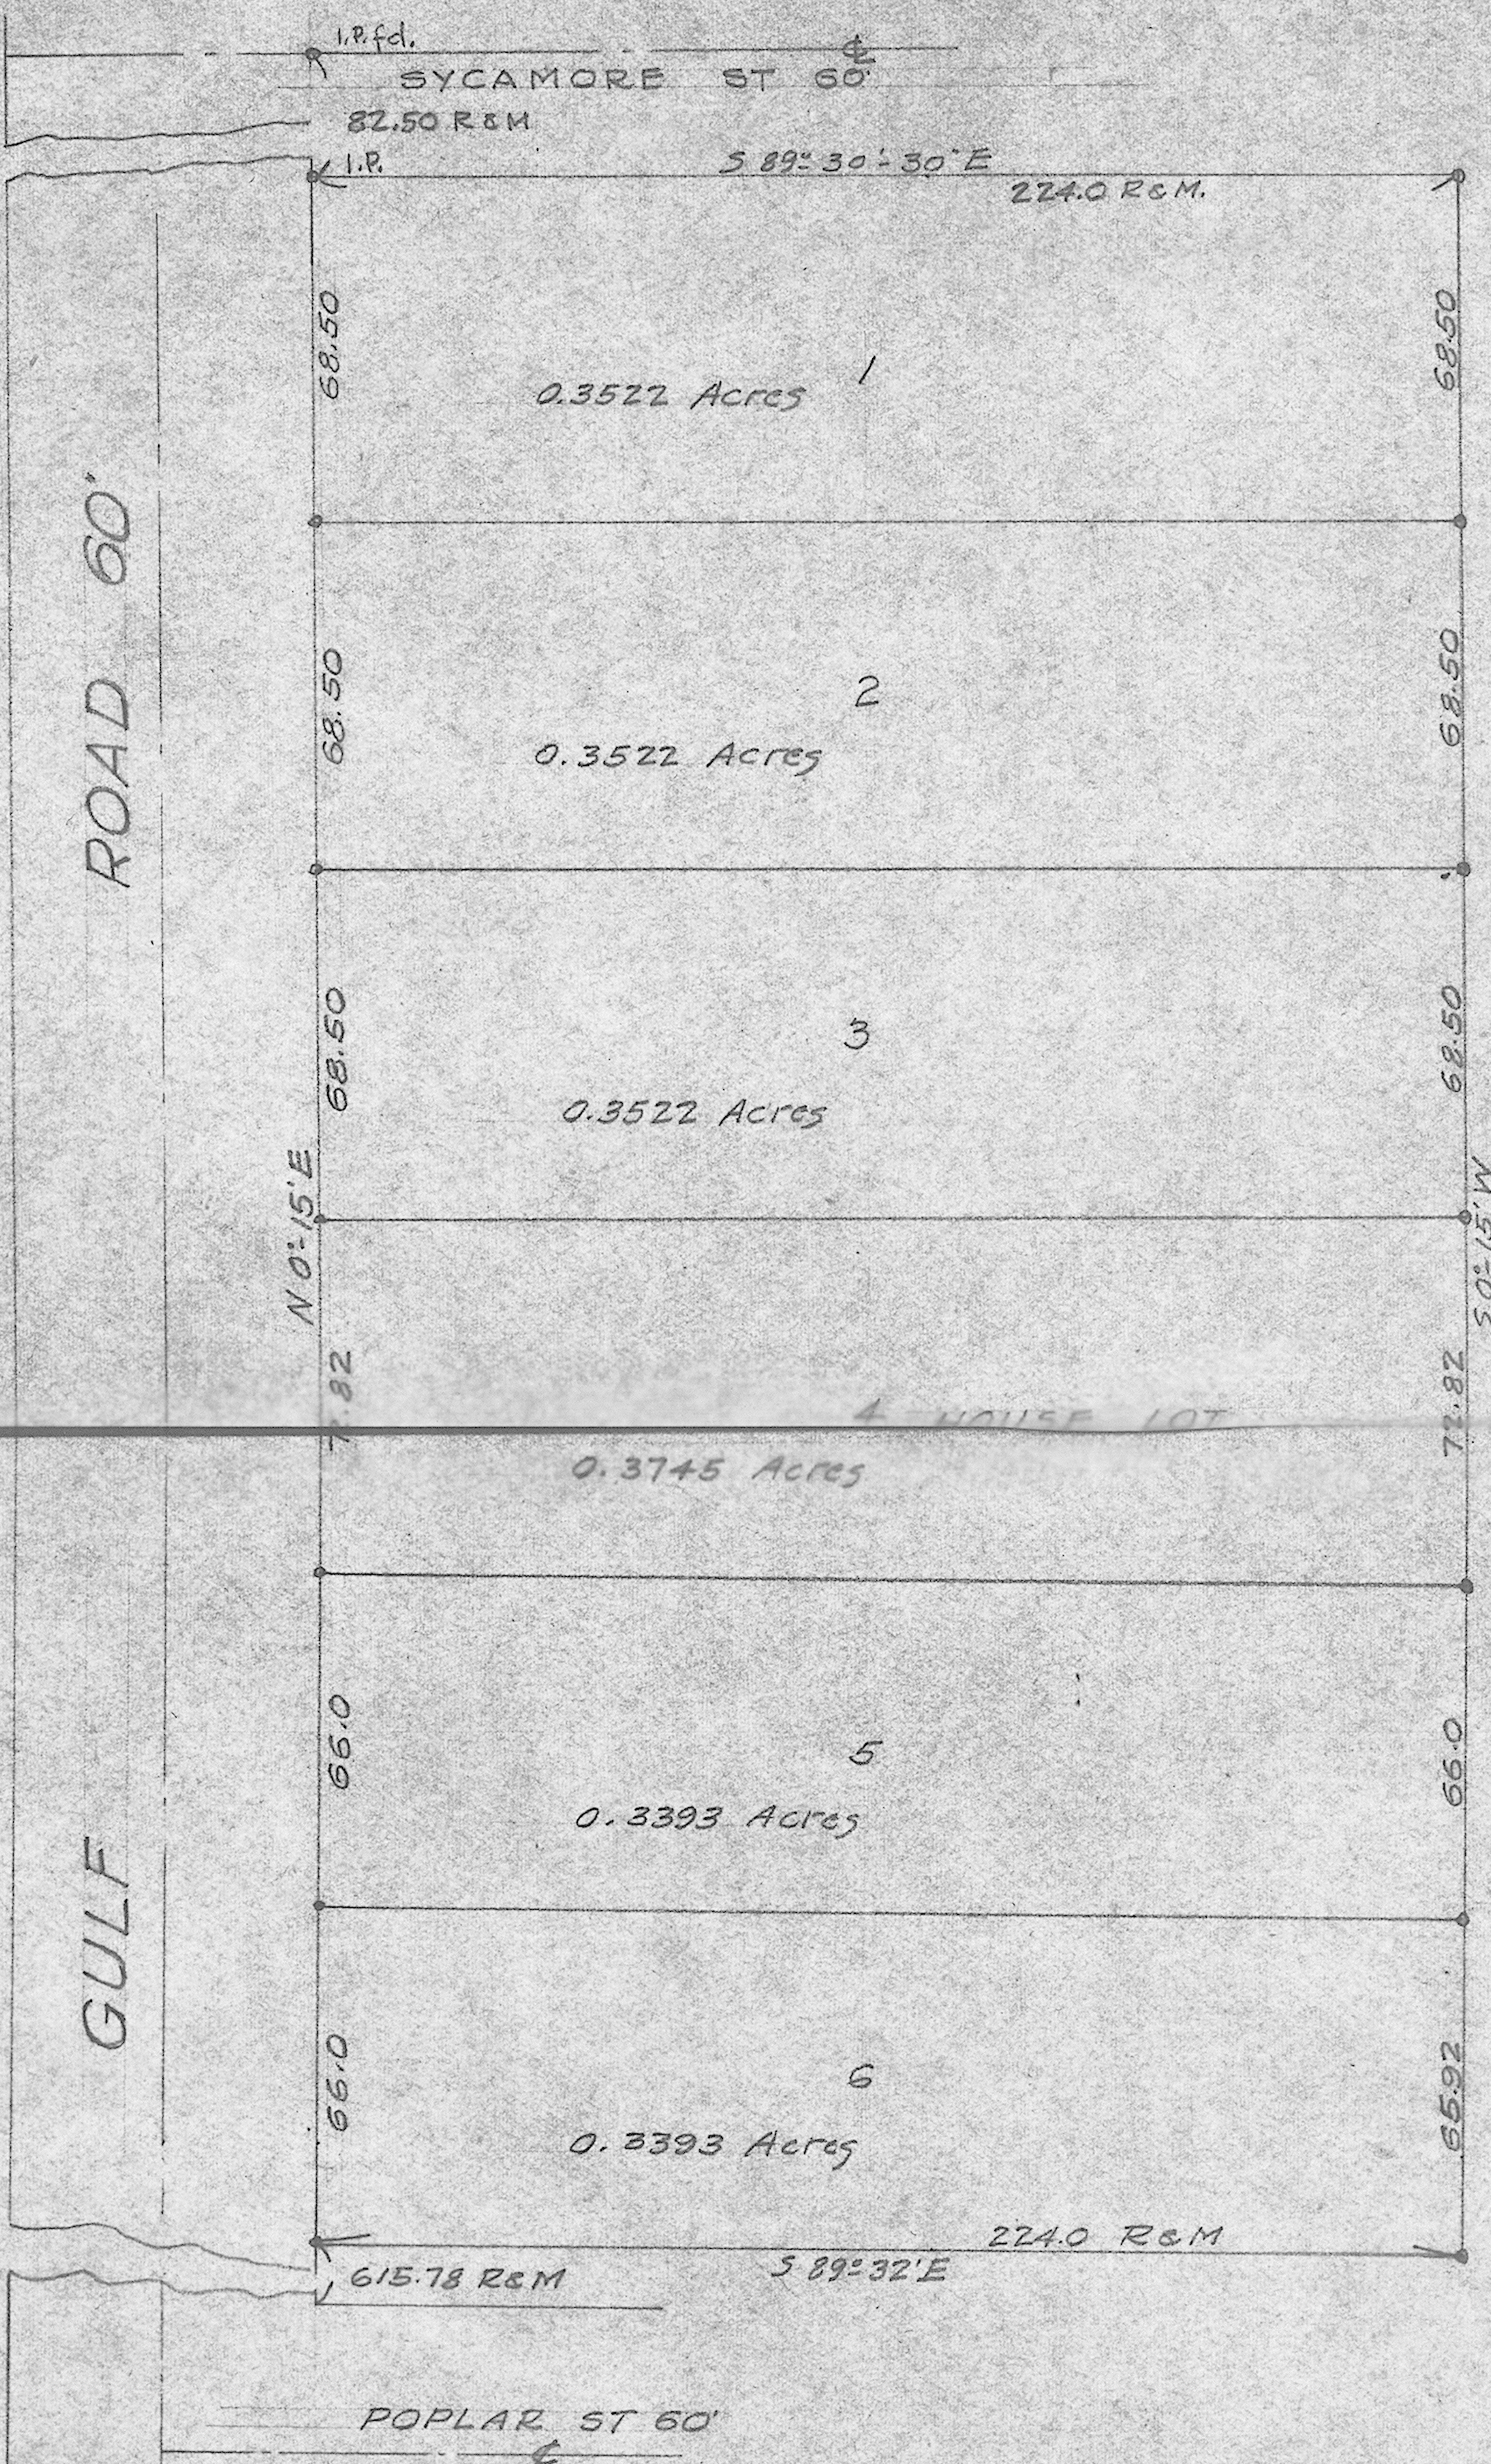

SURVEY FOR FRANK GERHARDINGER
PART OF ORIGINAL TWP. LOT 33 E. OF BLACK RIVER
ELYRIA TWP & CITY, LORAIN CO. OHIO.

LEGEND.
• INDICATES IRON PINS FOUND OR SET
R&M. - record & measured.
LOTS NUMBERED FOR CONVENIENCE
IN IDENTIFICATION

SCALE 1" = 40'
T.W. LAUNDON REGISTERED SURVEYOR
DEC. 4, 1947