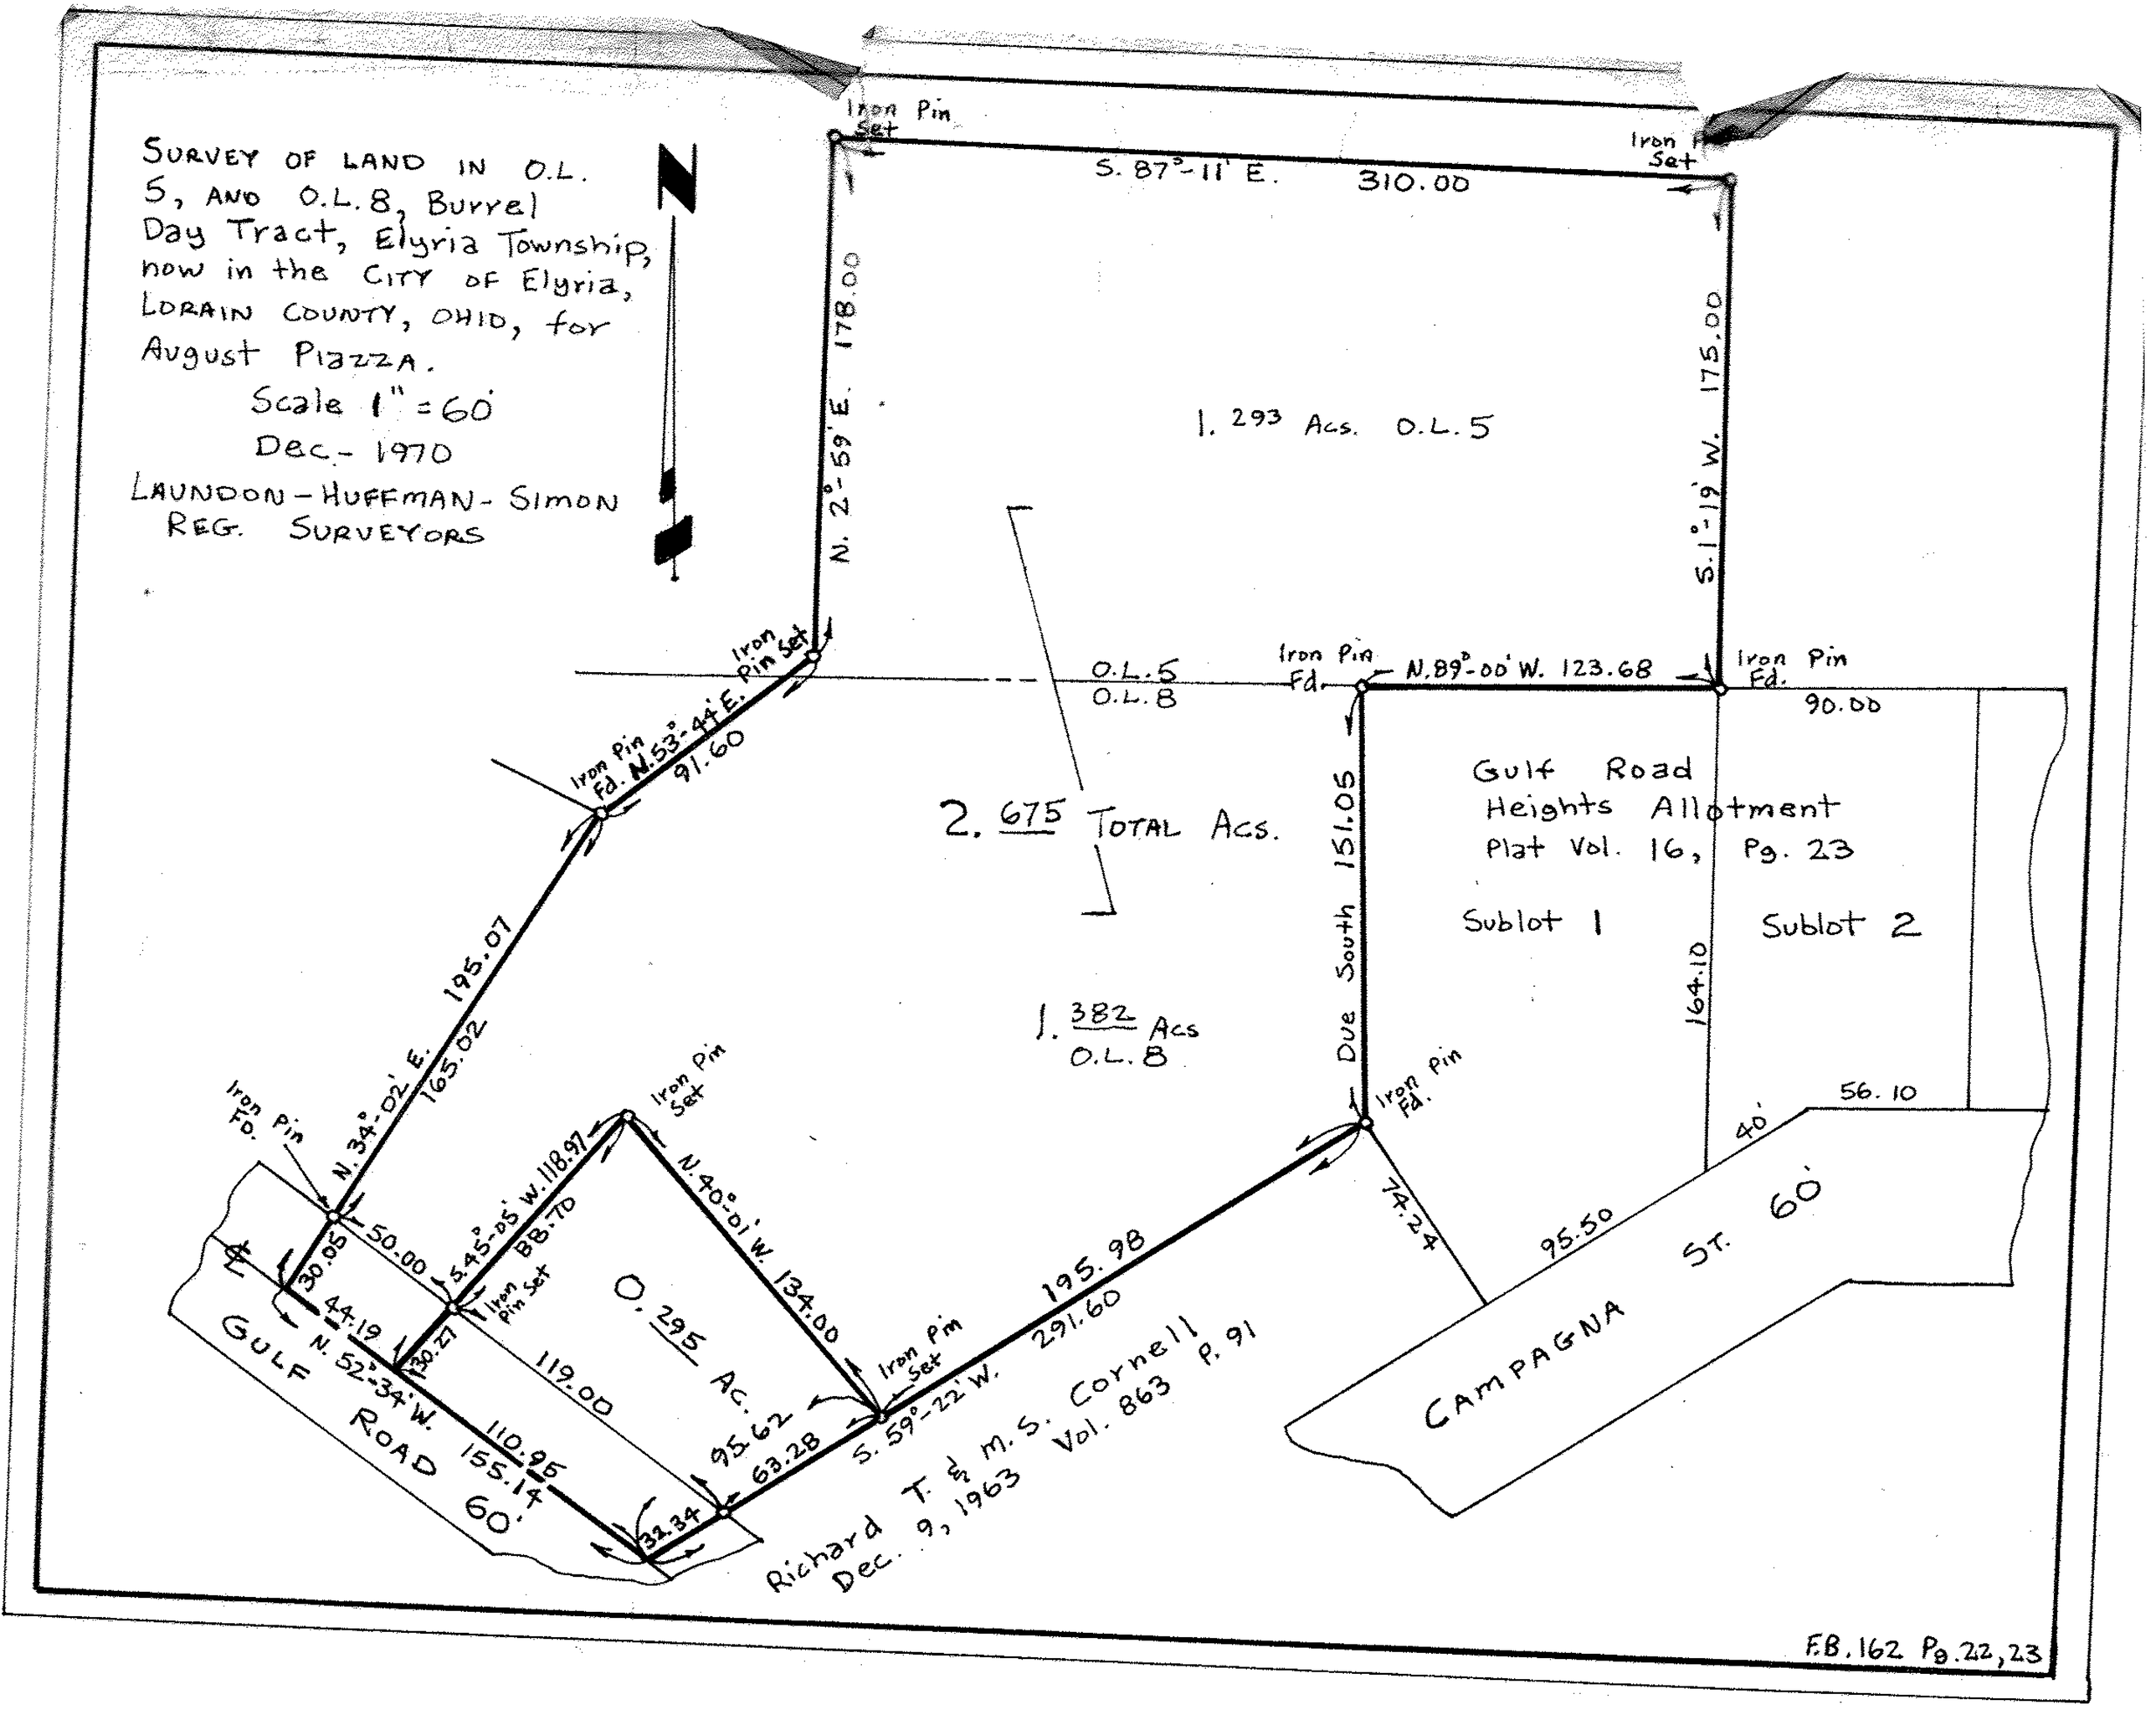
SURVEY OF LAND IN O.L. 5, AND O.L. 8, Burrel Day Tract, Elyria Township, now in the CITY OF Elyria, LORAIN COUNTY, OHIO, for August Piazza.
Scale 1" = 60'
Dec. - 1970
LAUNDON - HUFFMAN - SIMON REG. SURVEYORS
N
Iron Pin Set
S. 87°-11' E. 310.00
N. 2°-59' E. 178.00
S. 1°-19' W. 175.00
1. 293 Acs. O.L. 5
O.L. 5
O.L. 8
Iron Pin Fd.
N. 89°-00' W. 123.68
90.00
Iron Pin Fd. N. 53°-44' E. 91.60
2. 675 TOTAL Acs.
Gulf Road Heights Allotment Plat Vol. 16, Pg. 23
Sublot 1
Sublot 2
151.05
Due South
164.10
1. 382 Acs O.L. 8
N. 34°-02' E. 195.07
165.02
Iron Pin Fd.
56.10
40'
74.24
95.50
CAMPAGNA ST. 60'
Iron Pin Set
S. 45°-05' W. 118.97
88.70
N. 40°-01' W. 134.00
50.00
30.05
44.19
30.27
N. 52°-34' W. 110.95
155.14
GULF ROAD 60'
119.00
O. 295 Ac.
95.62
63.28
32.34
S. 59°-22' W. 195.98
291.60
Richard T. & M.S. Cornell Dec. 9, 1963 Vol. 863 P. 91
F.B. 162 Pg. 22, 23