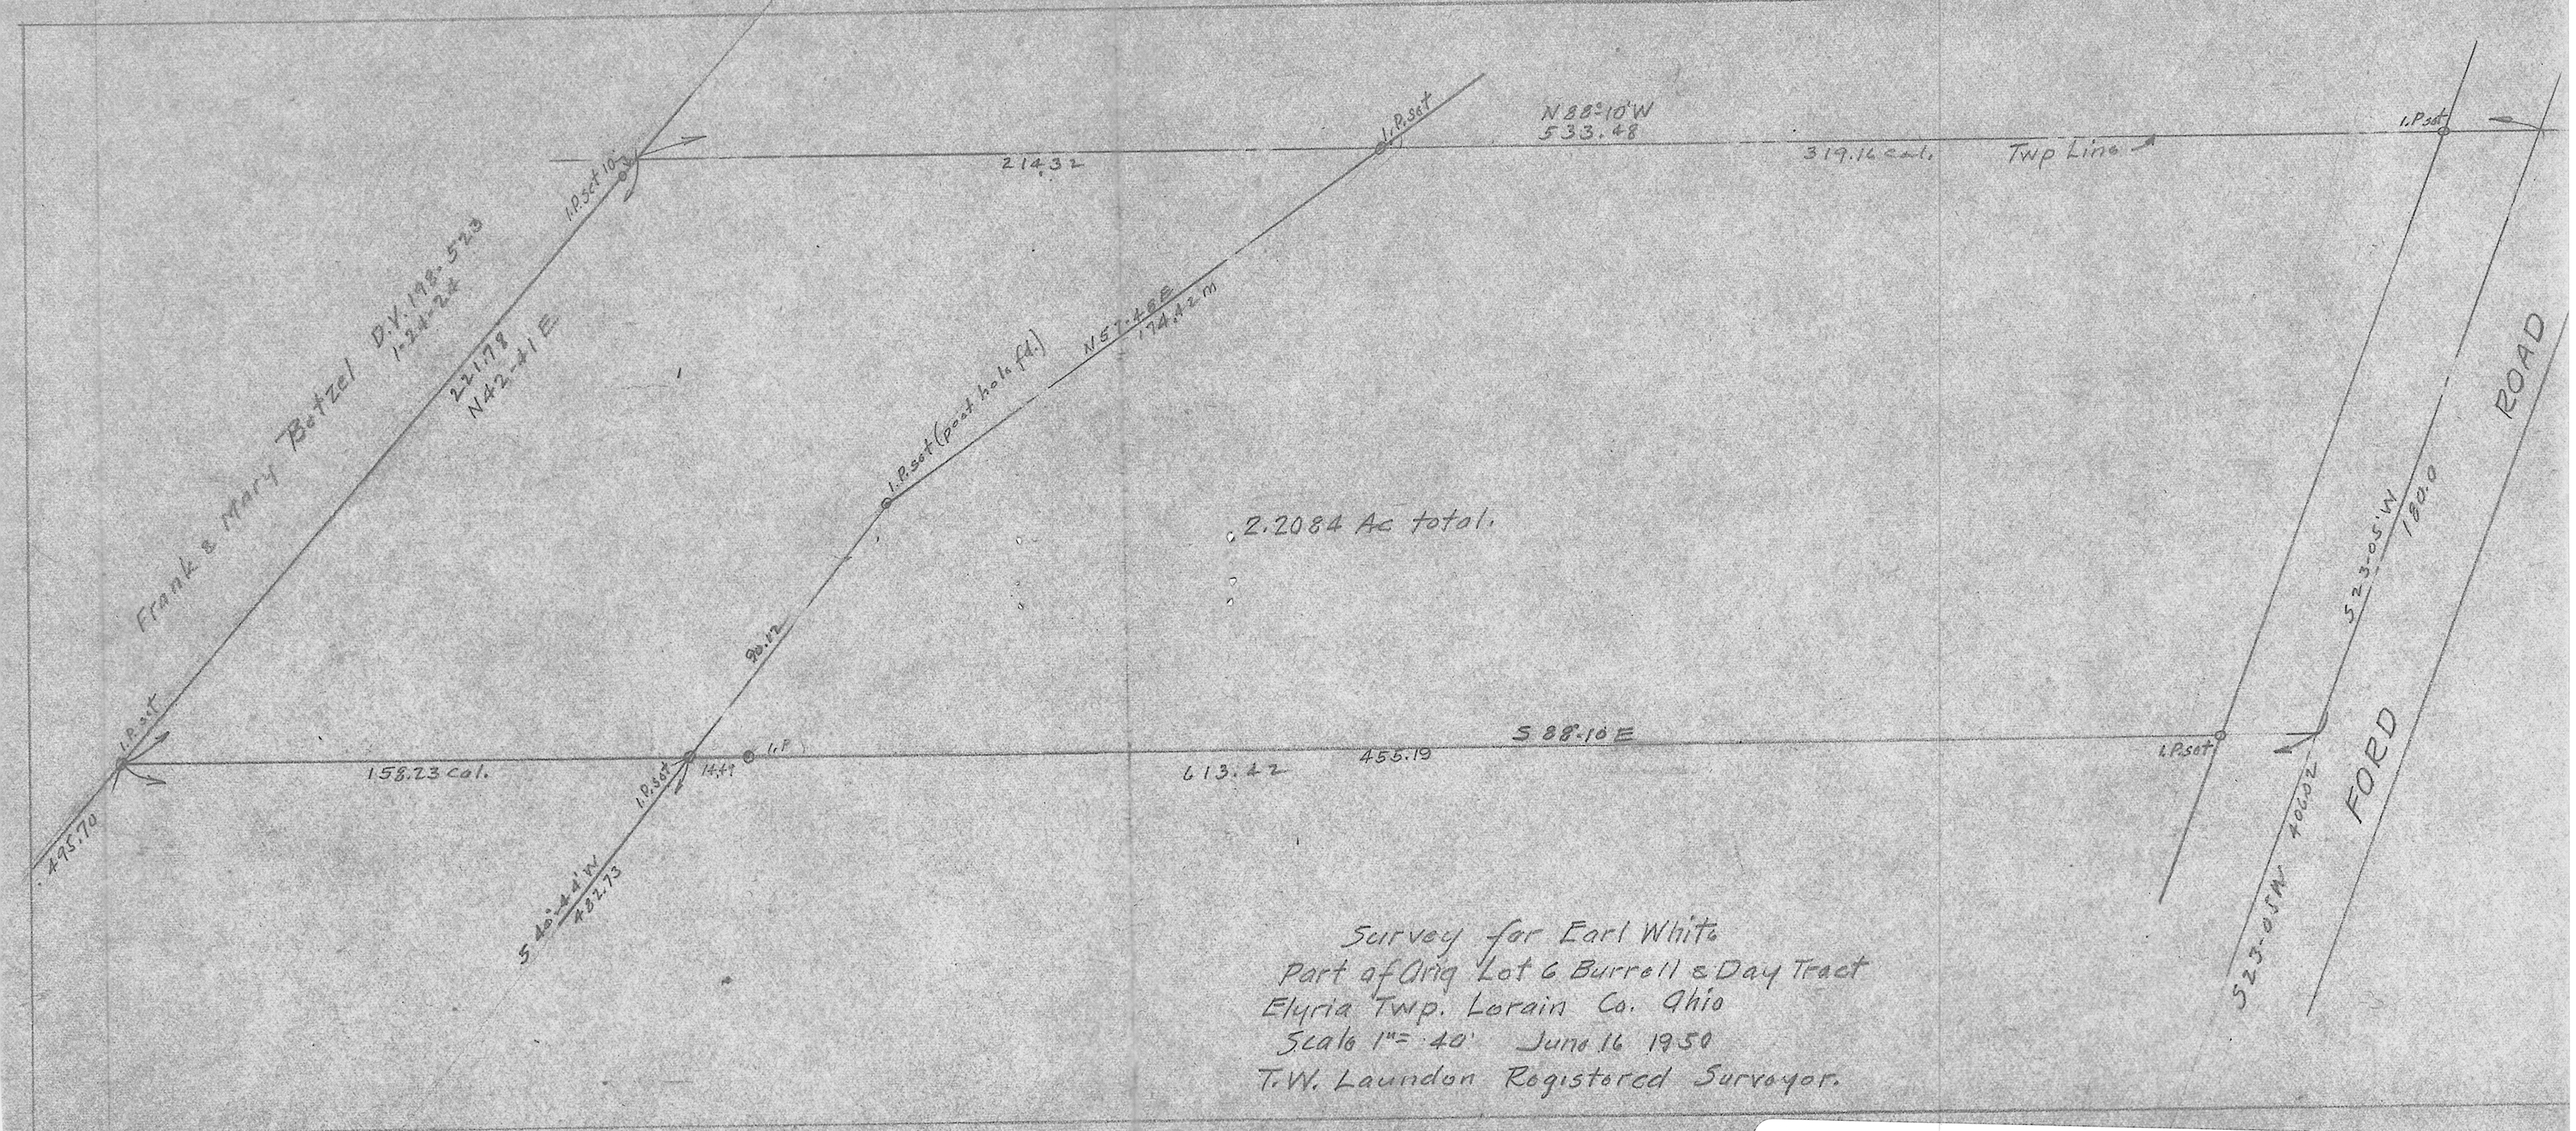


Survey for Earl White
Part of Orig Lot 6 Burrell & Day Tract
Elyria Twp. Lorain Co. Ohio
Scale 1" = 40' June 16 1950
T.W. Laundon Registered Surveyor.