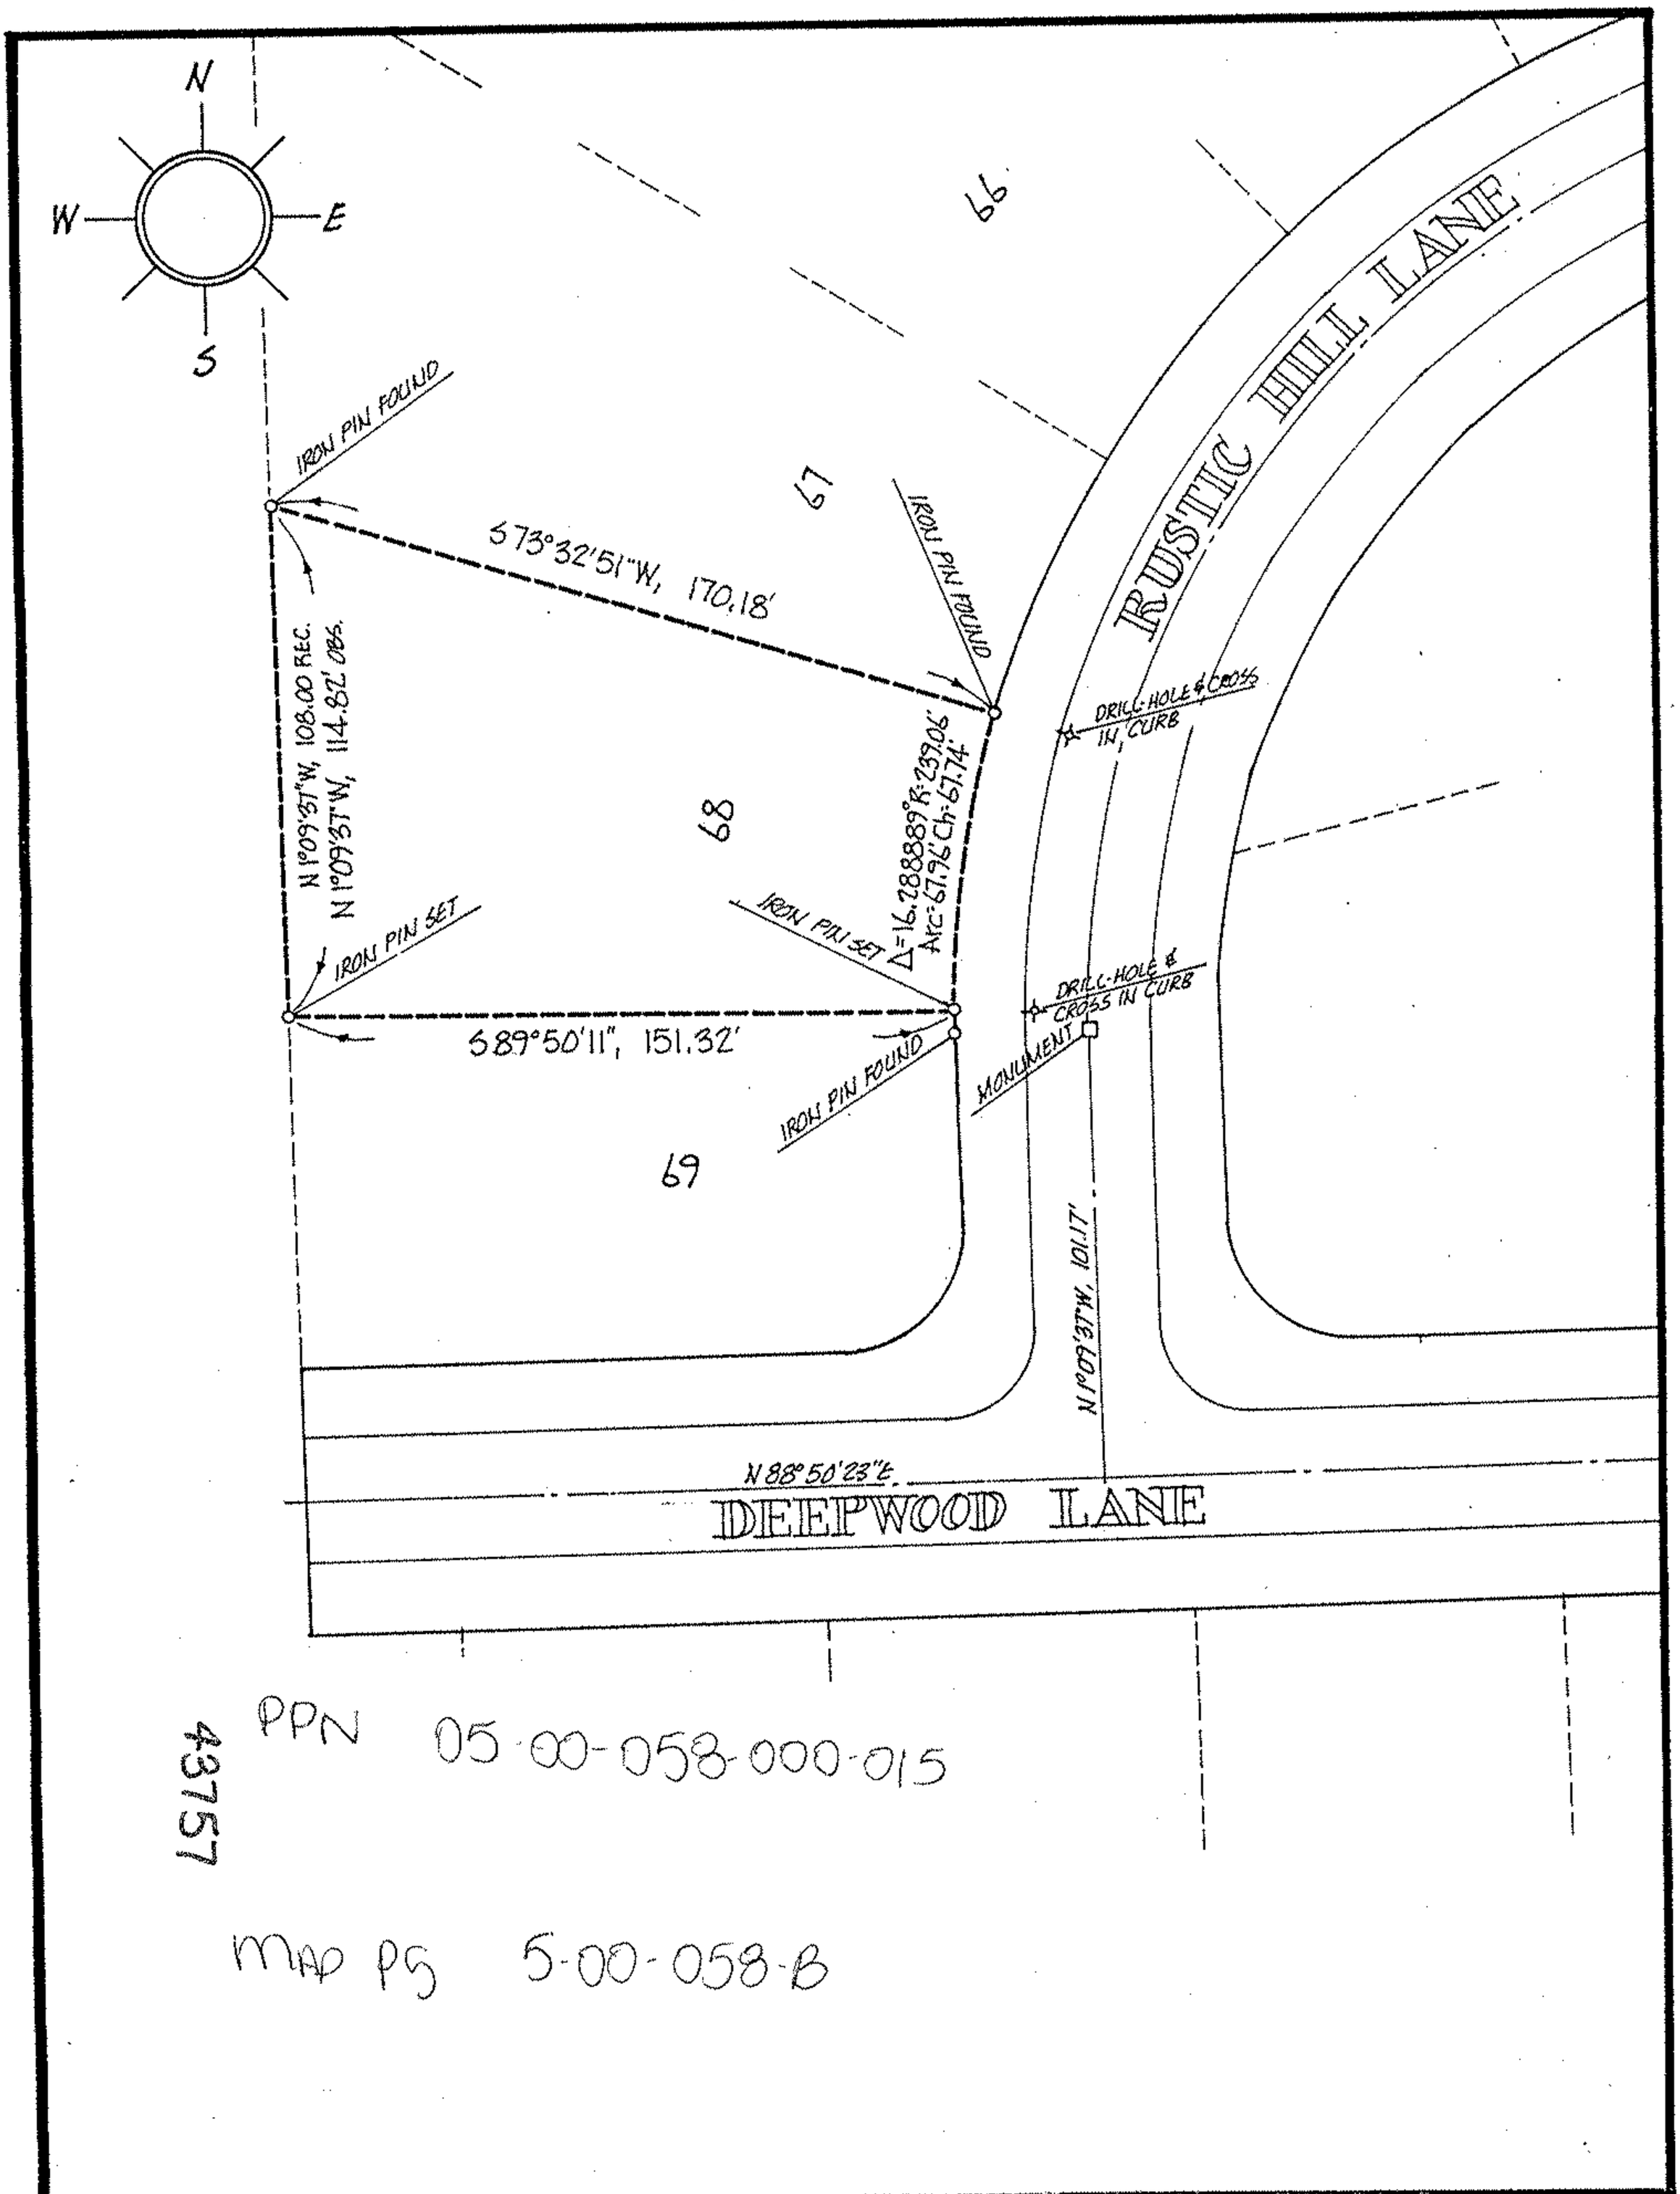

ACREAGE	
DATE	06-25-86
DRAWN	MGH
SCALE	1" = 50 ft.

STATE OF OHIO
MICHAEL G. HURA
No. 4712
REGISTERED SURVEYOR

PREPARED FOR MR. & MRS LEROY REYNOLDS
242 RUSTIC HILL LN., LORAIN

MICHAEL G. HURA, registered surveyor
12706 MASON RD., VERMILION, O., Ph (216) 965 4040

CITY OF

PERIMETER SURVEY

SUBLOT(s) 68 of HIDDEN VALLEY SUBDN Nº 1
, Volume 31 Page 34 of PLATS
PART OF O.L. 59 TRACT SECTION OF
AMHERST TOWNSHIP LORAIN CO., OHIO
PERMANENT PARCEL Nº