05-00-038-106
05-00-038-B

PPN 05-00-038-106-???

MAP PS 5-00-038-B
43759

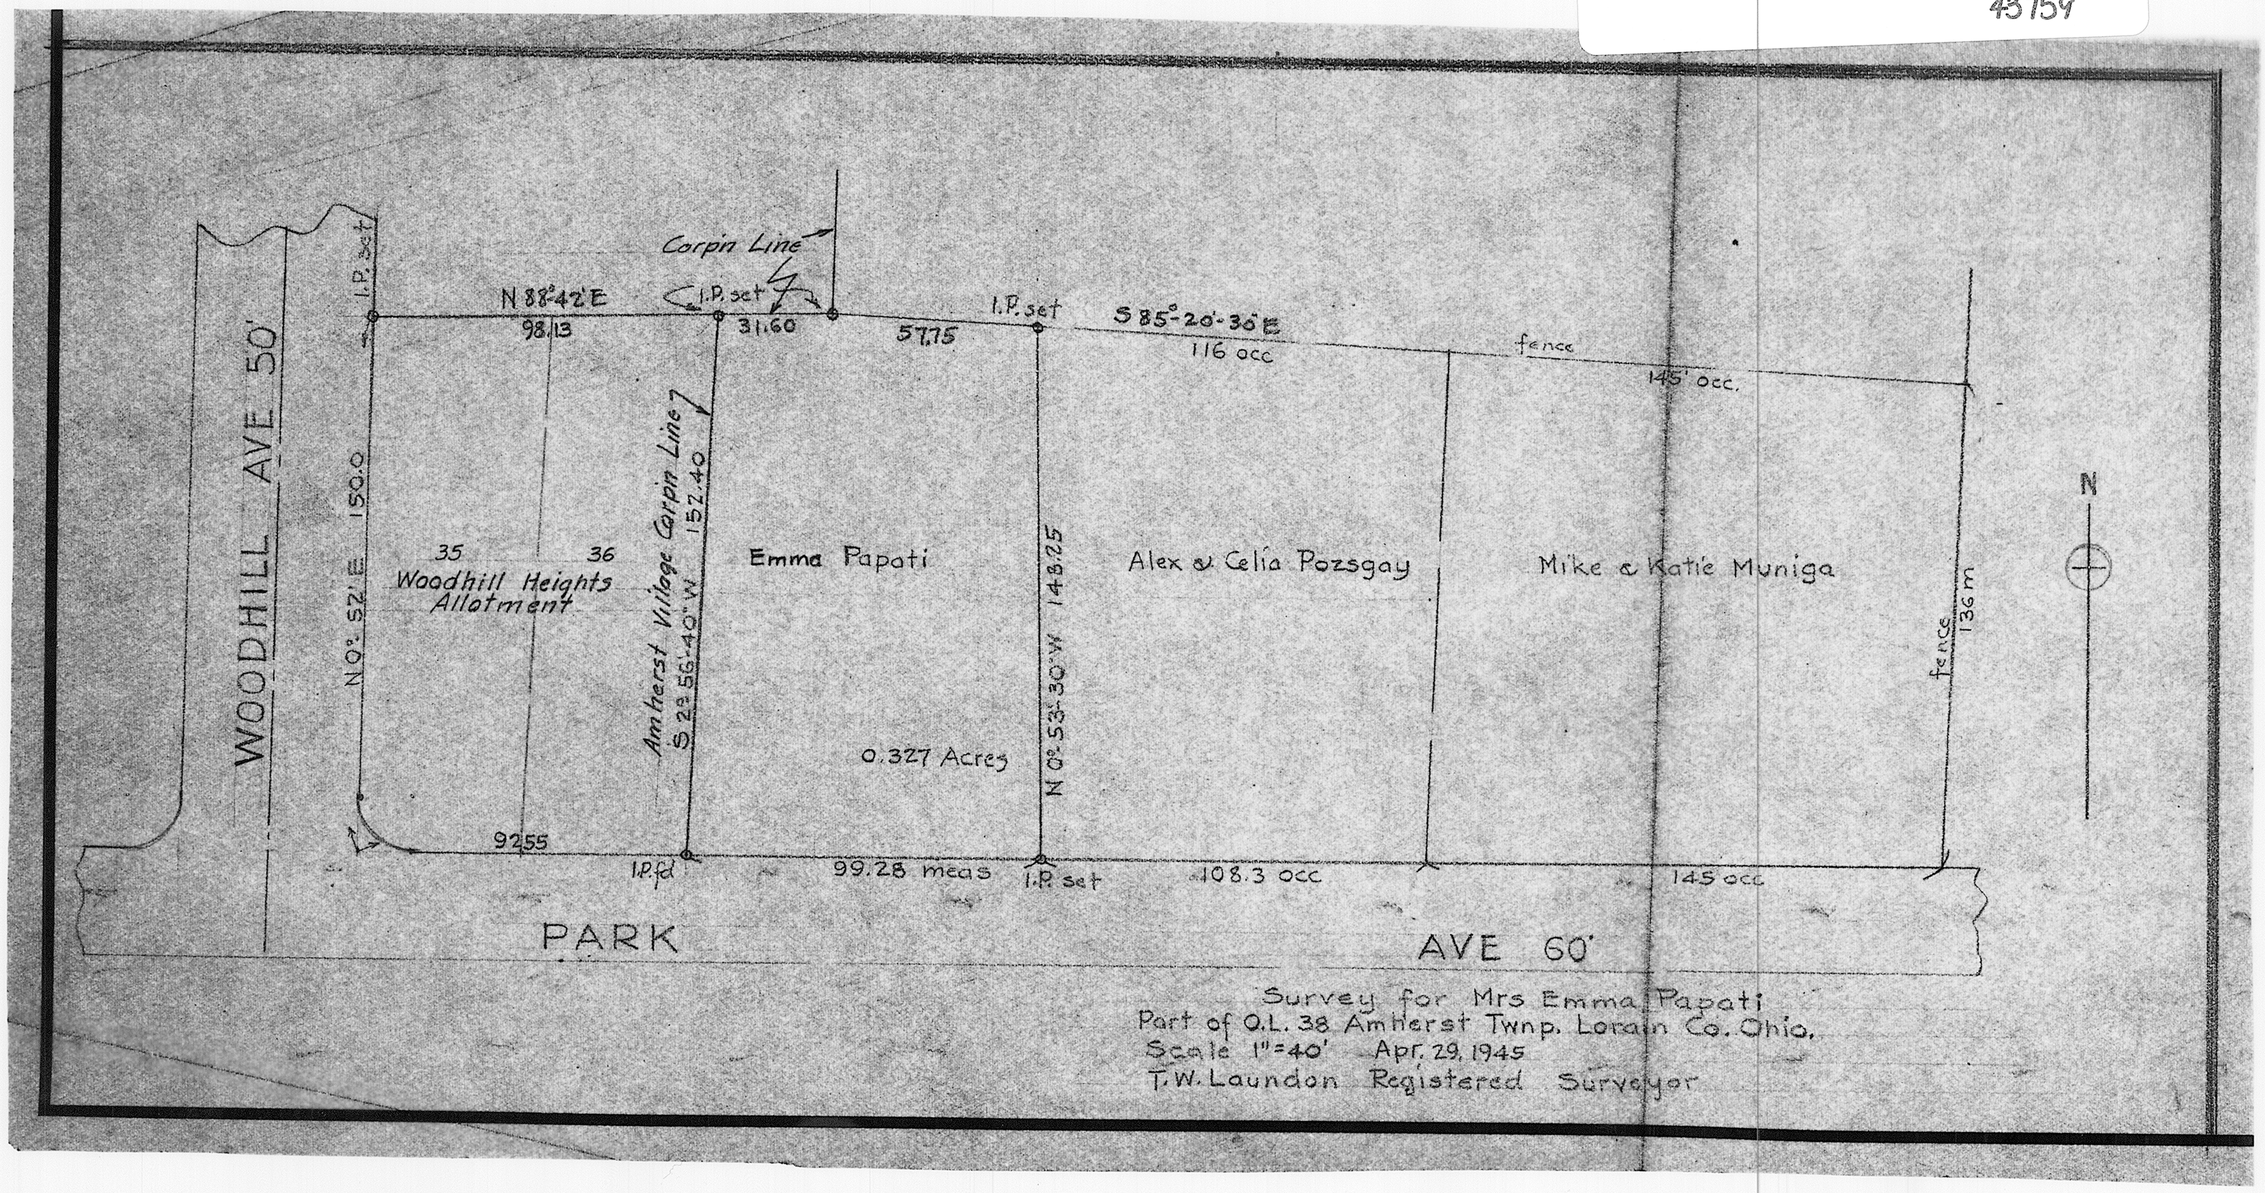

Survey for Mrs Emma Papati
Part of O.L. 38 Amherst Twnp. Lorain Co. Ohio.
Scale 1" = 40' Apr. 29, 1945
T.W. Laundon Registered Surveyor