
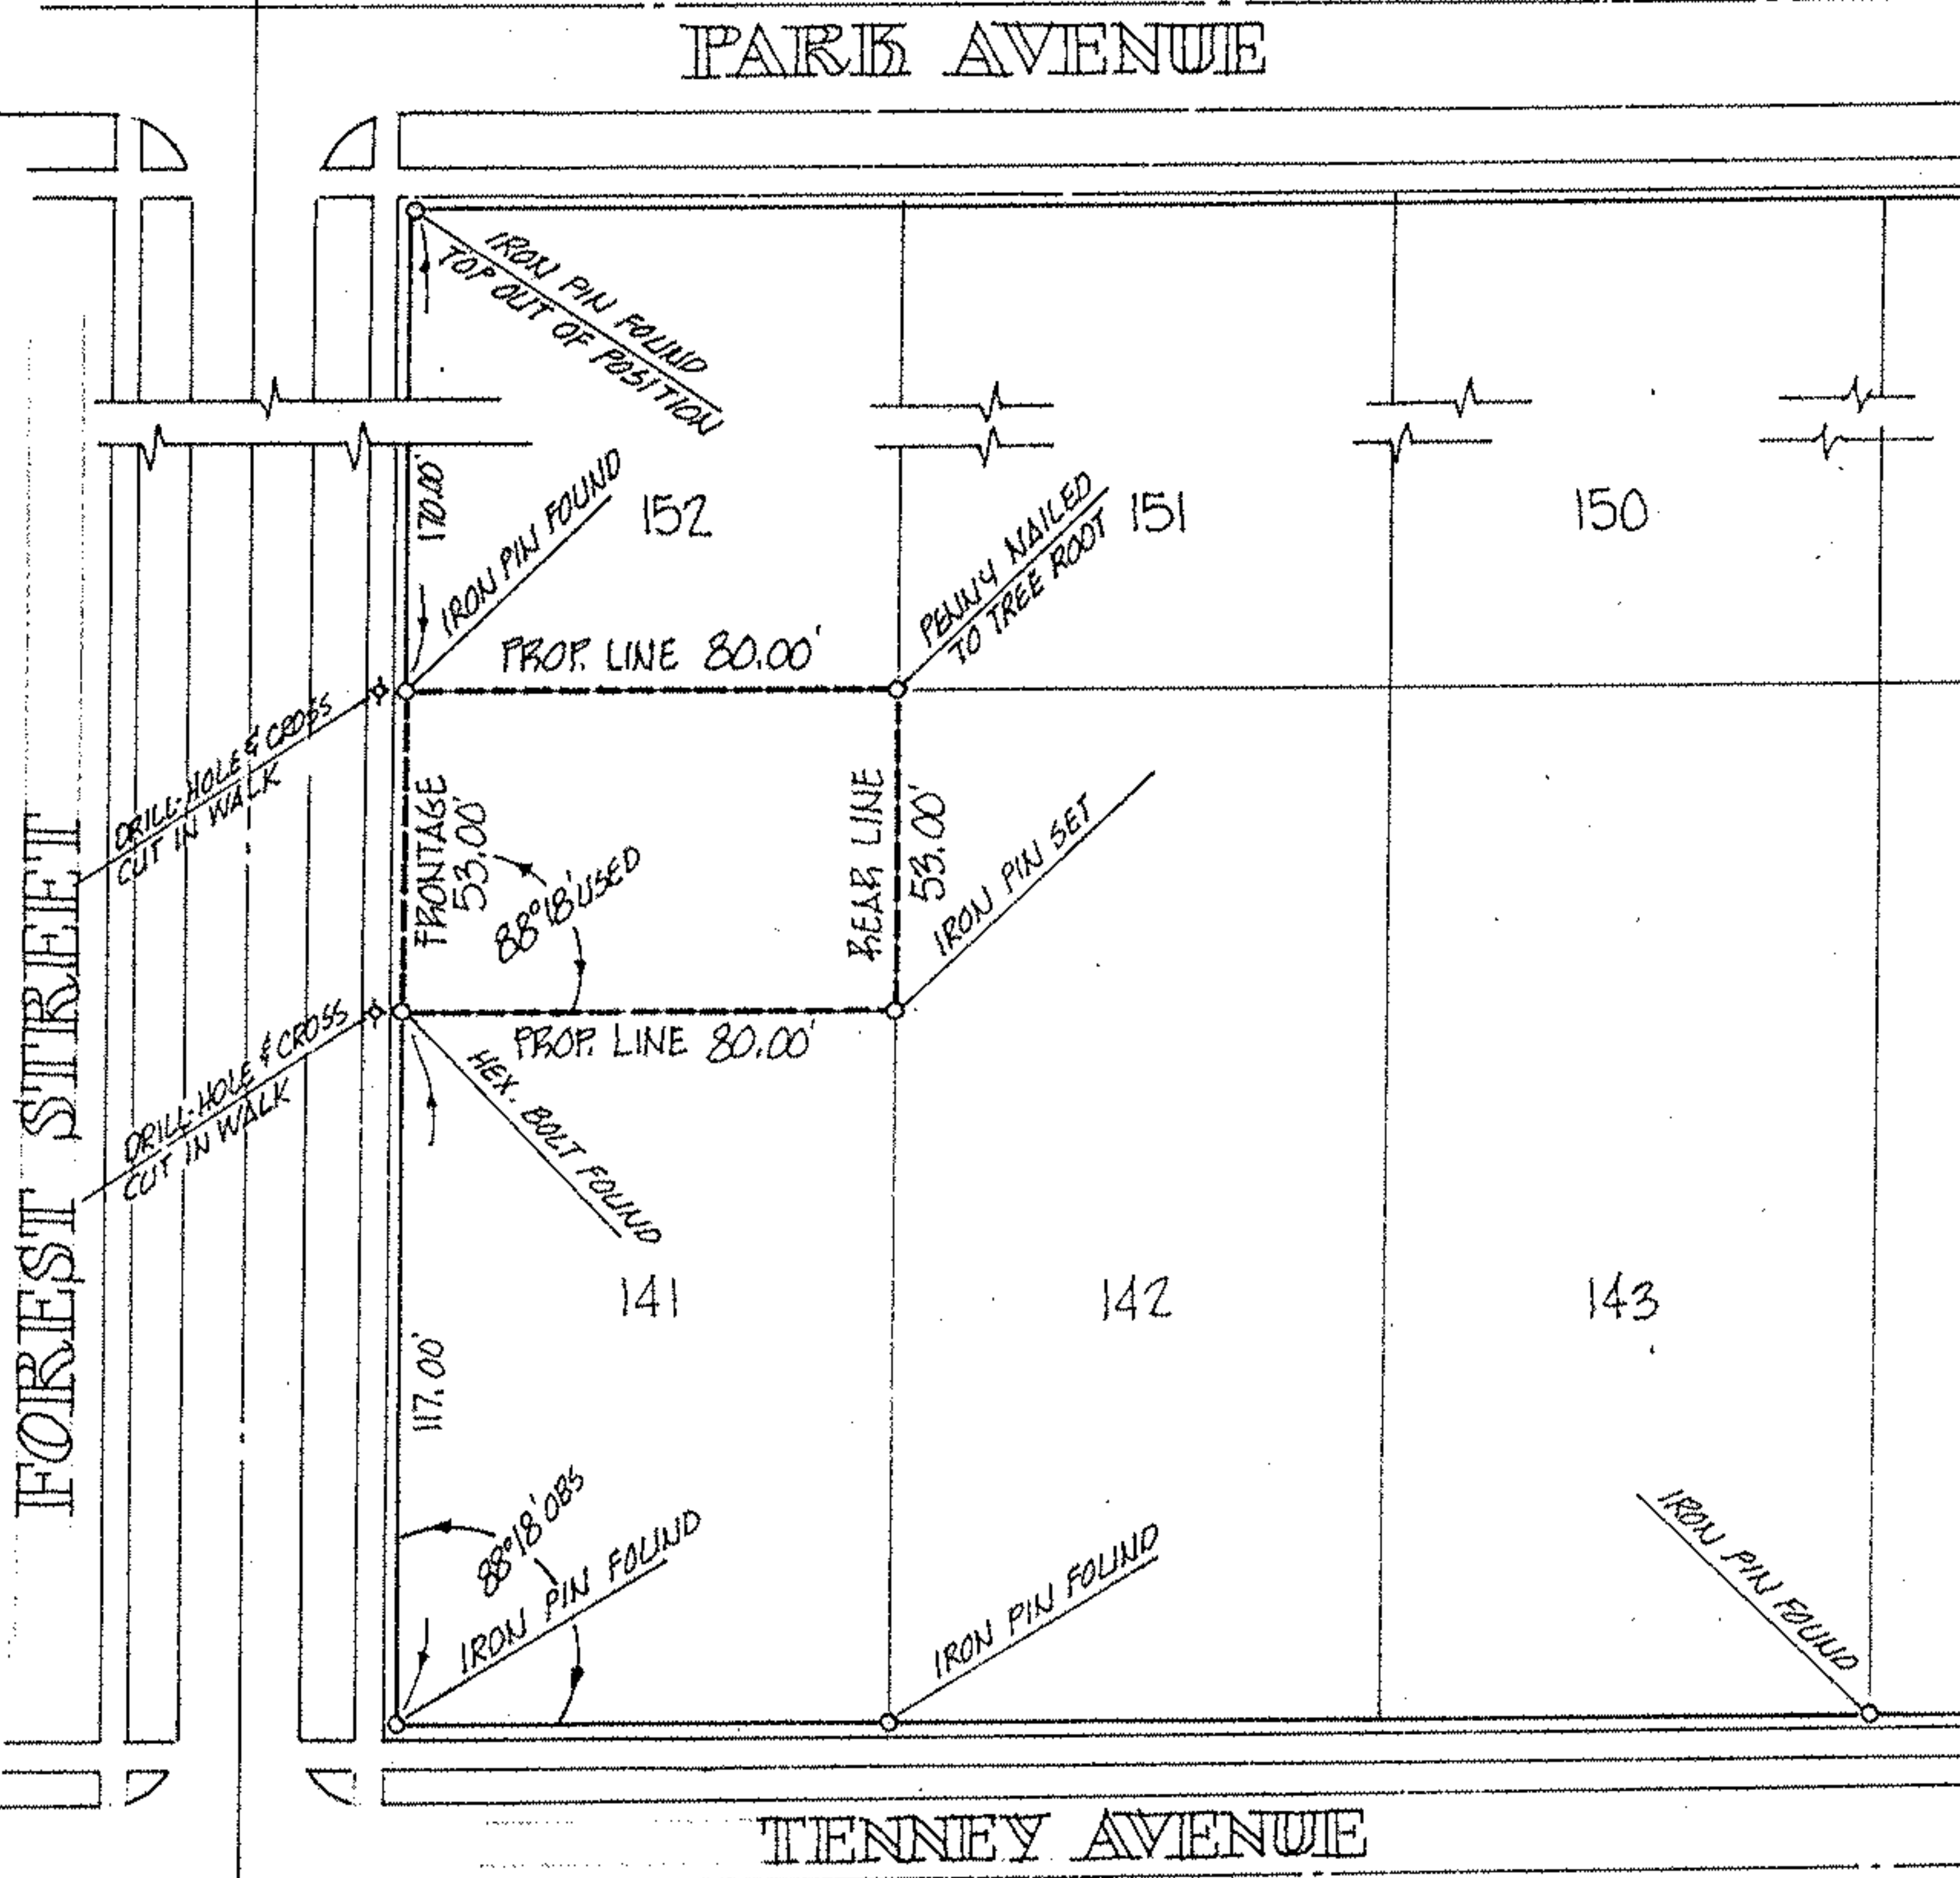


05-00-024-105-007  
3-1-80

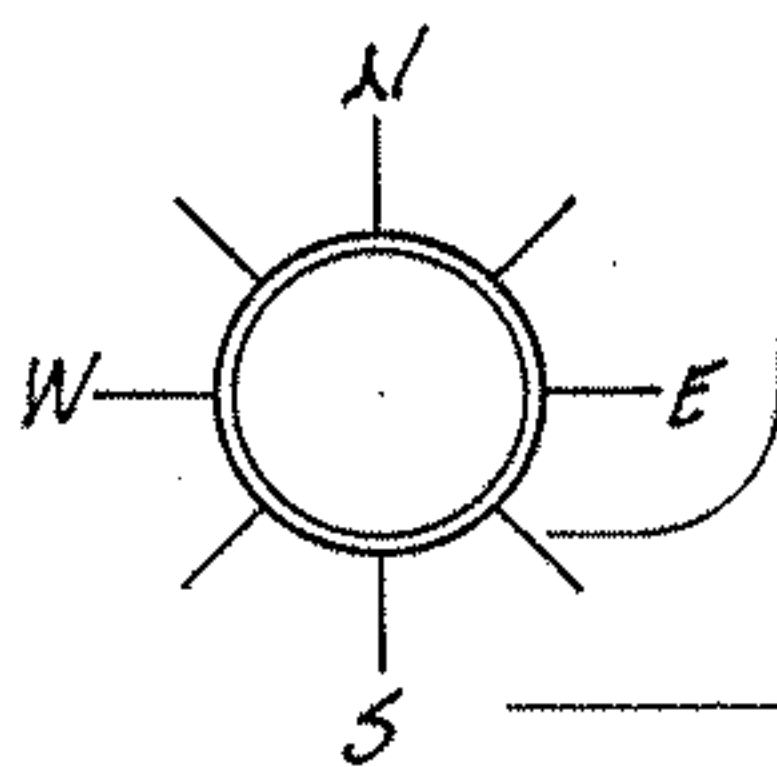

PPN 05-00-024-105-007

MAP PG 5-00-024-B  
43768

ACREAGE —	PREPARED FOR <u>MR. LARRY EVANS</u> <span style="float: right;">984-2184</span>	CITY OF AMHERST
DATE <u>07-09-86</u>	<u>275 FOREST ST., AMHERST</u>	
DRAWN <u>MGH</u>	<b>MICHAEL G. HURA, registered surveyor.</b> 12706 MASON RD., VERMILION, O., Ph (216) 965 4040	
SCALE <u>1" = 50 ft.</u>	<b>PERIMETER SURVEY</b>	
	SUBLOT(s) <u>PART OF 141</u> of <u>SEELEY'S ADDITION</u>	
	Volume <u>1</u> Page <u>37</u> of PLATS	
	PART OF O.L. _____ TRACT _____ SECTION _____ OF <u>AMHERST</u> TOWNSHIP <u>LORAIN</u> CO., OHIO	
PERMANENT PARCEL N <sup>o</sup> _____		

5-00-024-B 05-00-024-105-007