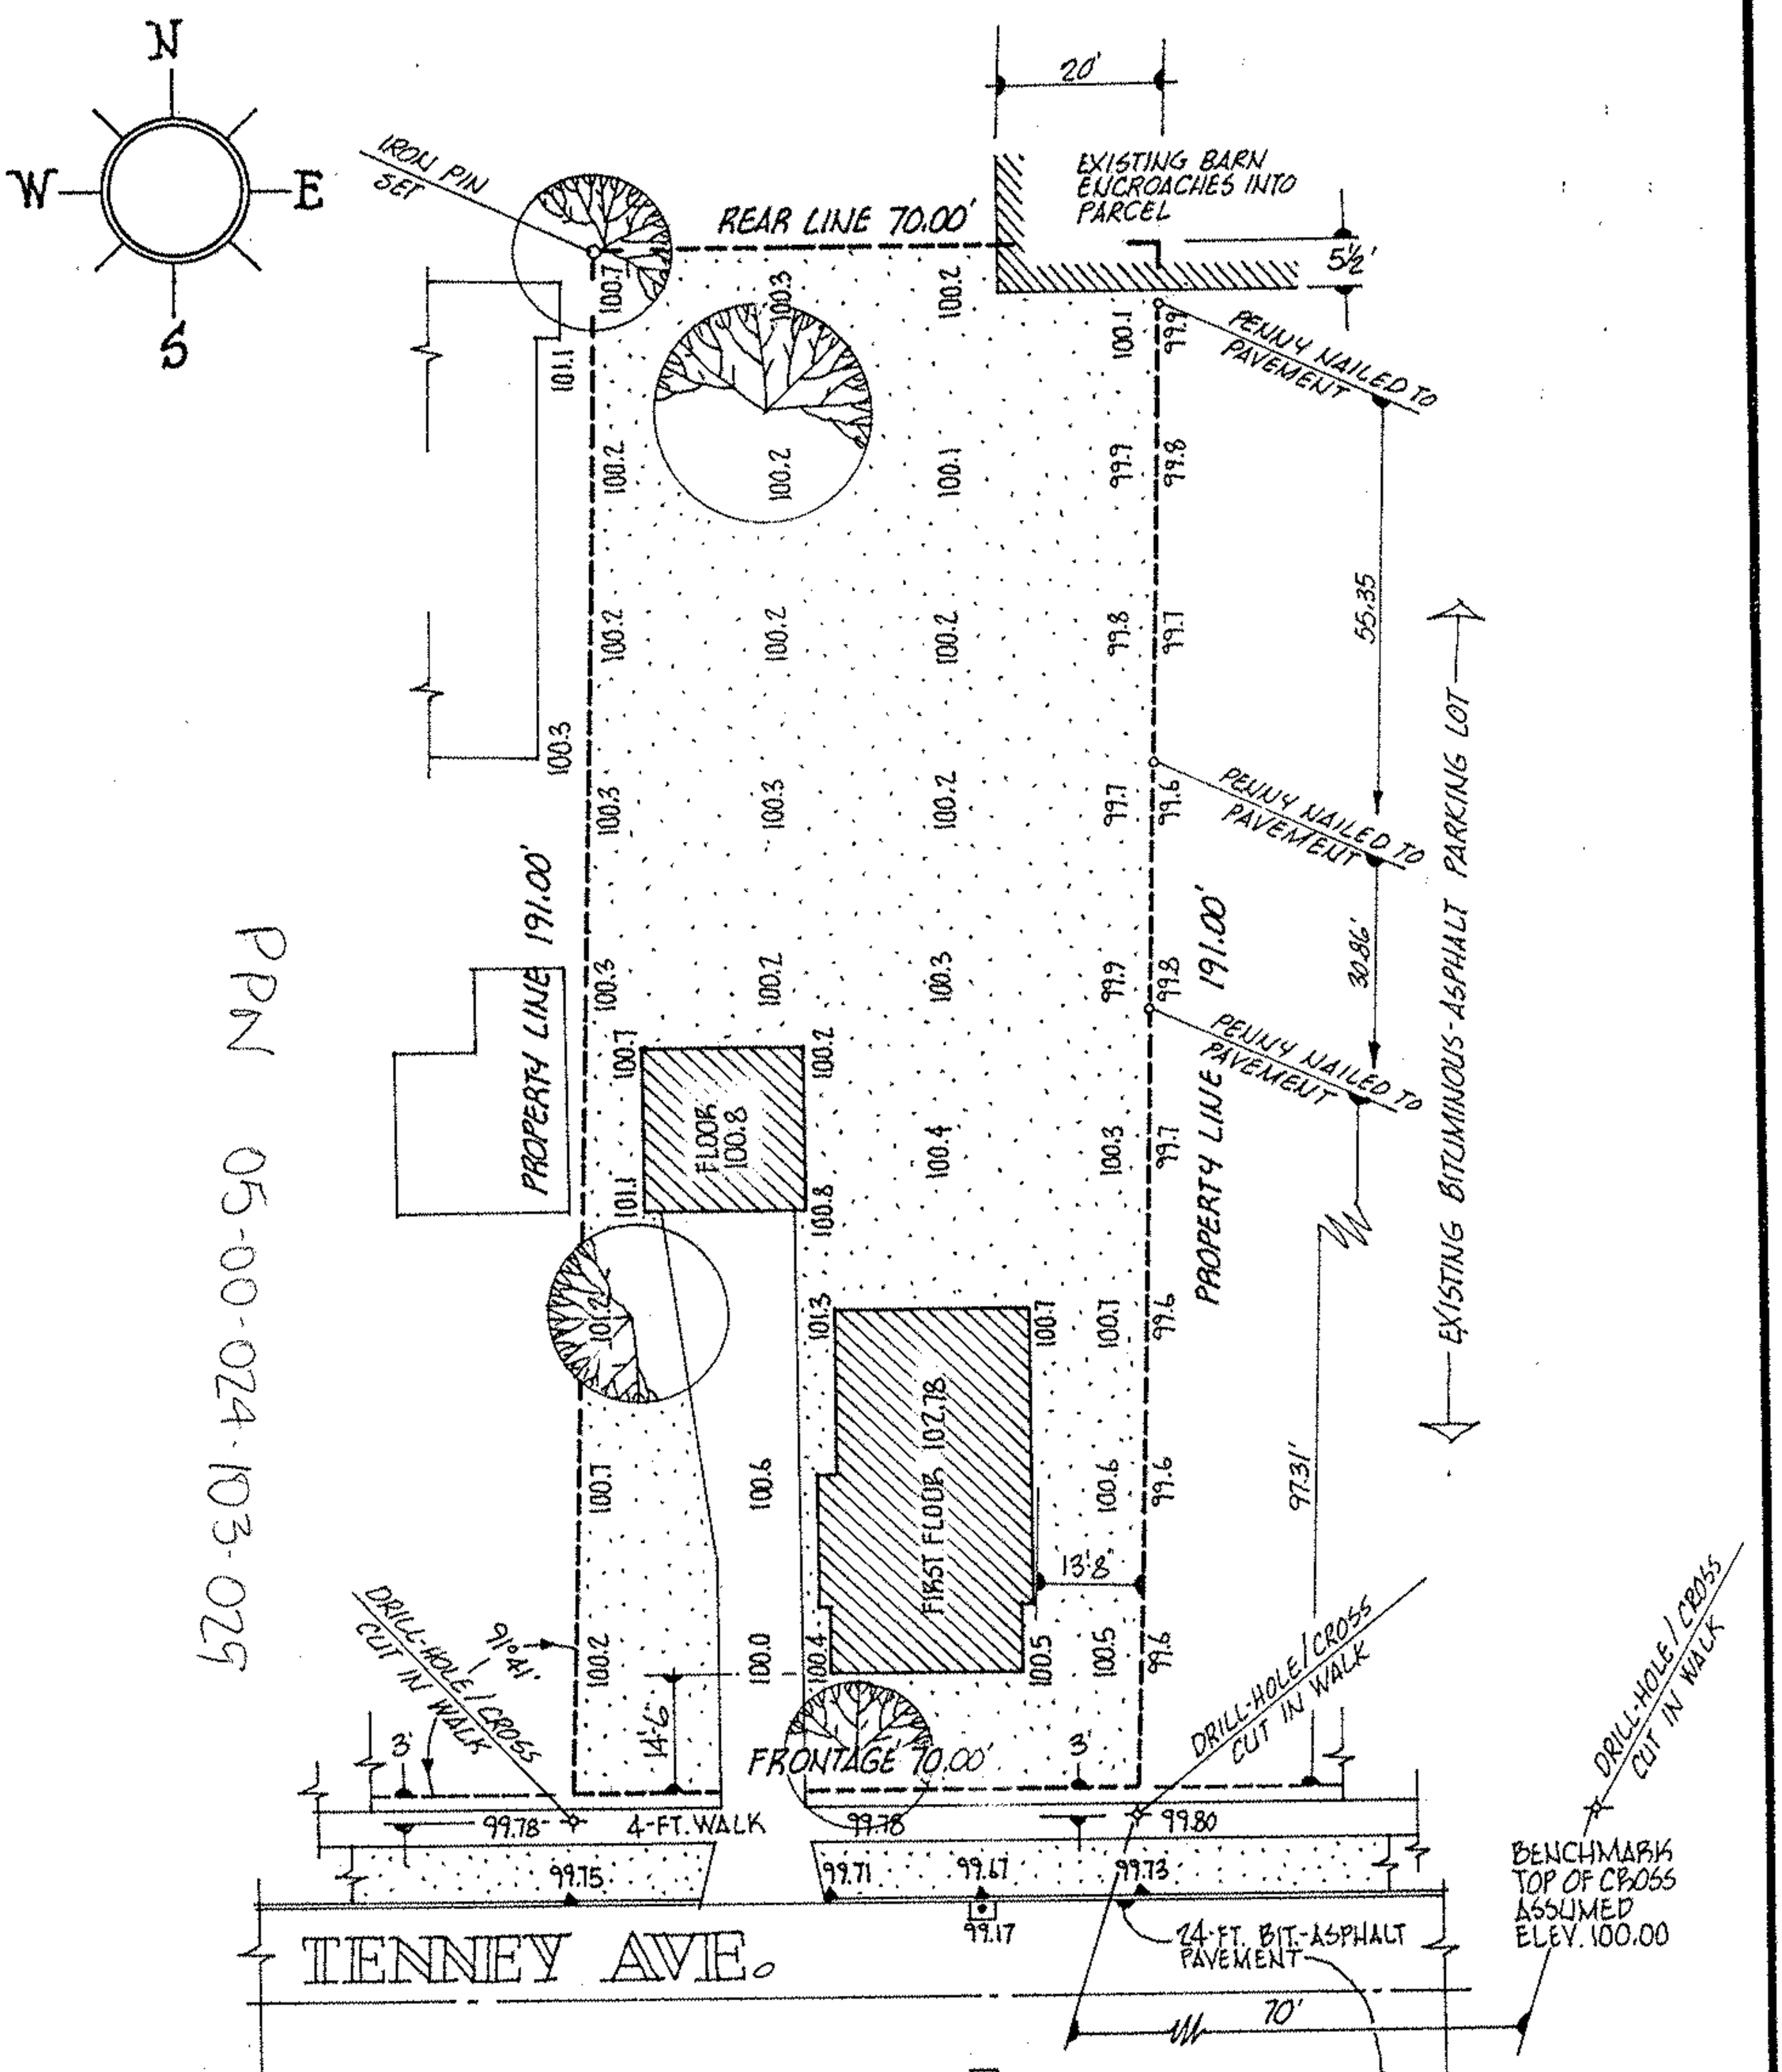

ACREAGE	
DATE	10-15-86
DRAWN	MGH
SCALE	1" = 30 ft.

STATE OF OHIO
MICHAEL G. HURA
No. 4712
REGISTERED SURVEYOR

PREPARED FOR FIOR CONSTRUCTION

MICHAEL G. HURA, registered surveyor
12706 MASON RD., VERMILION, O., Ph (216) 965 4040

PERIMETER SURVEY

SUBLOT(s) 131 of M.C. SEELEY'S ADDITION
Volume 1 Page 37 of PLATS
PART OF O.L. 24 TRACT ____ SECTION ____ OF
AMHERST TOWNSHIP LORAIN CO., OHIO
PERMANENT PARCEL Nº 5-00-024-103-029

CITY OF AMHERST

5-00-024-103-029 Old
5-00-024-103-029 New
67184