PPN 03-00-086-102-016, 019
03-00-086-101-002, 003

3-00-095-B
03-00-086-102-016, -019
03-00-086-101-002, -003

map pg 3-00-095-B
43780

INDUSTRIAL RAILROAD CO.

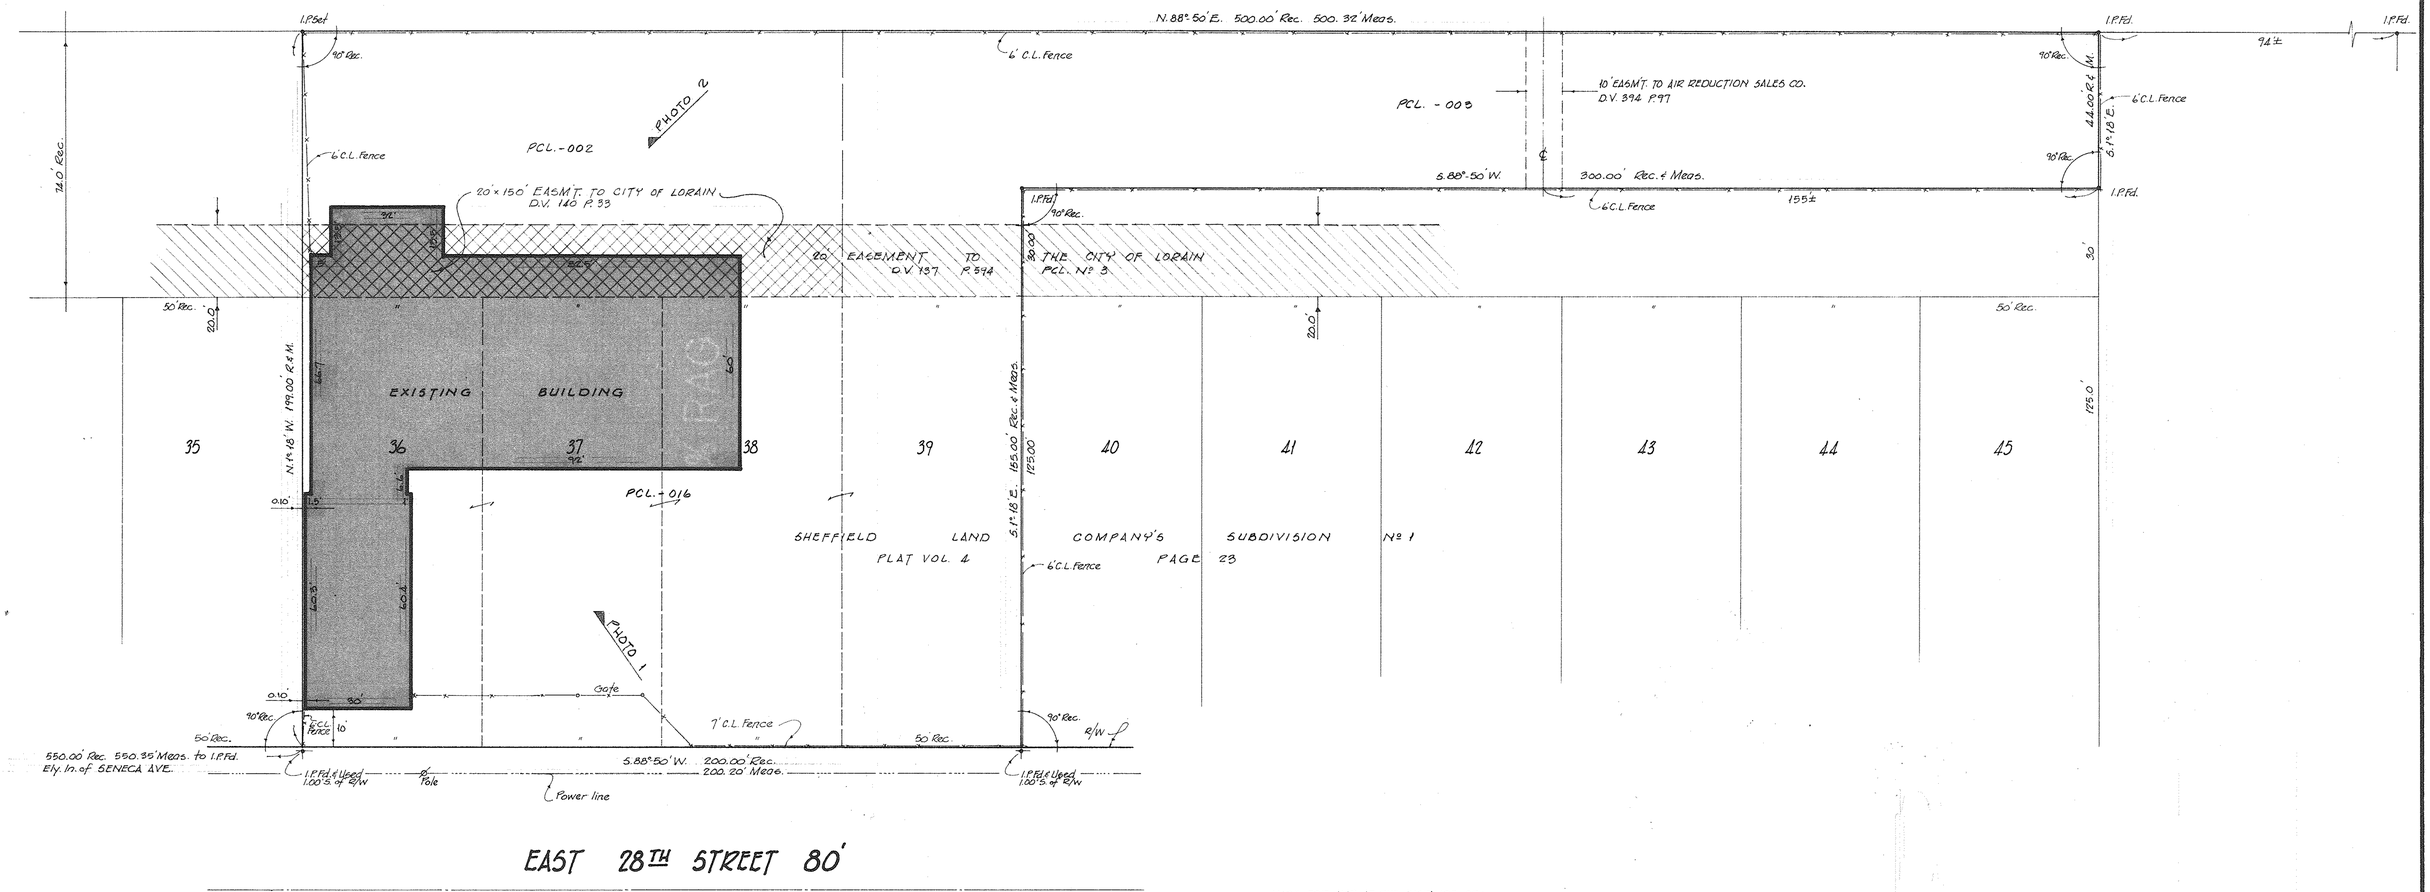

EAST 28TH STREET 80'

MADE FOR AND AT THE INSTANCE OF:

AIDIENCE EQUITIES, INC.
WESTINGHOUSE CREDIT CORPORATION
CHICAGO TITLE AGENCY OF LORAIN COUNTY

THIS IS TO CERTIFY THAT THIS MAP AND THE SURVEY ON WHICH IT IS BASED WERE MADE IN ACCORDANCE WITH THE "MINIMUM STANDARD DETAIL REQUIREMENTS FOR LAND TITLE SURVEYS" JOINTLY ESTABLISHED AND ADOPTED BY ALTA AND ACSM IN 1986, AND MEETS THE ACCURACY REQUIREMENTS OF A "CLASS A" SURVEY, AS DEFINED THEREIN.

Rodger G. Simon

RODGER G. SIMON
REG. SURVEYOR OHIO Nº 5101

STATE OF OHIO
RODGER G. SIMON
5101
REGISTERED SURVEYOR

SURVEY OF

PART OF ORIGINAL SHEFFIELD TOWNSHIP LOT Nº 86

AND

S/L's 36, 37, 38 & 39 IN SHEFFIELD LAND COMPANY'S SUBDIVISION Nº 1

CITY OF LORAIN COUNTY OF LORAIN STATE OF OHIO

SCALE 1" = 20' DECEMBER 30, 1987

LAUNDON • SIMON • CAHL & ASSOC. INC.
ENGINEERS SURVEYORS
219 COURT ST. ELYRIA, OHIO 44035
(216) 322-7623

JOB Nº 87-1673

225