PPN 04-00-010-113-034

4-00-010-F -010-E
04-00-010-113-034

MAP 15 04-00-010-F,E
43786

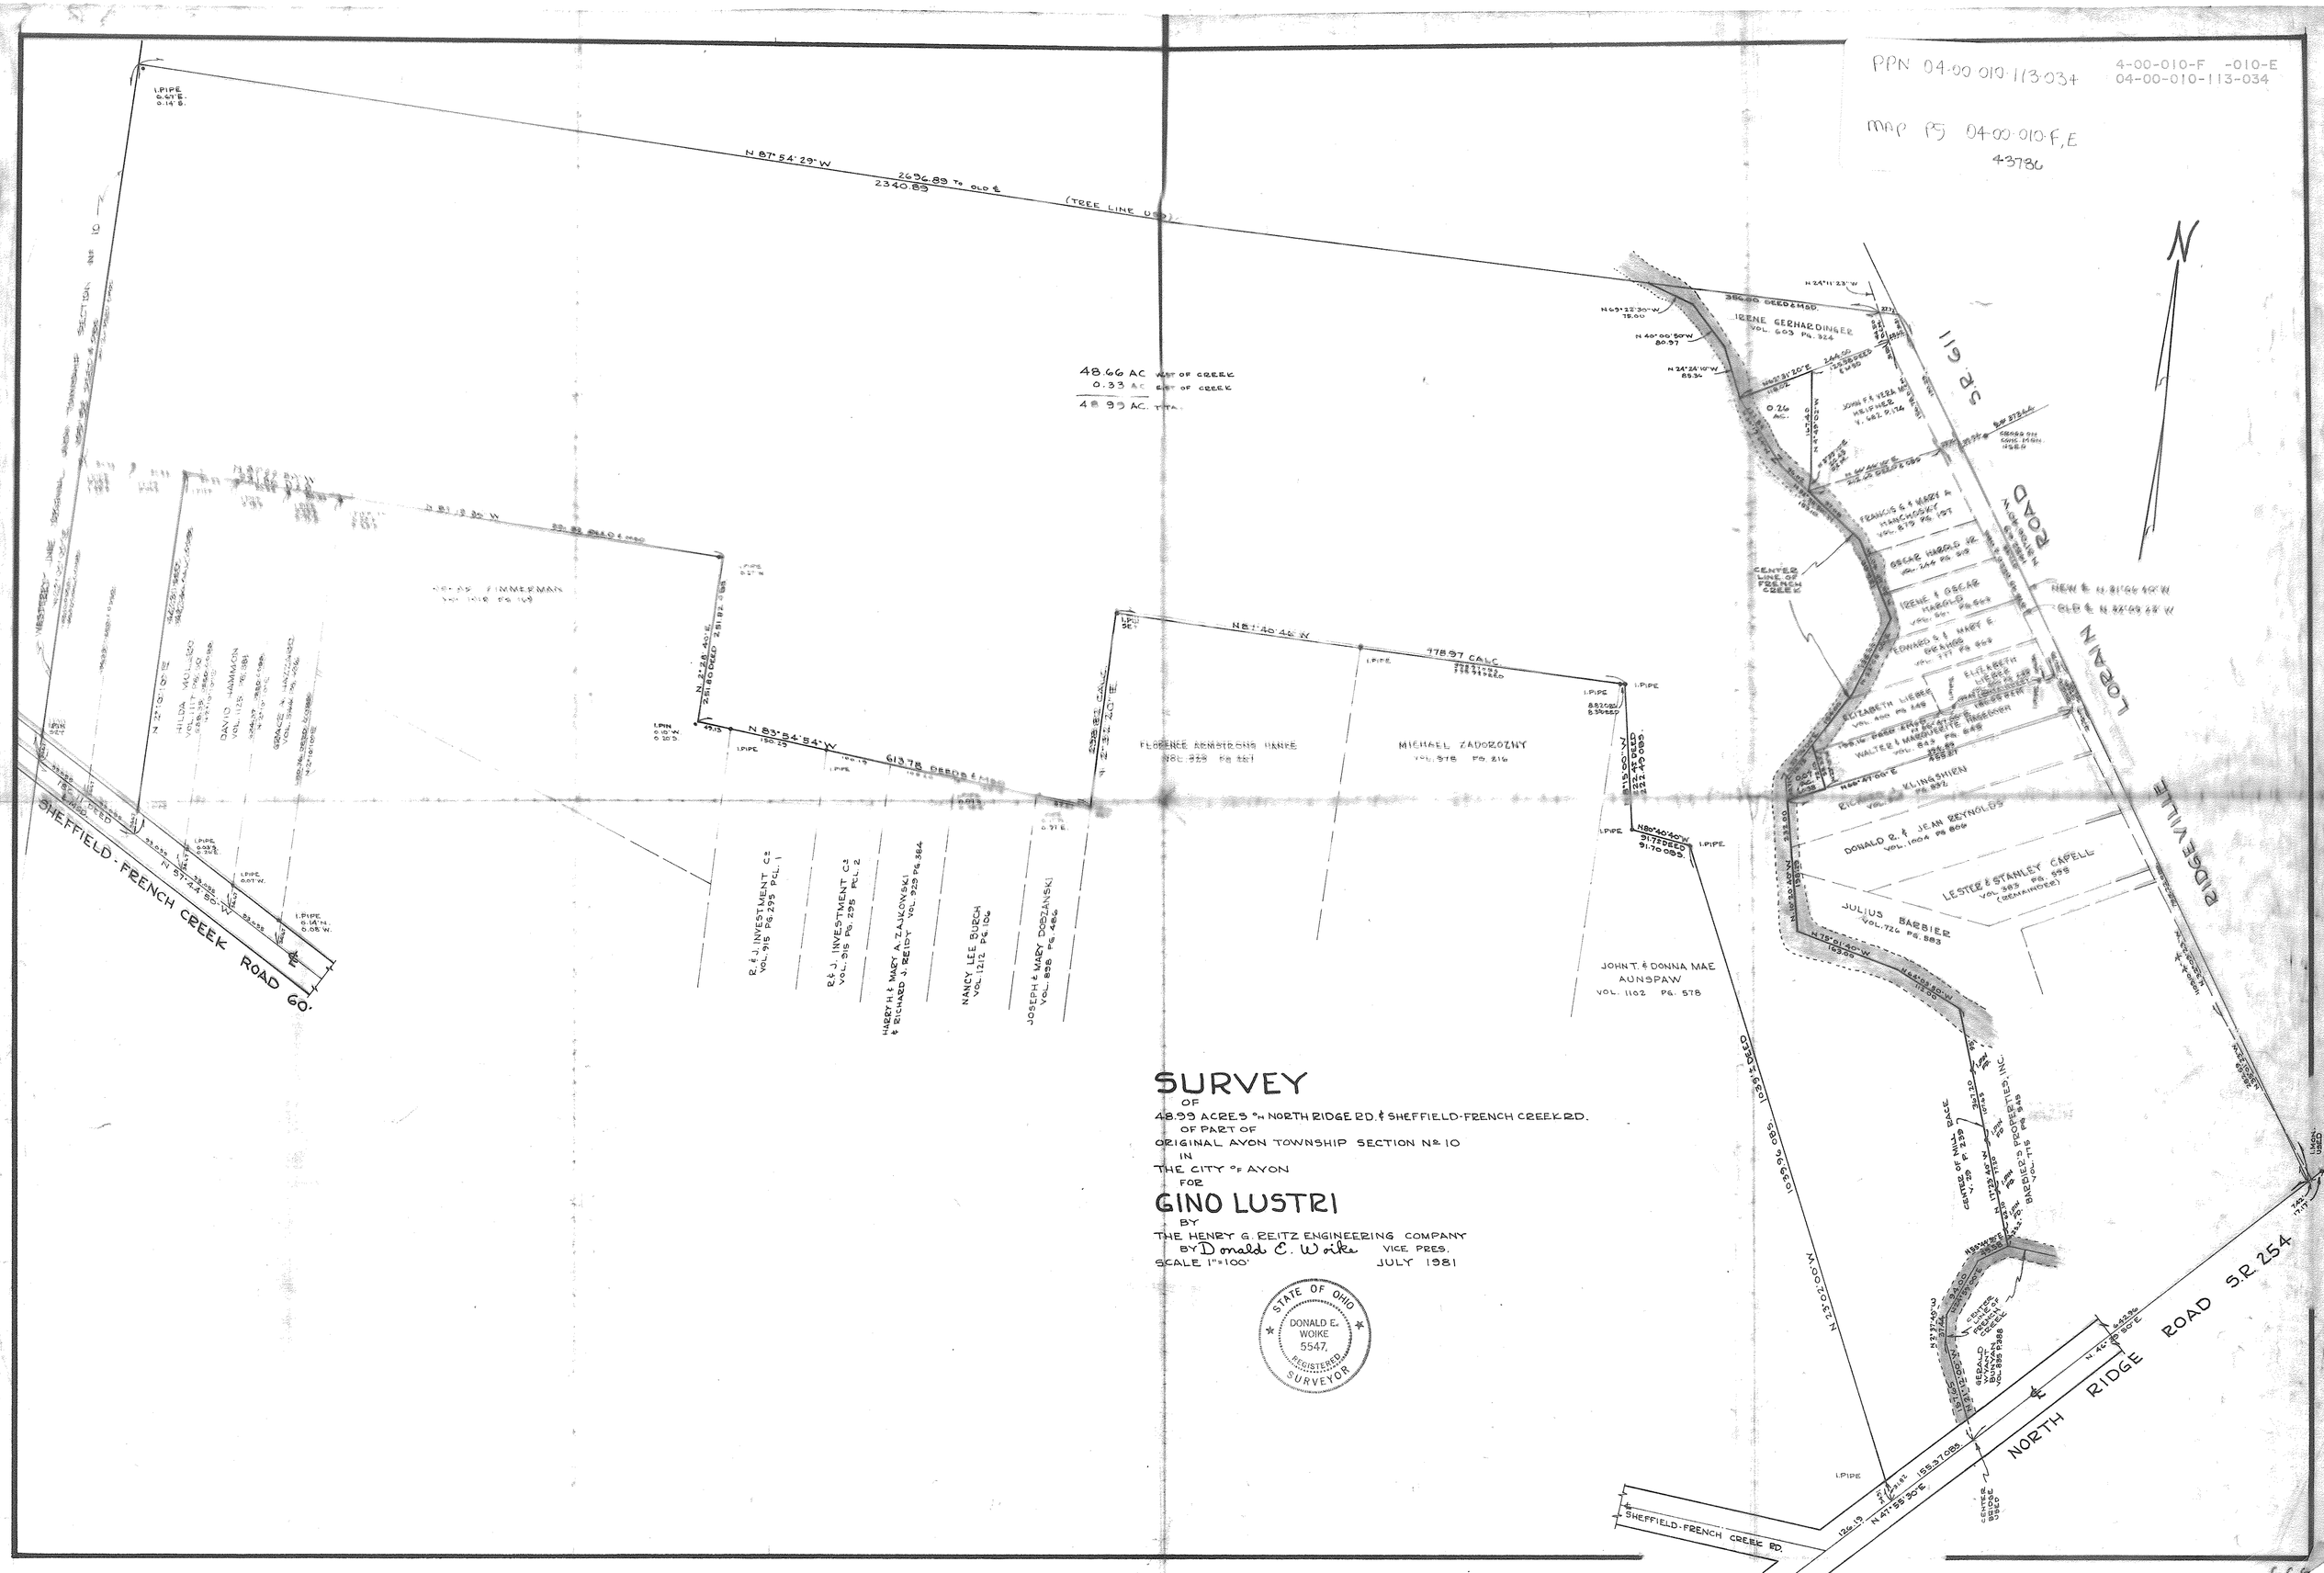

SURVEY

OF

48.99 ACRES on NORTH RIDGE RD. & SHEFFIELD-FRENCH CREEK RD.

OF PART OF

ORIGINAL AVON TOWNSHIP SECTION No. 10

IN

THE CITY OF AVON

FOR

GINO LUSTRI

BY

THE HENRY G. REITZ ENGINEERING COMPANY

BY Donald E. Woike VICE PRES.

SCALE 1" = 100' JULY 1981

STATE OF OHIO
DONALD E. WOIKE
5547
REGISTERED
SURVEYOR