3-00-106-A
3-00-106-B
3-00-107-B
3-00-111-A
3-00-111-B
3-00-112 B

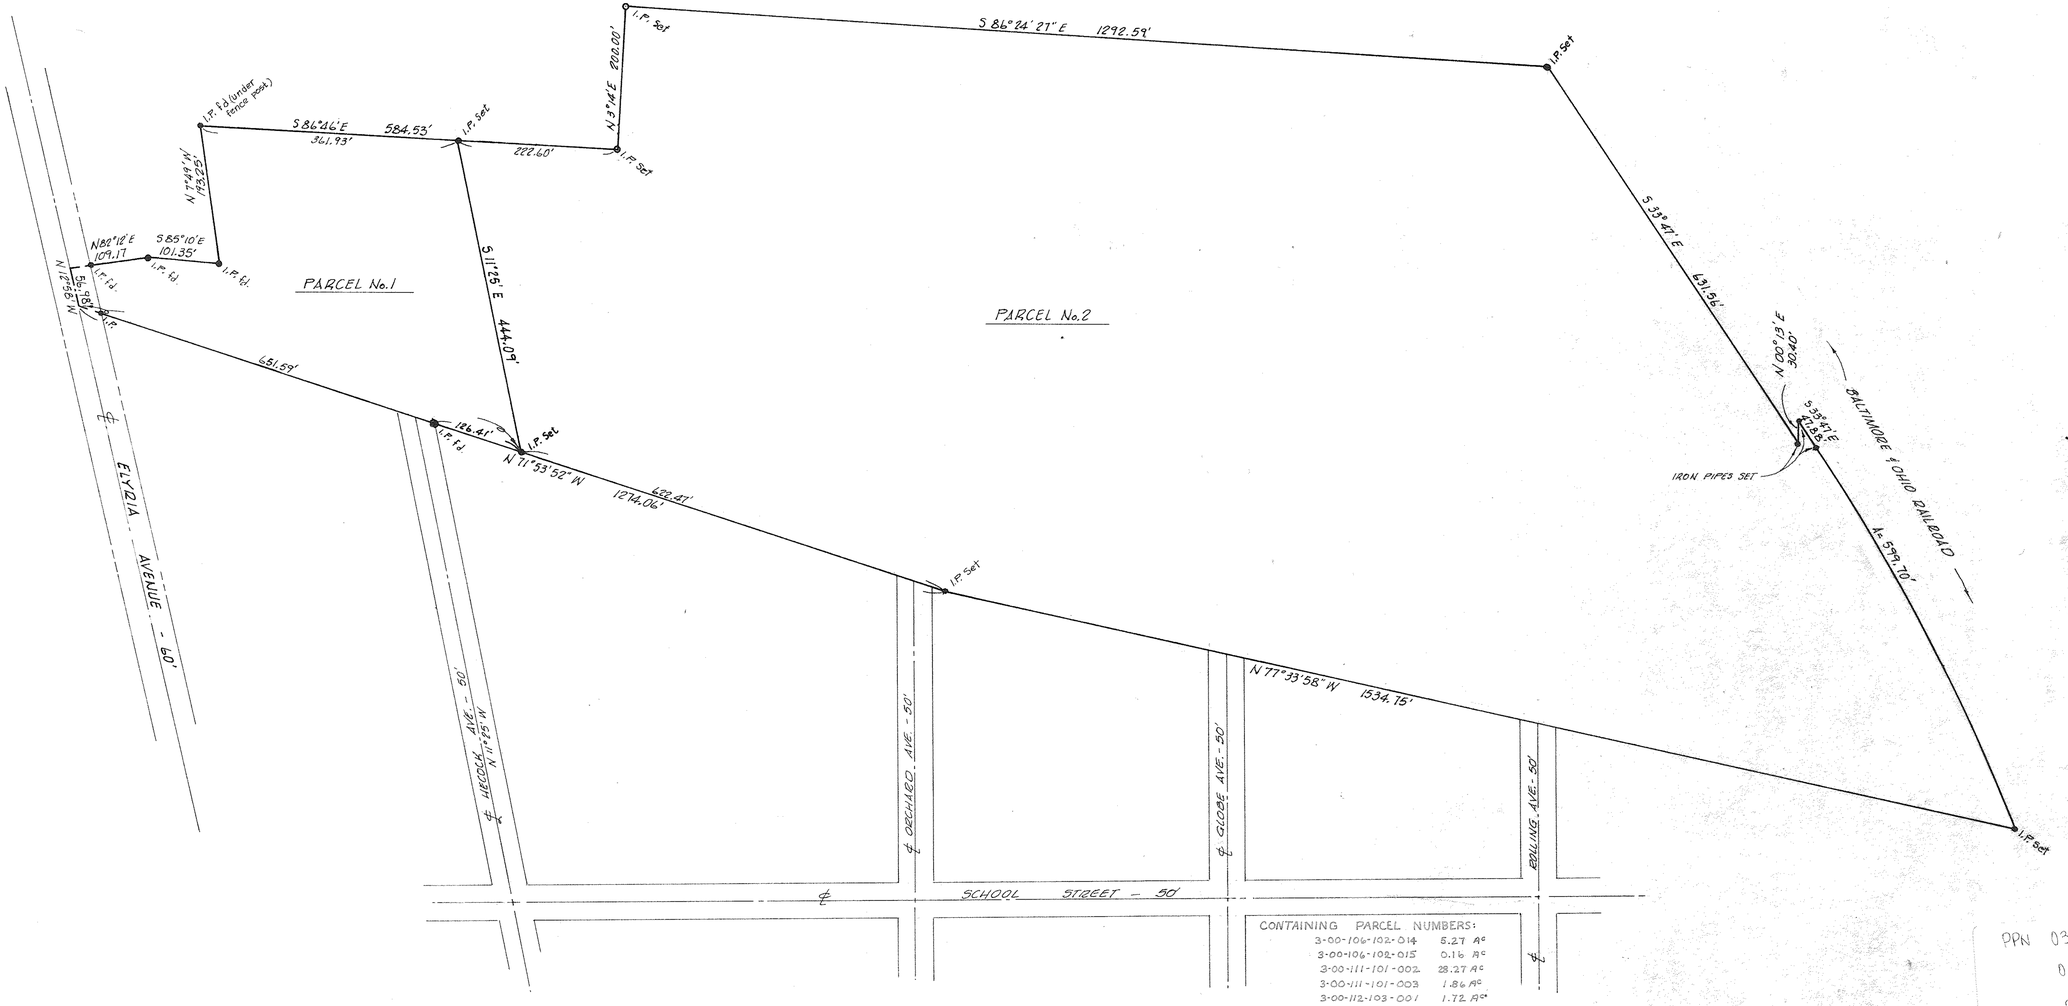

CONTAINING PARCEL NUMBERS:

3-00-106-102-014	5.27 Ac
3-00-106-102-015	0.16 Ac
3-00-111-101-002	28.27 Ac
3-00-111-101-003	1.86 Ac
3-00-112-103-001	1.72 Ac

PPN 03-00-106-102-014 #3790
015
03-00-111-101 002
003
03-00-112-103-001
MAP BY 03-00-106-A,B 03-00-107-B 03-00-111-A,B 03-00-112 B

MAP of SURVEY
for
ANNA WOSKOBNICK
PART of ORIGINAL LOTS Nos. 106, 107, 111 and 112
SHEFFIELD TOWNSHIP, LORAIN COUNTY, OHIO

3-00-106-A
3-00-106-B
3-00-107-B
3-00-111-A
3-00-111-B 3-00-112-B

STATE OF OHIO LAWRENCE V. McGLINCHY 4970 REGISTERED SURVEYOR

McGLINCHY and ASSOCIATES
REGISTERED ENGINEERS and SURVEYORS
ELYRIA OHIO
JUNE 30, 1977 JOB # 772100
REV. 7-21-77