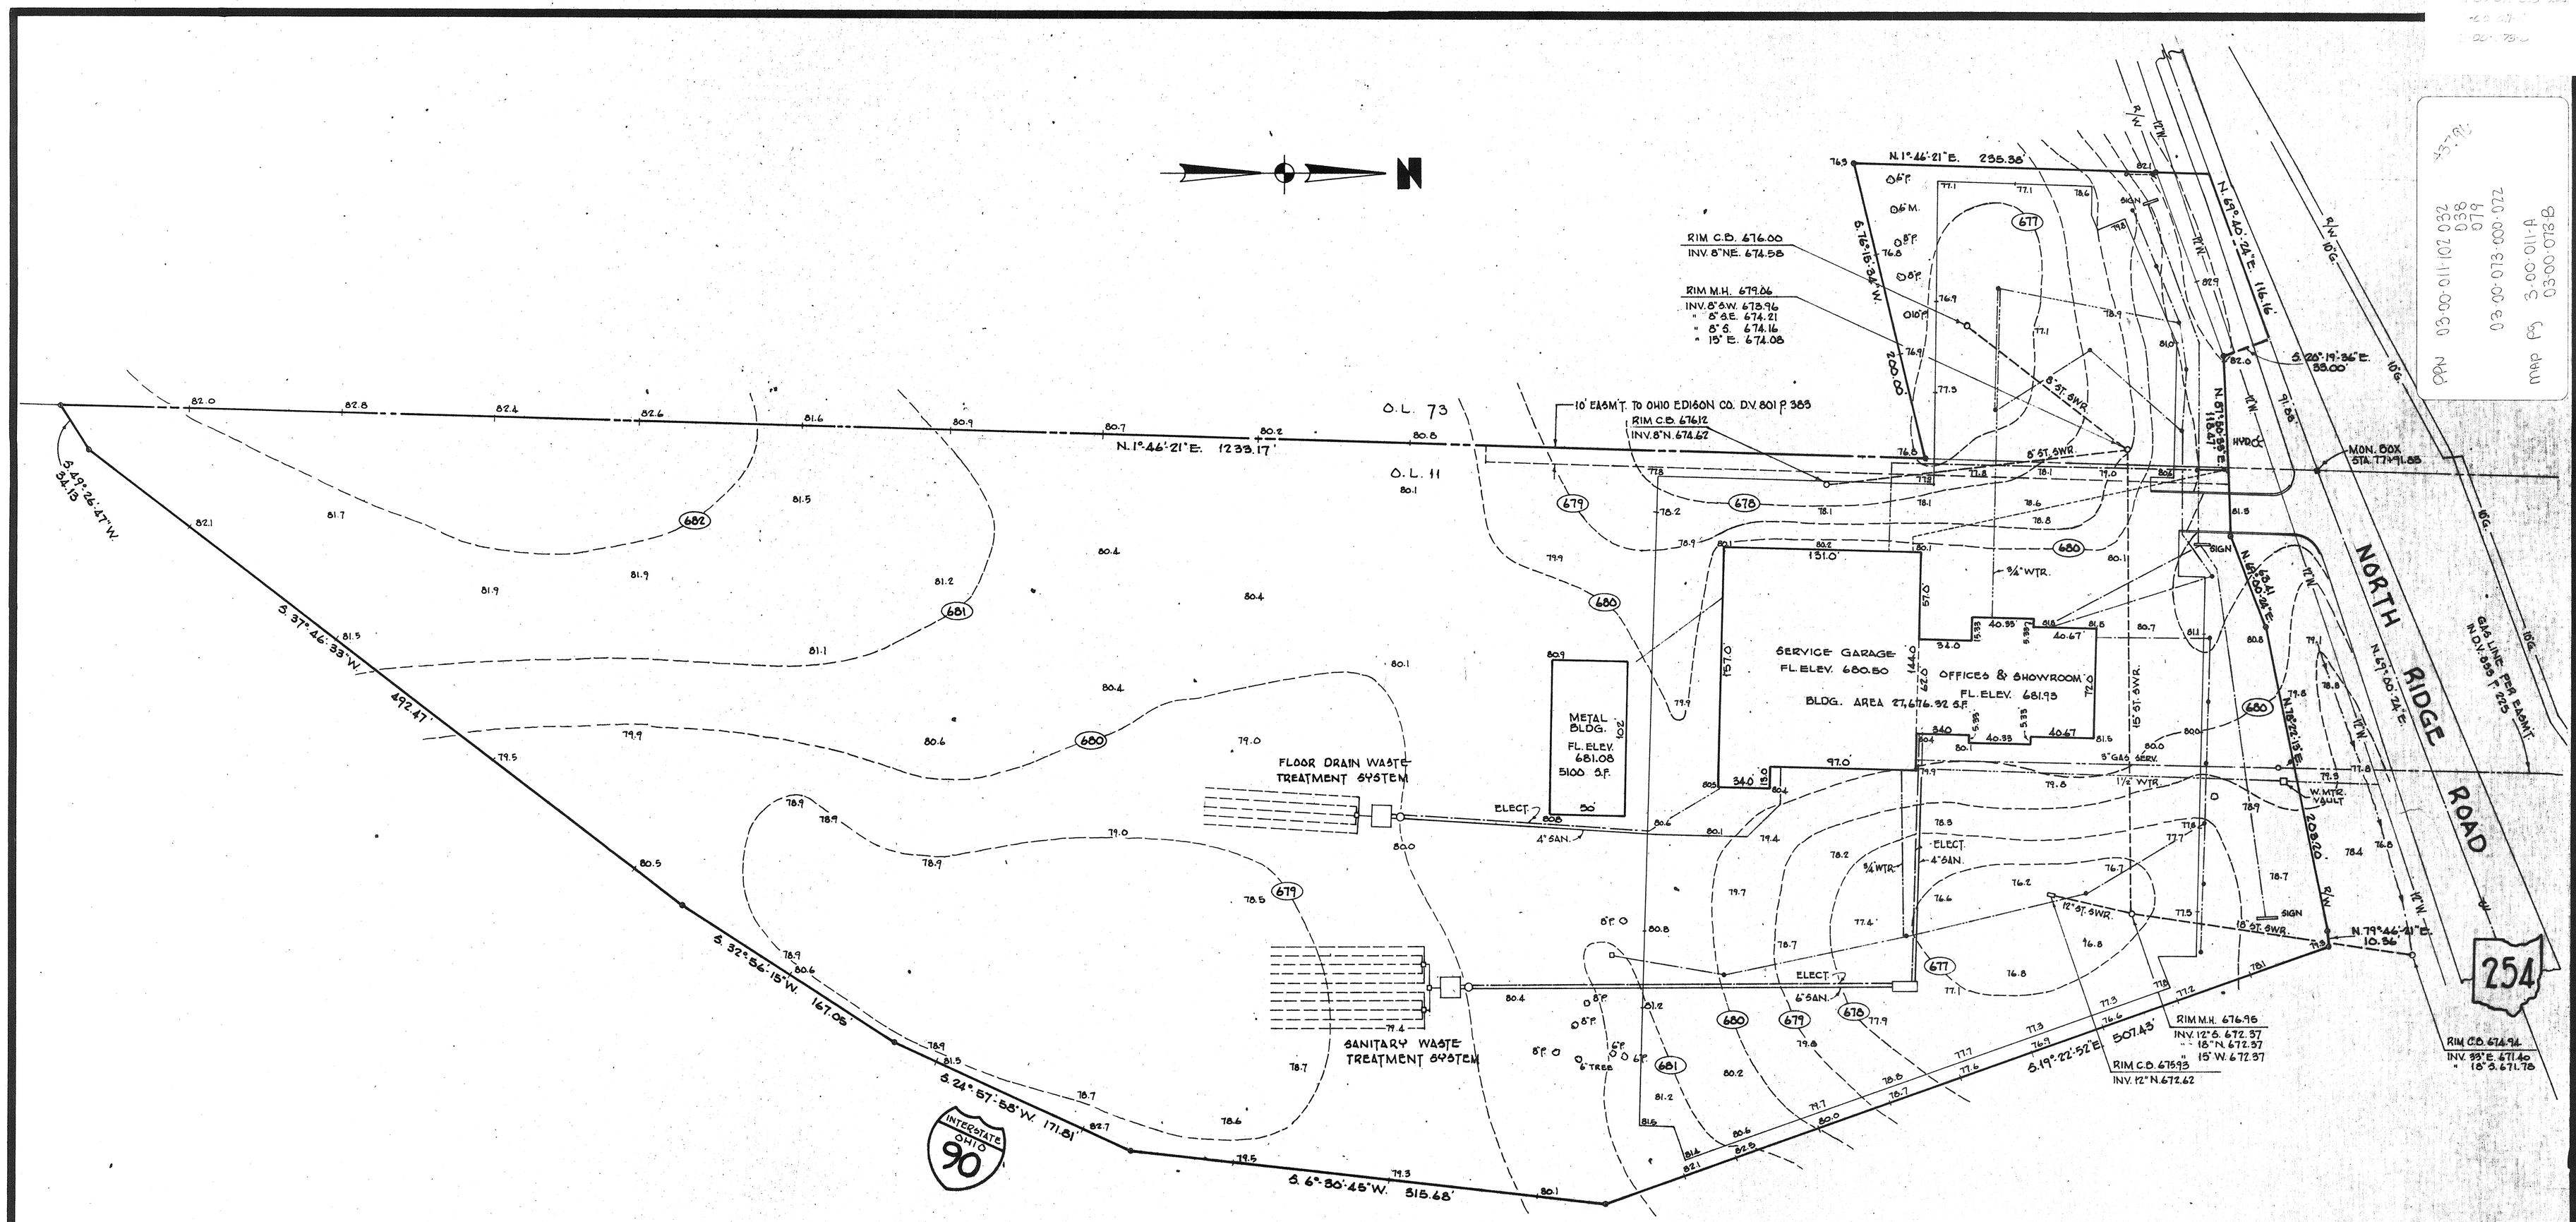

NOTE:
ADD 600.0 TO ELEVATIONS SHOWN FOR U.S.G.S. DATUM.

⊕ DENOTES IRON PIN SET IN 4" CLAY FIELD TILE FILLED WITH CONCRETE.

- STORM SEWER
- UNDER GROUND ELECTRIC
- GAS LINE
- WATER SERVICES
- UNDER GROUND TELEPHONE
- SANITARY SEWER

THIS IS TO CERTIFY THAT WE HAVE SURVEYED THE 12.9081 ACRE PARCEL AND LOCATED THE BUILDINGS AND IMPROVEMENTS HEREON. ALL MEASUREMENTS SHOWN ARE IN FEET AND DECIMAL PARTS THEREOF. BEARINGS SHOWN ARE ASSUMED AND USED TO DESCRIBE ANGLES ONLY, ALL OF WHICH WE CERTIFY TO BE CORRECT.

BY Rodger G. Simon
RODGER G. SIMON
REG. SURVEYOR Nº 5101

STATE OF OHIO
RODGER G. SIMON
5101
REGISTERED SURVEYOR

FINAL SURVEY FOR

FORD LEASING DEVELOPMENT COMPANY

PART OF ORIGINAL SHEFFIELD TOWNSHIP LOTS 11 and 73 — VILLAGE OF SHEFFIELD
COUNTY OF LORAIN — STATE OF OHIO

SCALE 1" = 50' — JUNE, 1980

LAUNDON · SIMON · CAHL & ASSOC. ENGINEERS & SURVEYORS
504 MIDDLE AVE. ELYRIA, OHIO 44035 (216) 322-7625

79-913

126