4-00-011-107-112
4-00-011-E

PPN 04-00-011-107 111
112

Map Pg 4-00-011 E
43800

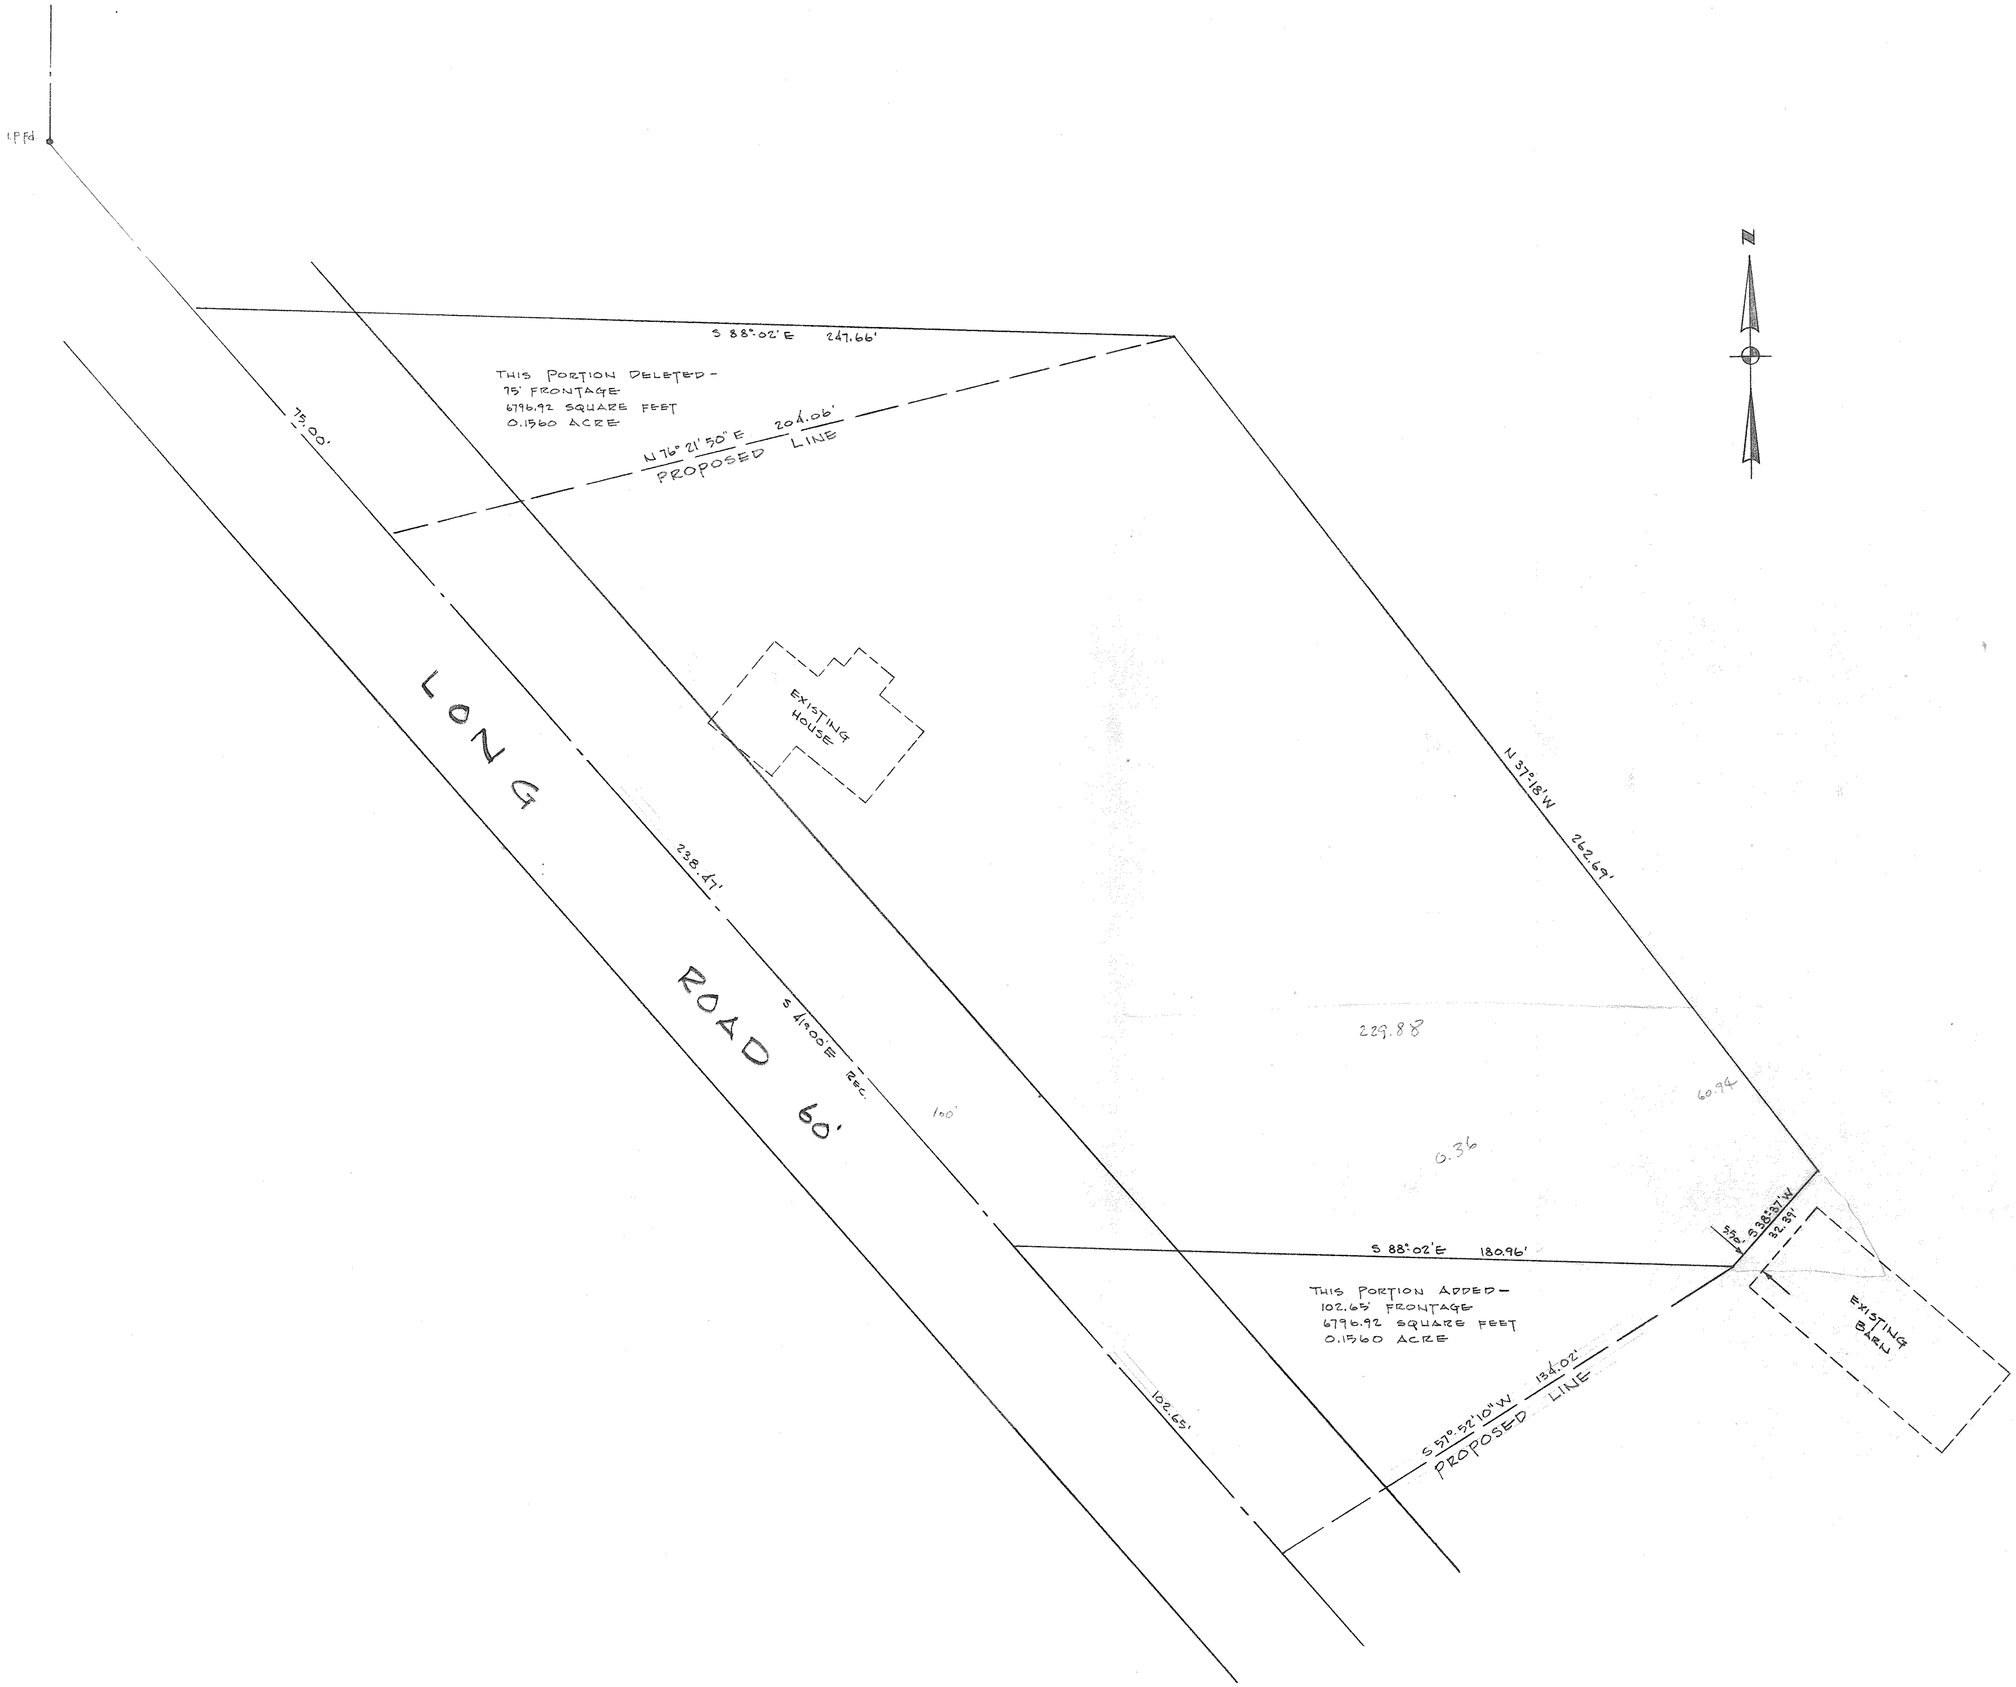

SKETCH FOR

JIMMY MARSIGLIA

SEC. 11 AVON TWP. LORAIN COUNTY OHIO

SCALE 1" = 20' MAR. 1978

LAUNDON · SIMON · CAHL & ASSOC.
ENGINEERS · SURVEYORS
504 MIDDLE AVE.
ELYRIA, O. 44035

Job No. 77-657
F.B. 120 P. 63