04-00-011-101
4-00-011-A

PPN 04 00 011 101 000

MAP 13 4 00 011A
12305

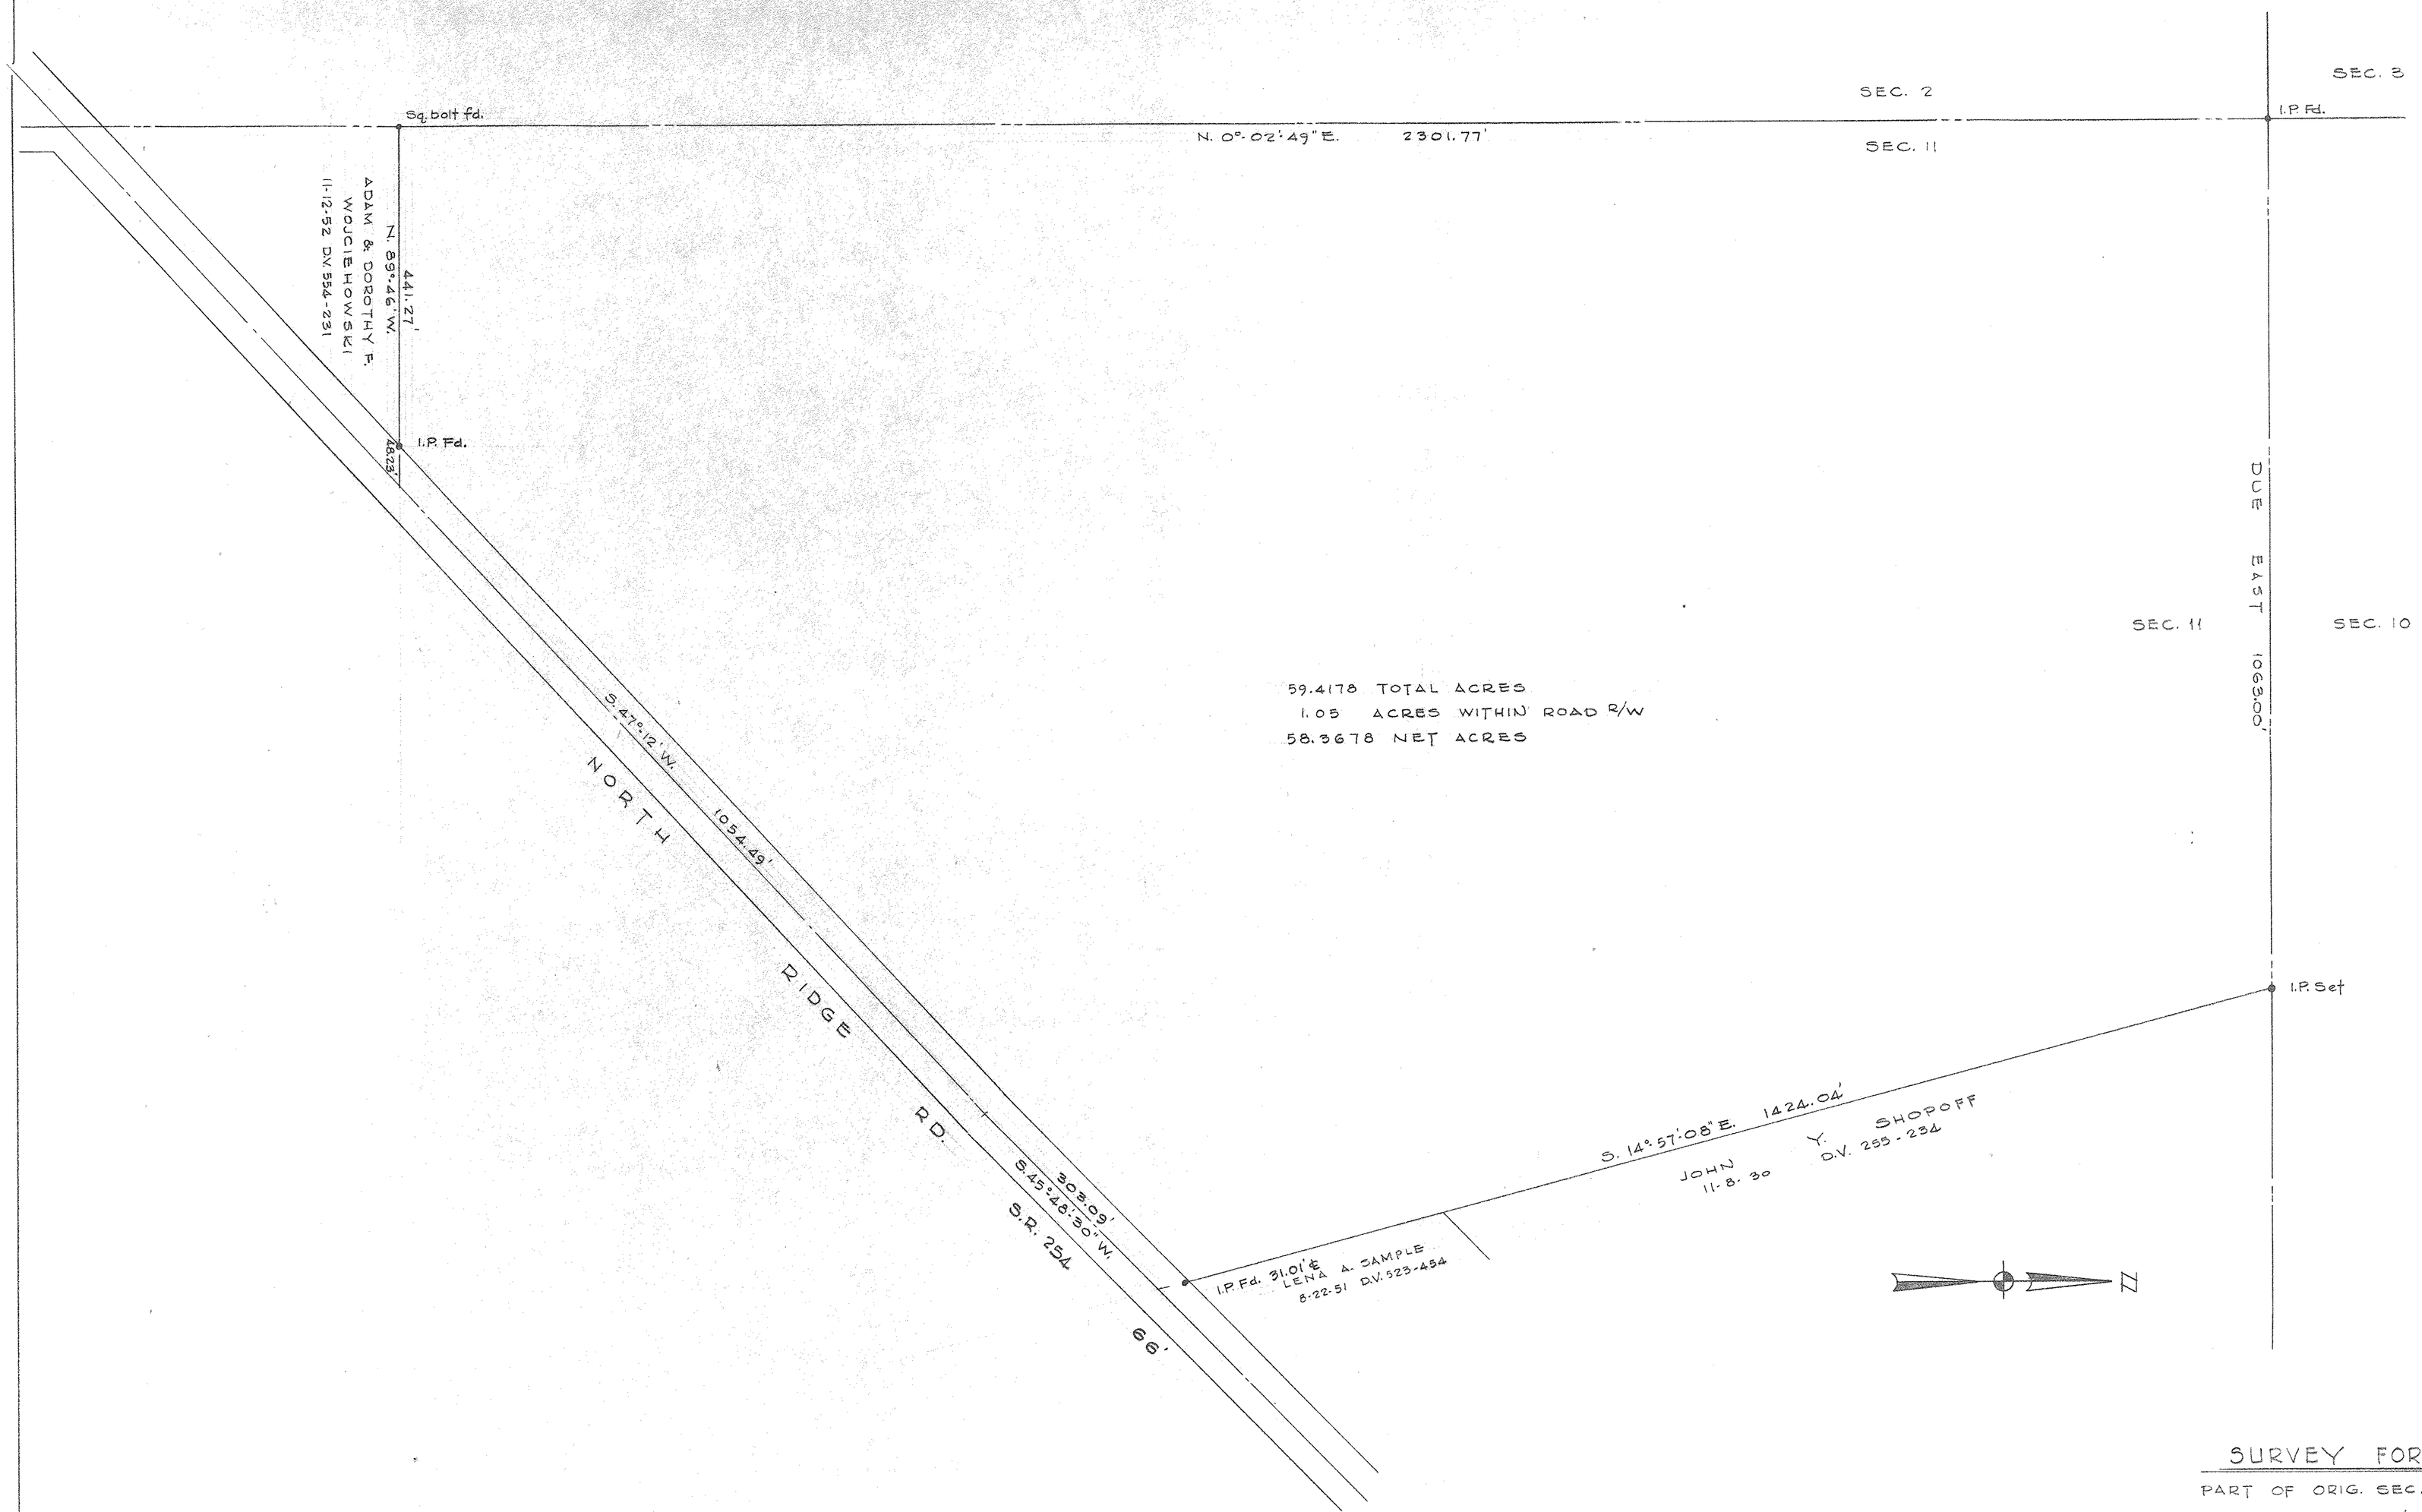

SURVEY FOR ROY S. CAHOON

PART OF ORIG. SEC. 11 — AVON TWP.
LORAIN COUNTY — OHIO
SCALE 1" = 100' — JULY, 1974
LAUNDON · SIMON · CAHL & ASSOC.
ENGINEERS — SURVEYORS

Job 74-311