map pg 6-11
43811

TOTAL AREA = ~~24.44867~~	ACRES
TAKE AREA = 20.30887	ACRES
REMAINDER = 04.13974	ACRES

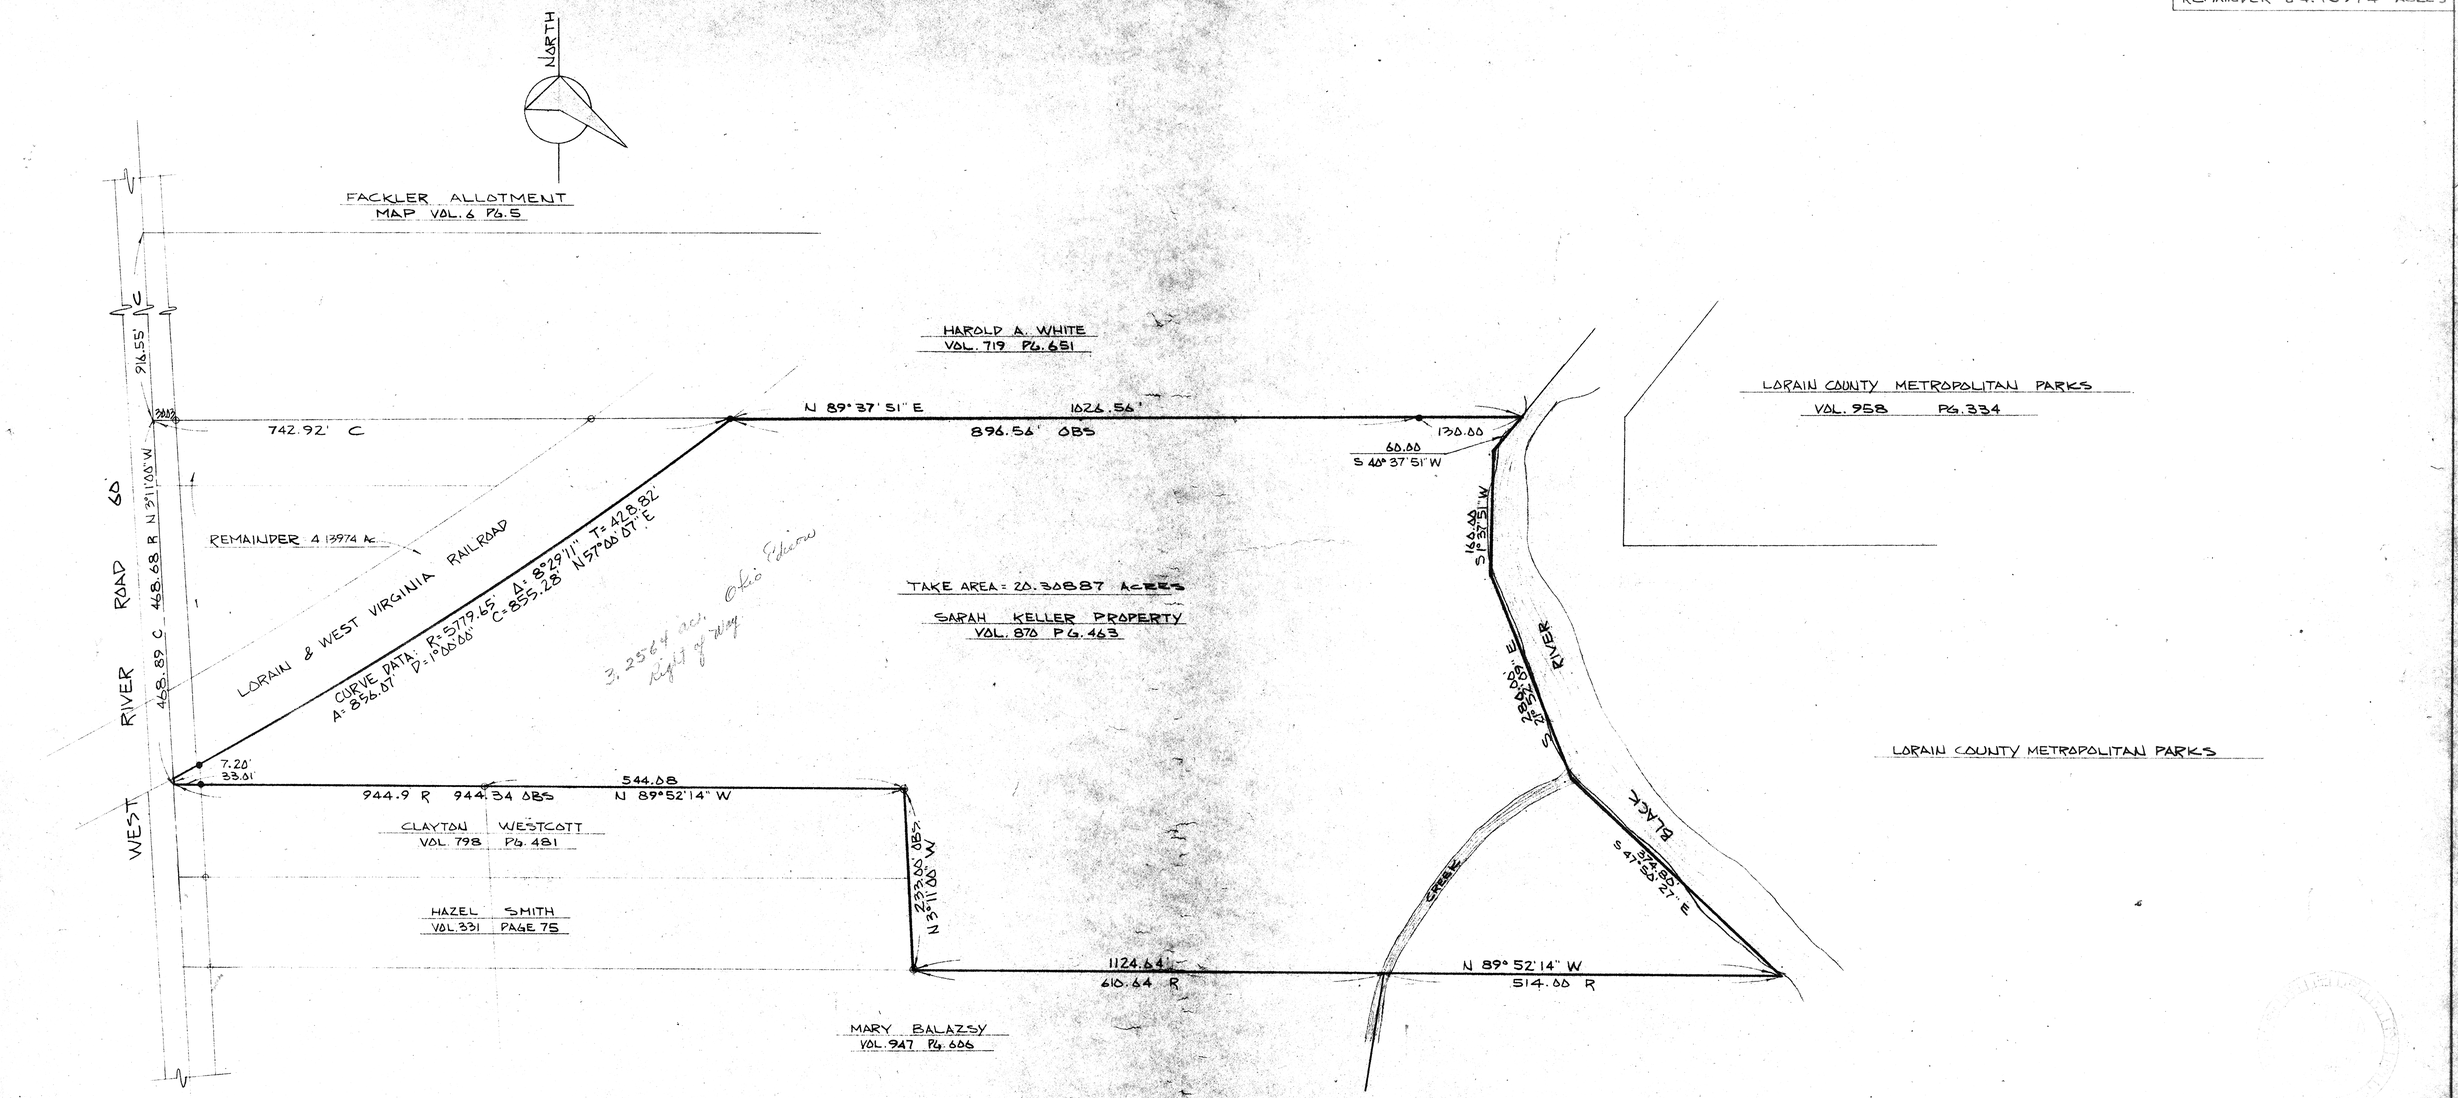

LEGEND
IRON PIN FOUND - - - - O
IRON PIN SET - - - - - ●
RECORD - - - - - - - - R
MEASURED - - - - - - M
OBSERVED - - - - - OBS
CALCULATED - - - - - C

STATE OF OHIO
JOHN L. MENO
5602
REGISTERED SURVEYOR

LORAIN COUNTY METROPOLITAN PARK DISTRICT
LAND ACQUISITION SURVEY
SARAH KELLER PROPERTY
ELYRIA TOWNSHIP

SCHAFER, HURA & ASSOCIATES, INC.
ENGINEERS AND SURVEYORS
4370 OBERLIN AVE.
LORAIN, OHIO

NBR 21

ORIGINAL LOT	11	DATE	1-17-73
TOWNSHIP	ELYRIA	SCALE	1" = 100'
CITY OF		FIELD BOOK	219 PG. 119
COUNTY OF	LORAIN	DRAWN BY	JFR
STATE OF	OHIO	CHECKED BY	J.L.M.
W. O.	1685-14A	FILE NO.	6-BURRELL PG-11