OG-23-016-102
G-46

PPN 06-23-016-102 ???

MAP PG 6-46 43820

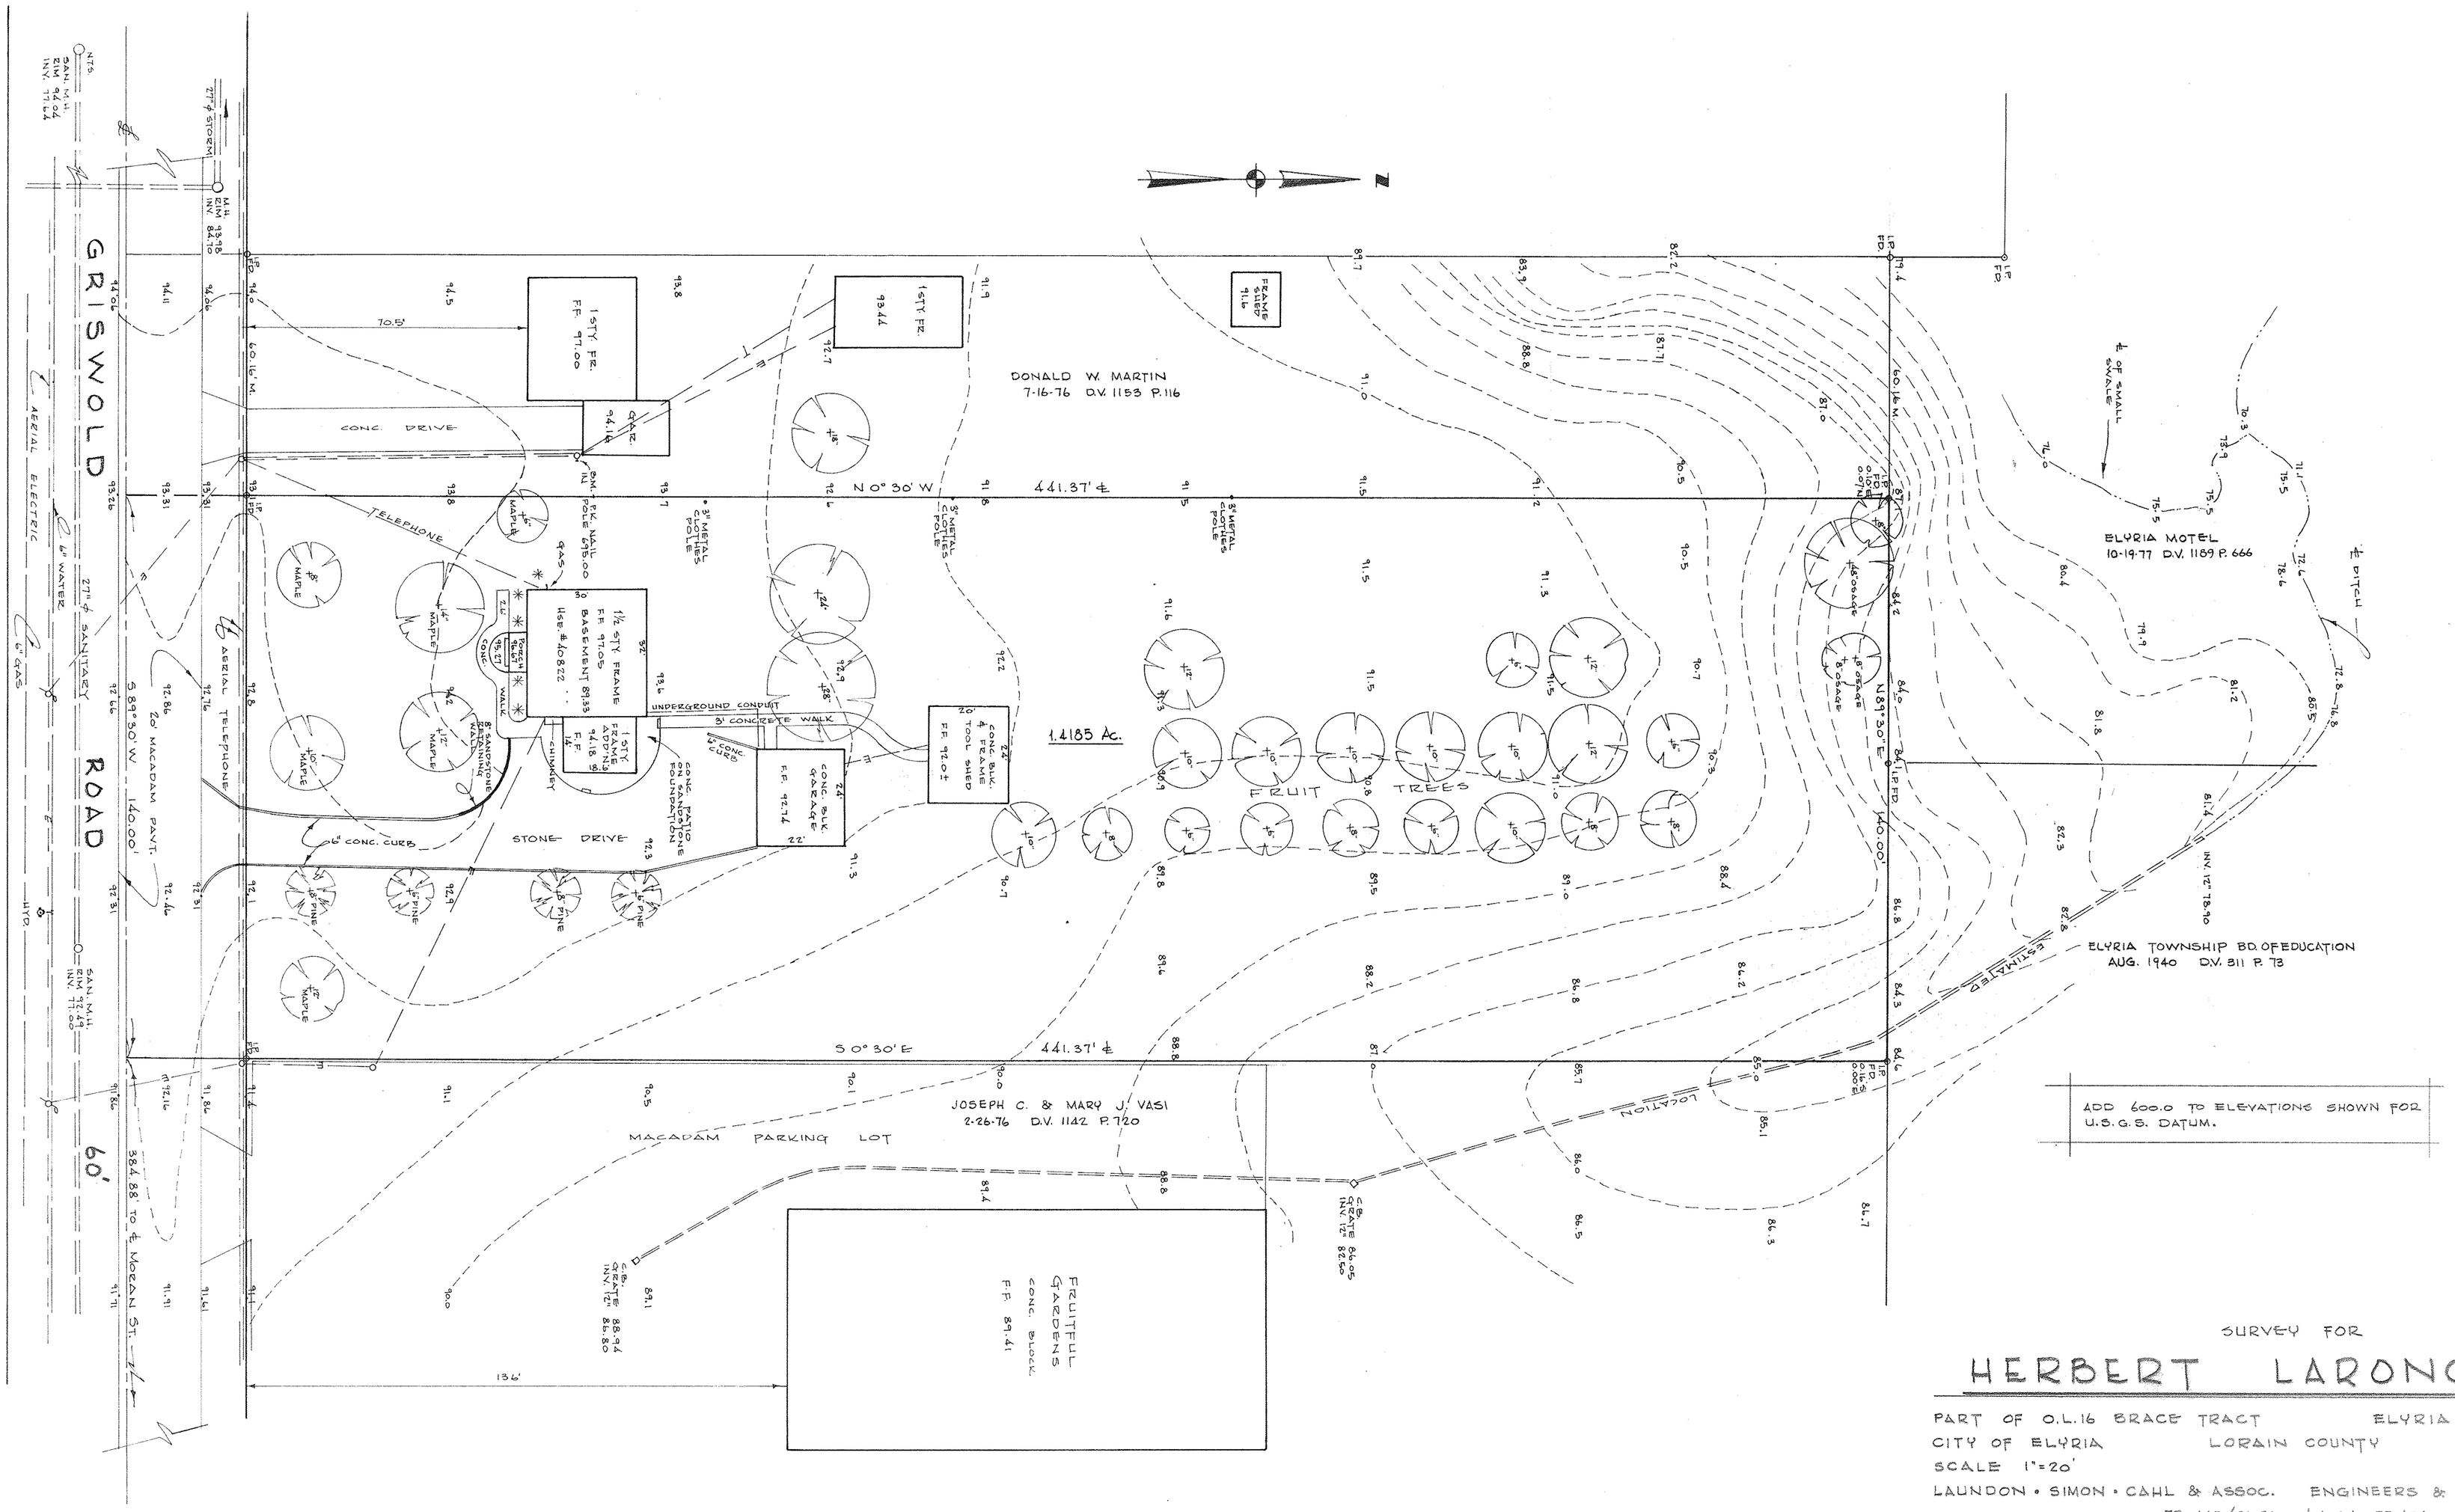

ADD 600.0 TO ELEVATIONS SHOWN FOR U.S.G.S. DATUM.

SURVEY FOR

HERBERT LARONGE INC.

PART OF O.L. 16 BRACE TRACT — ELYRIA TOWNSHIP
CITY OF ELYRIA — LORAIN COUNTY — OHIO
SCALE 1"=20' — DEC. 1977
LAUNDON • SIMON • CAHL & ASSOC. — ENGINEERS & SURVEYORS
FB. 145/56-59 — Job No. 77-694