6-24-015-000-014
6-93

PPN 06-24-015-000-014

MAP PG 6-93

#3823

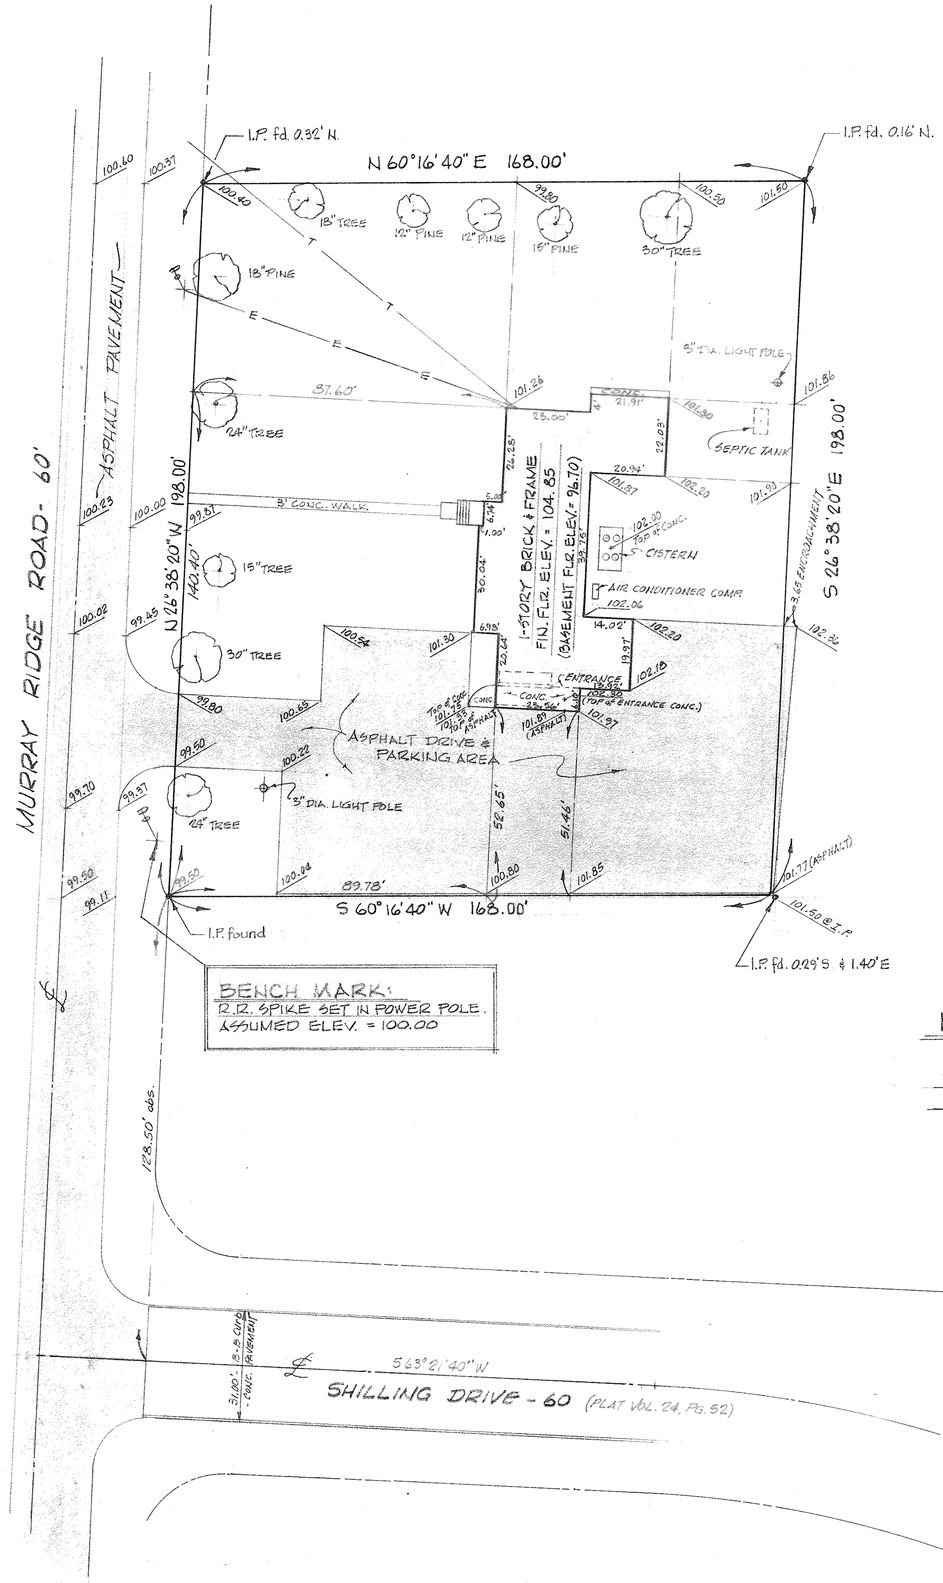


BENCH MARK:
R.R. SPIKE SET IN POWER POLE.
ASSUMED ELEV. = 100.00

# MAP of BOUNDARY & TOPOGRAPHICAL SURVEY

PREPARED FOR: LANDIG & WYKOFF ARCHITECTS

PART of ORIGINAL ELYRIA TWP. LOT 15, WEST of BLACK RIVER

CITY of ELYRIA, LORAIN COUNTY OHIO

McGLINCHY AND ASSOCIATES
PROFESSIONAL ENGINEERS AND SURVEYORS
ELYRIA, OHIO

SCALE: 1" = 20' DRAWN BY: B. THOMAS

DATE: NOV. 1981 JOB NO: 817058

NO GAS SERVICE PER COLUMBIA GAS CO.