06-24-095-000-011
6-96

43321.

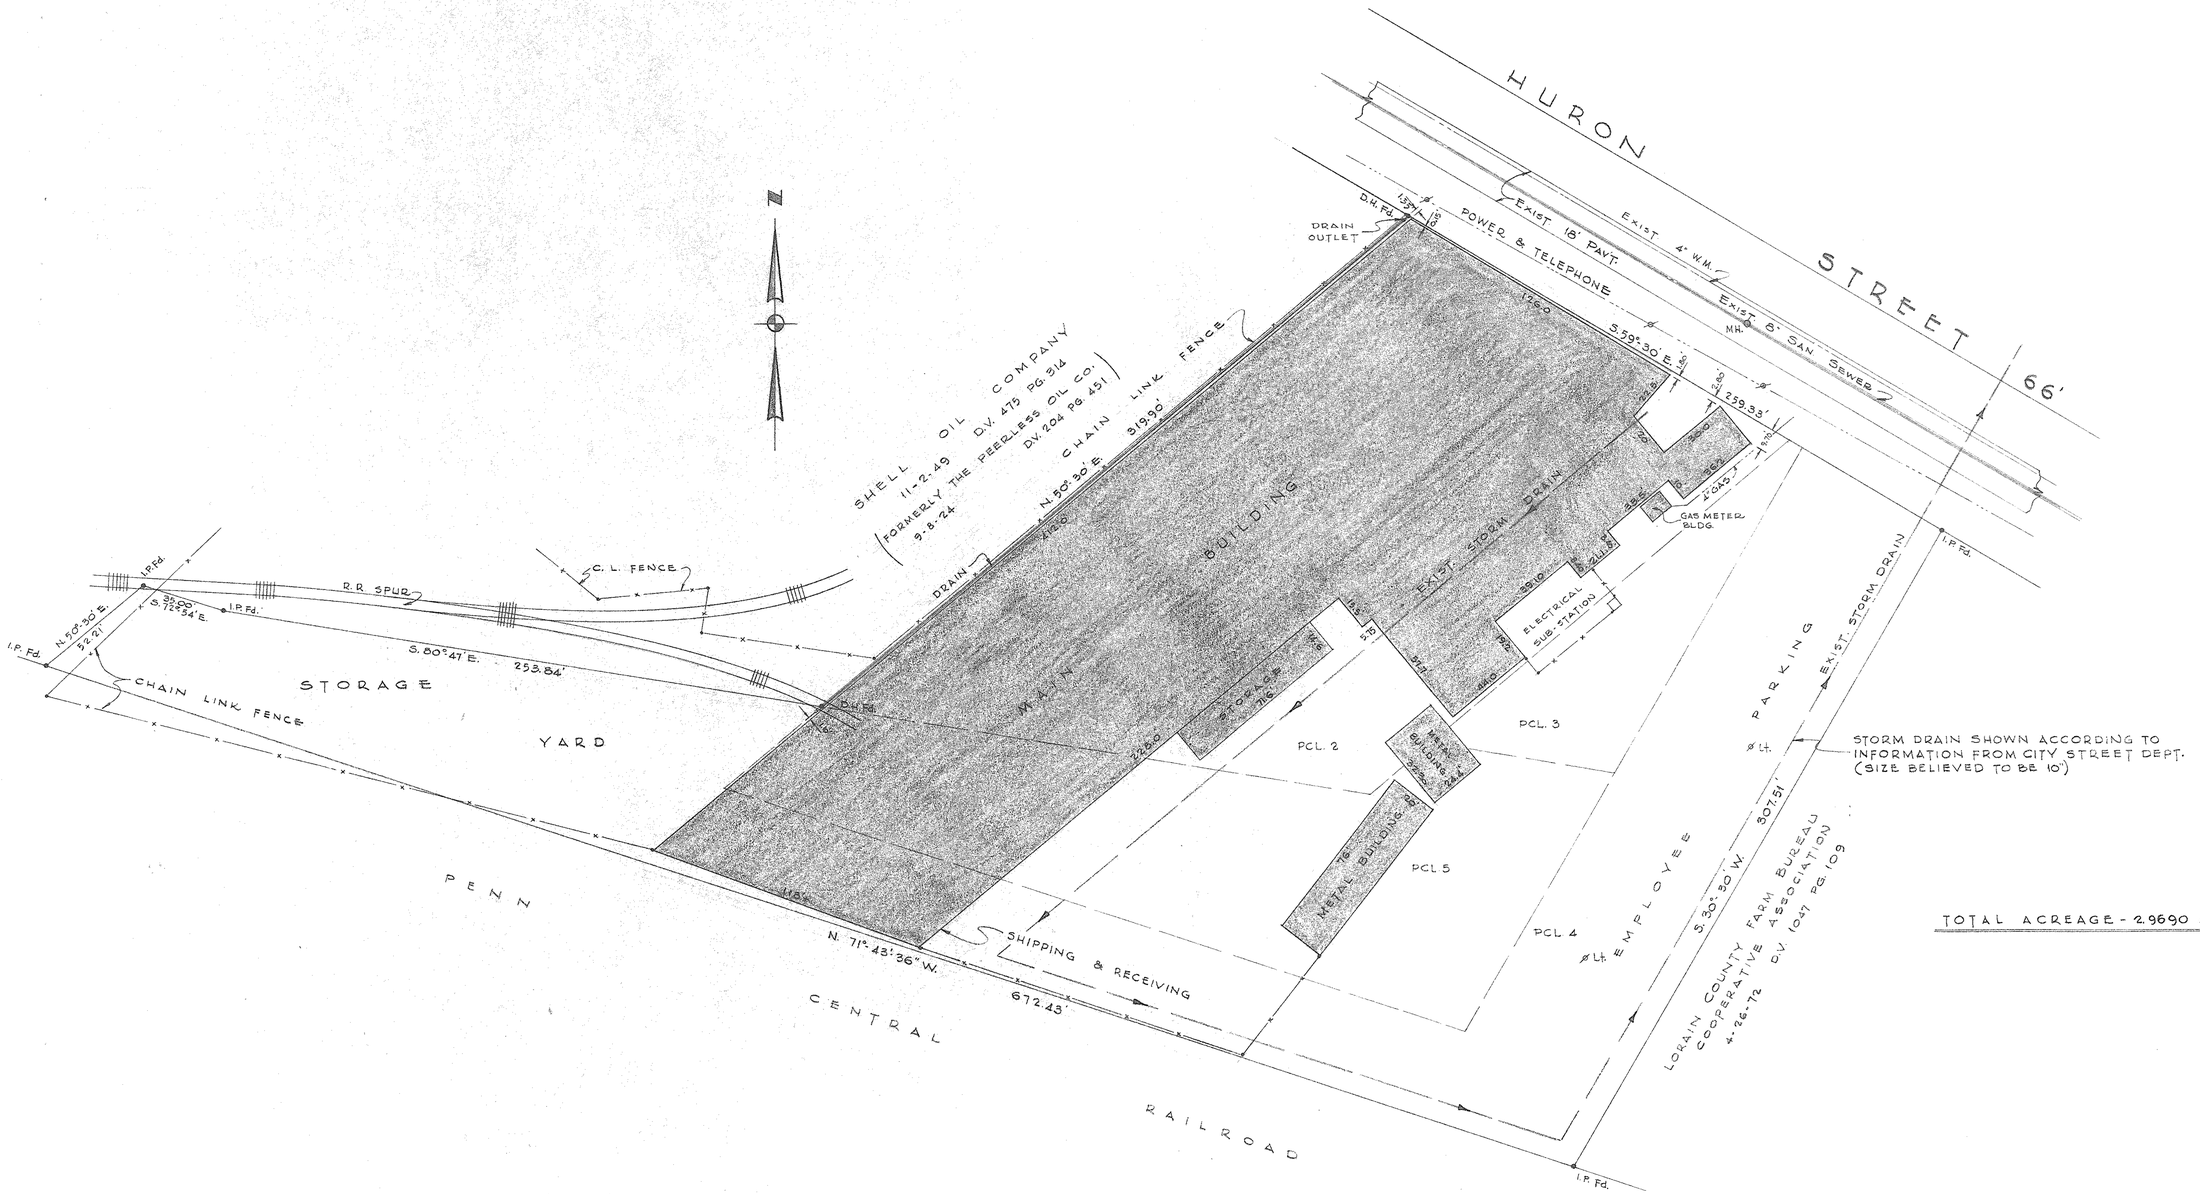

TOTAL ACREAGE - 2.9690 ACRES

THIS IS TO CERTIFY THAT THIS IS A PLAT OF A TRUE AND ACCURATE SURVEY MADE BY LAUNDON · SIMON · CAHL & ASSOC. ENGINEERS & SURVEYORS FOR AND AT THE INSTANCE OF

CHICAGO TITLE INSURANCE CO.

AND

LAND TITLE GUARANTEE AND TRUST CO.

SURVEY AND BUILDING LOCATION

BROWN FINTUBE COMPANY

O.L. 95 & O.L. 96 ELYRIA TOWNSHIP

CITY OF ELYRIA - LORAIN COUNTY - OHIO

SCALE 1"=30' NOVEMBER, 1973

LAUNDON · SIMON · CAHL & ASSOC. INC.
ENGINEERS & SURVEYORS ELYRIA, OHIO 44035

JOB No. 73-193