PPN 06-24-088-000-006 6-98
06-24-088-000-006

MAP PG 6-98
43828

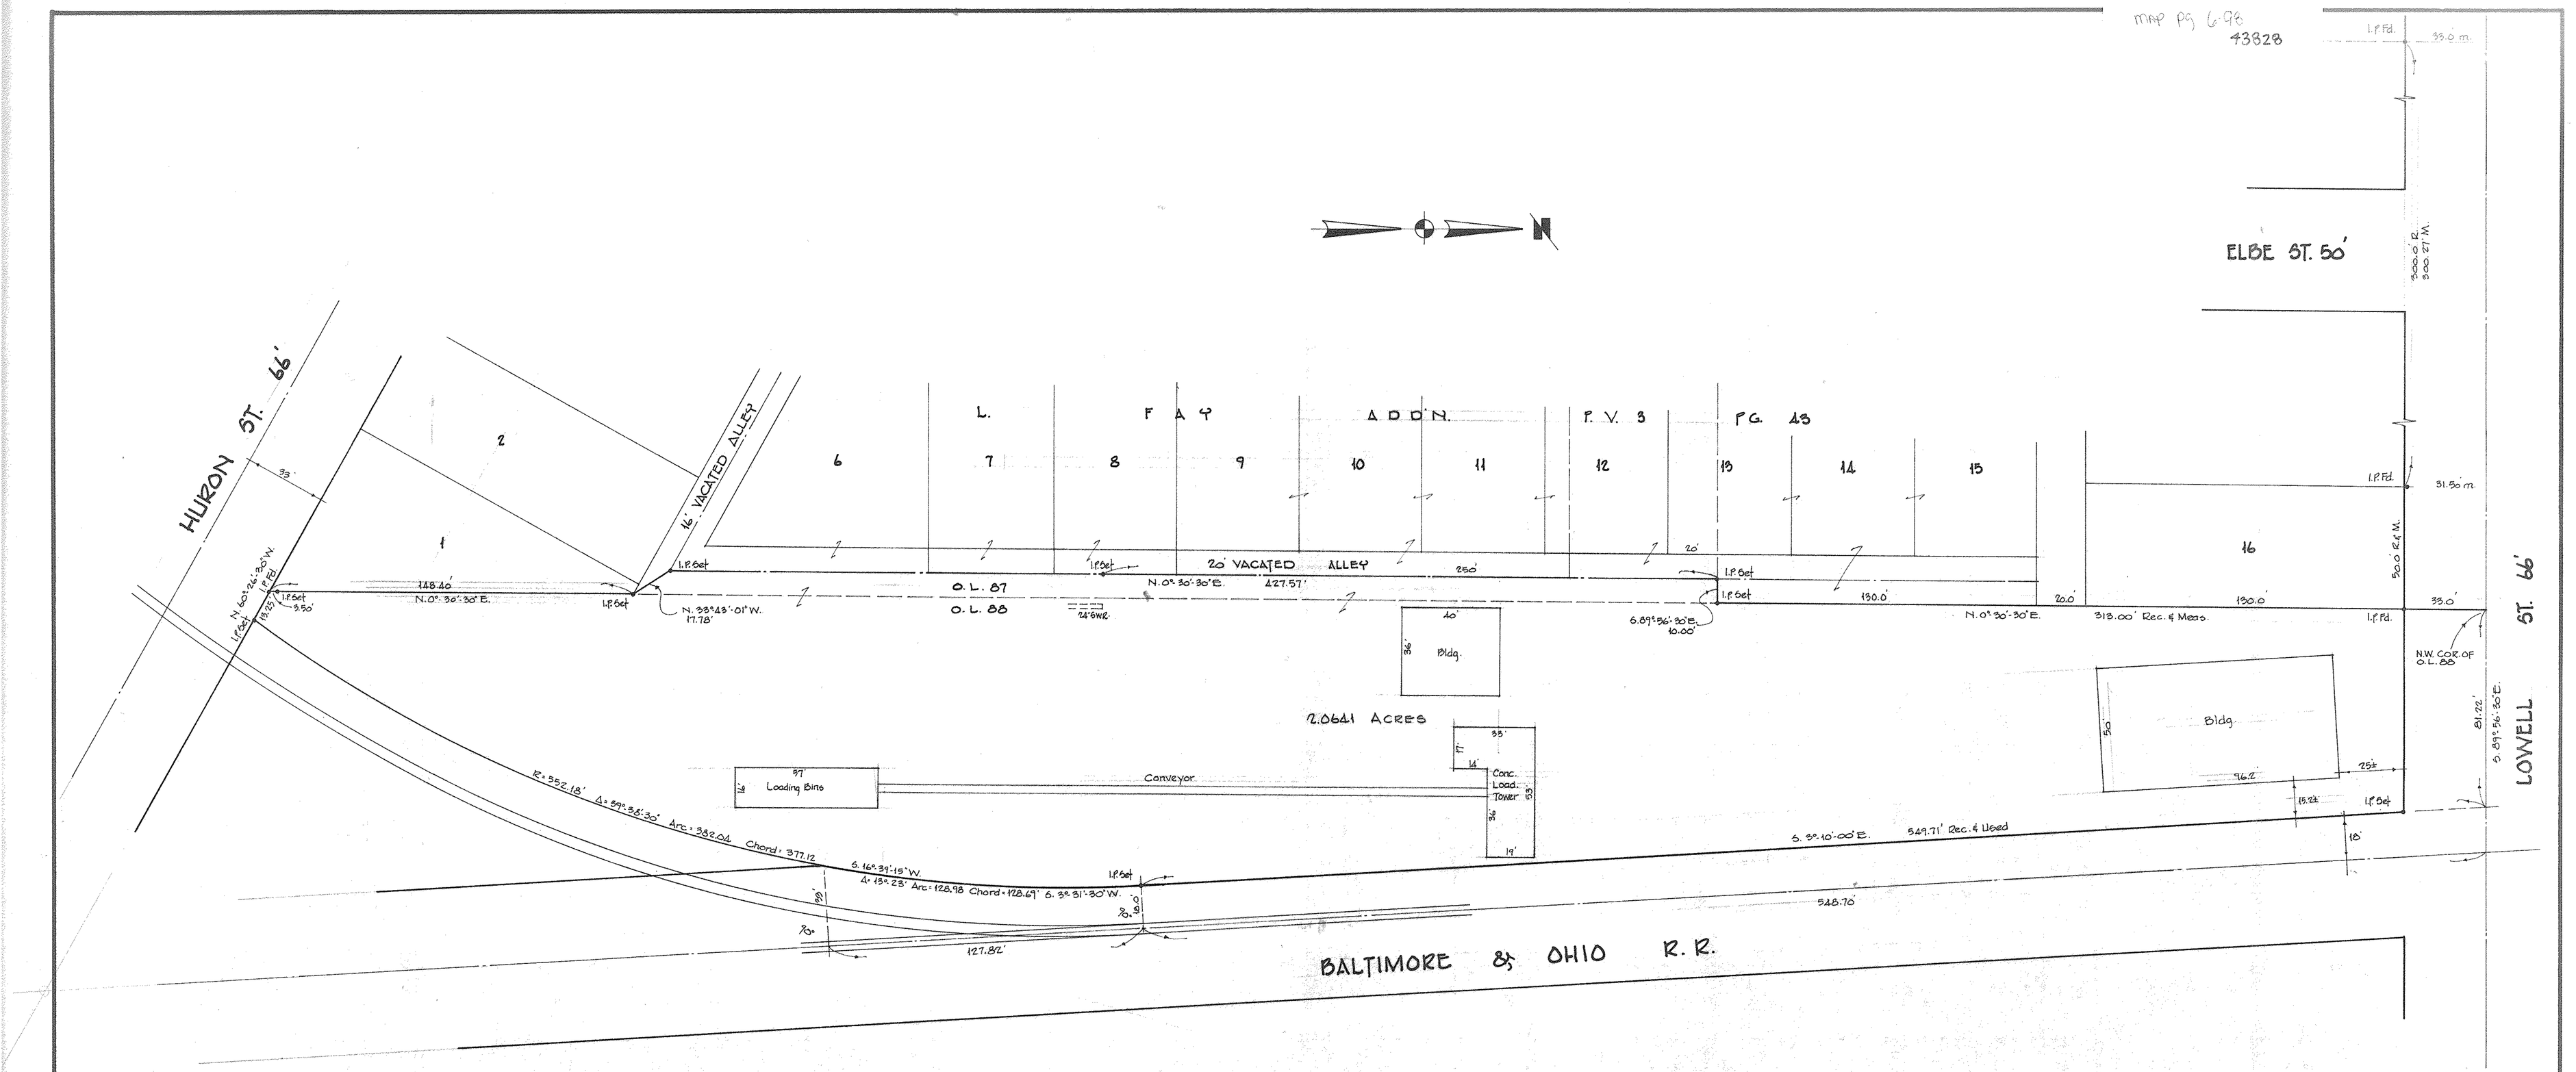

SURVEY FOR THE

ELYRIA SAVINGS & TRUST NATIONAL BANK

PART OF O.L. 88 WEST OF BLACK RIVER OF ELYRIA — CITY OF ELYRIA
COUNTY OF LORAIN — STATE OF OHIO

SCALE 1" = 30' — JAN., 1987

LAUNDON • SIMON • CAHL & ASSOC. INC.
ENGINEERS — SURVEYORS

JOB Nº 86-1564