06-24-030-000-085
6-46
6-64
TOPO- HOLIDAY INN

PPN 06-24-030-000-085
MAP PG 6-46 6-64
43831

TOPOGRAPHY

HOLIDAY INN

ELYRIA OHIO

SCALE: 1" = 30' 7-6-78
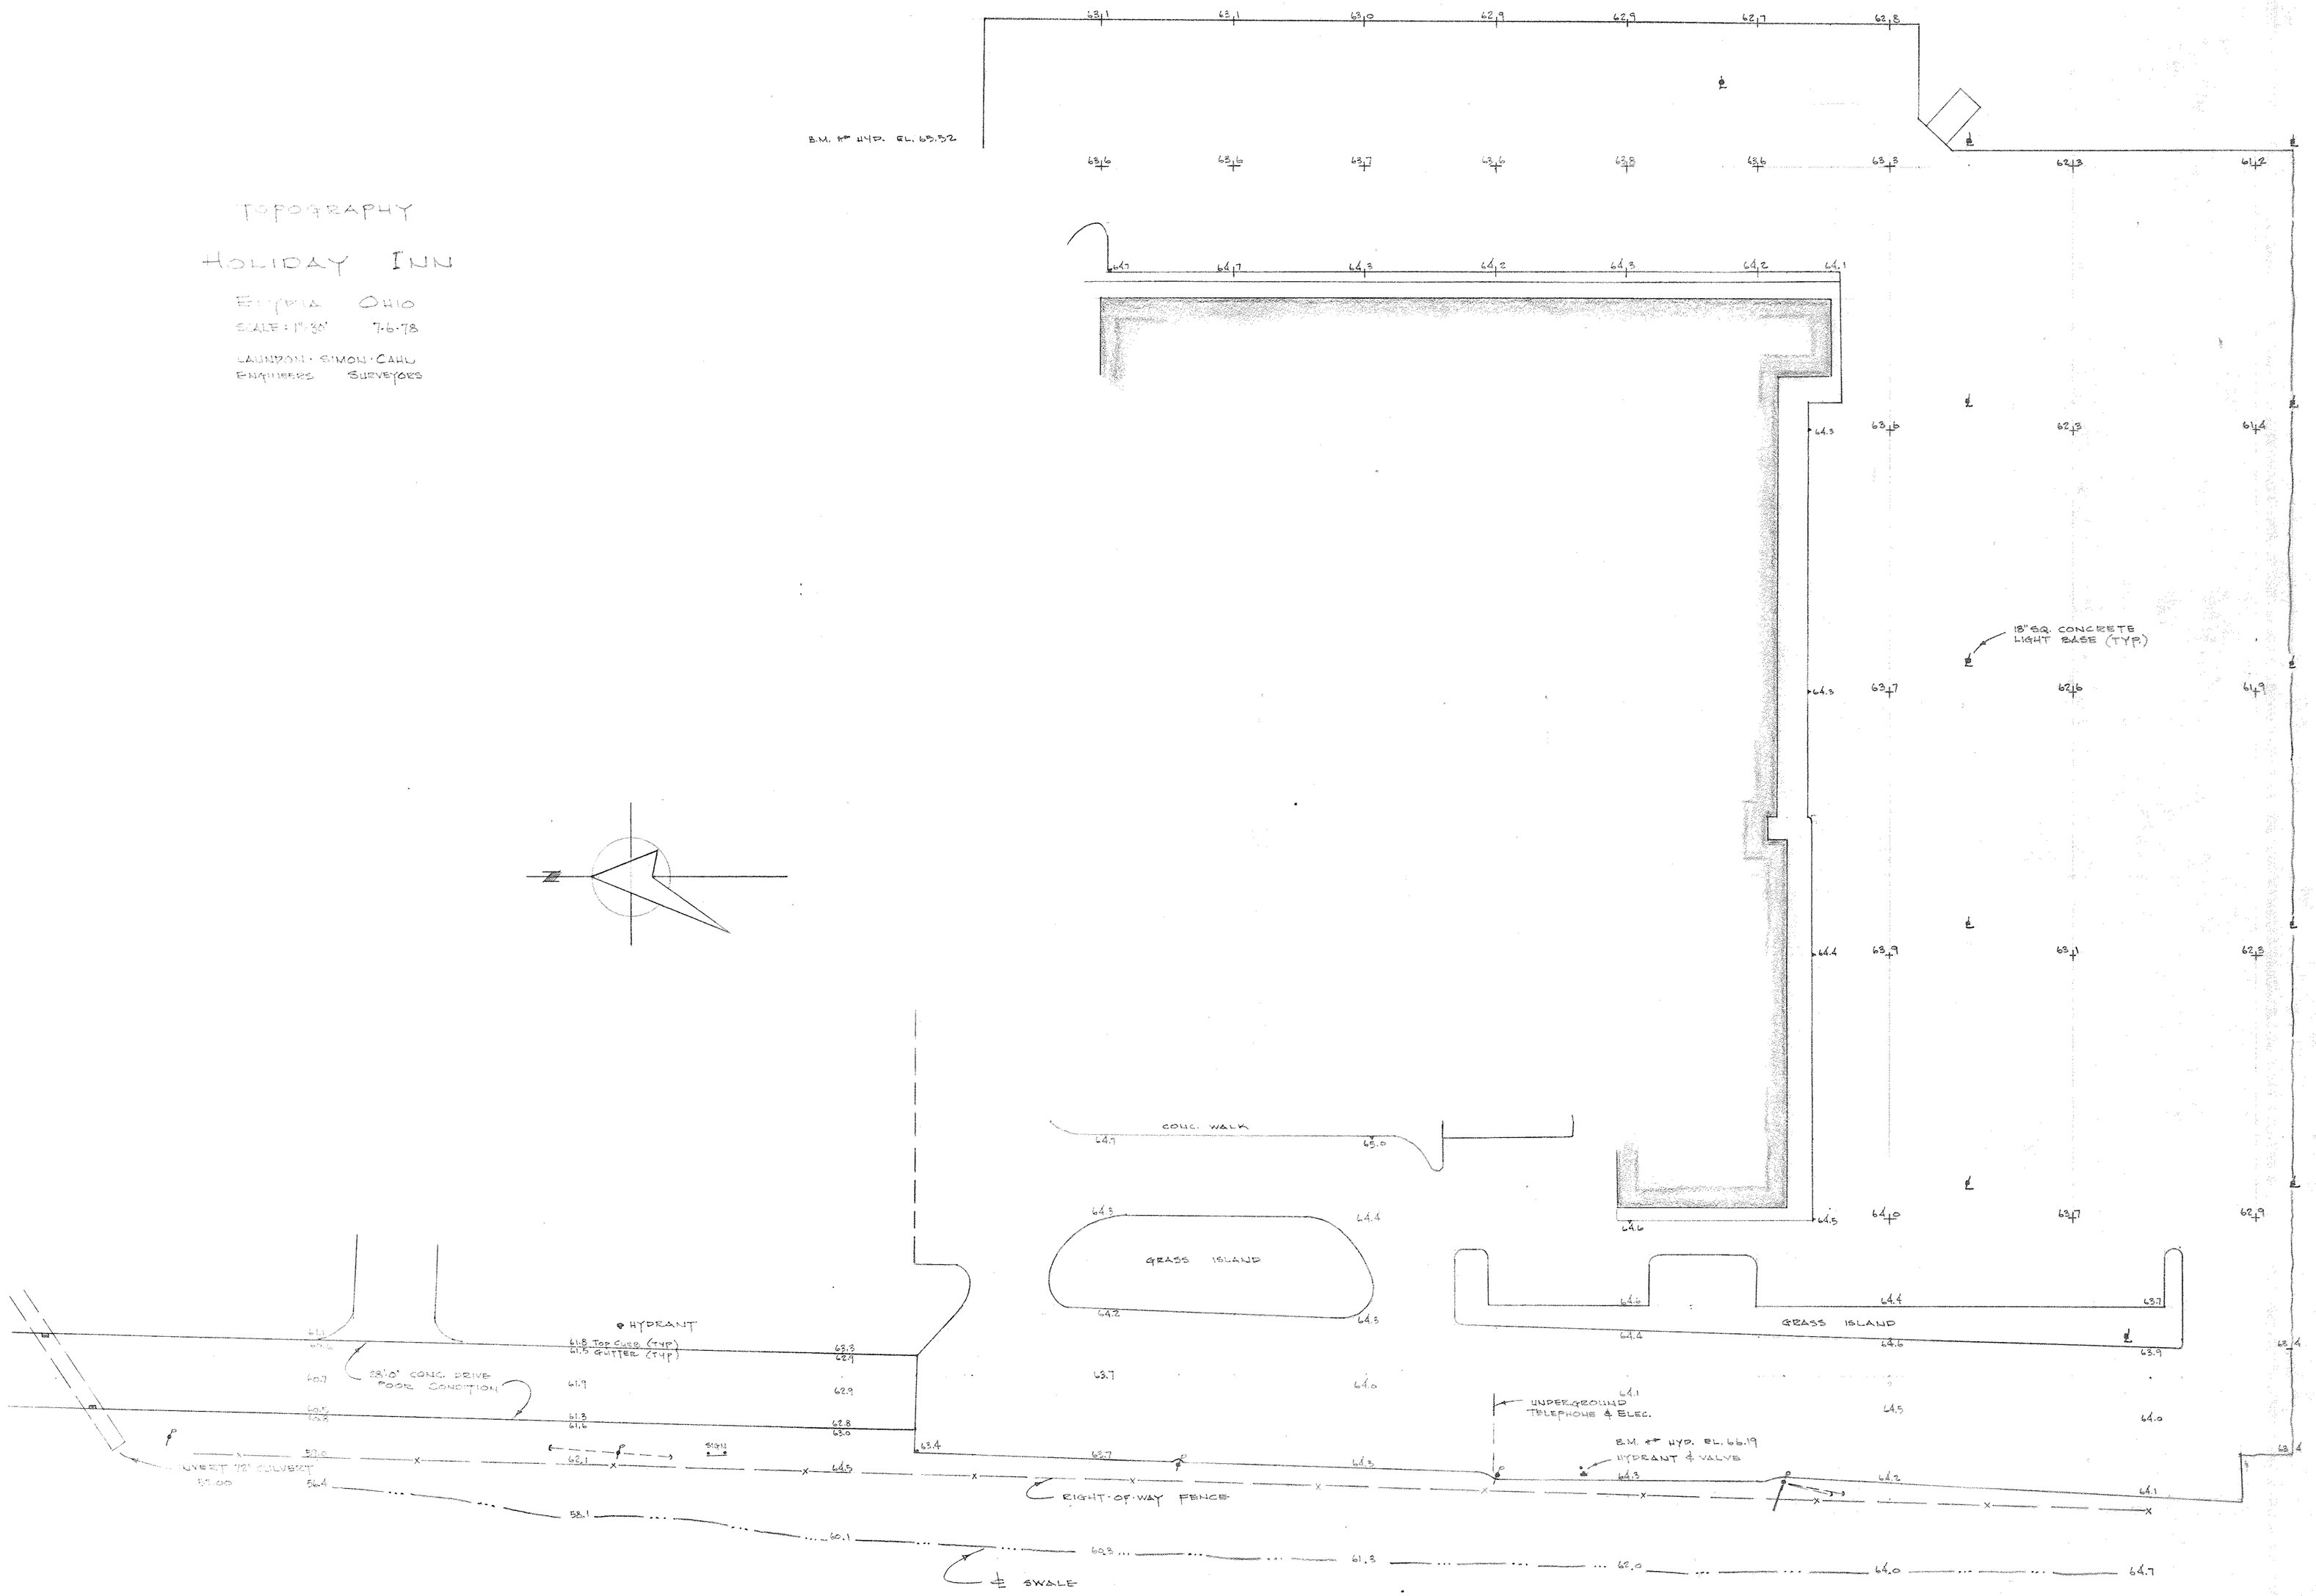
LAUNZONI · SIMON · CARLI
ENGINEERS SURVEYORS