PPN 06-25-001-000-008
06-25-001-000-041
MAP PG 6-143, 6-144
43837

6-25-001-000-008
6-25-001-000-041
6-143 & 6-144

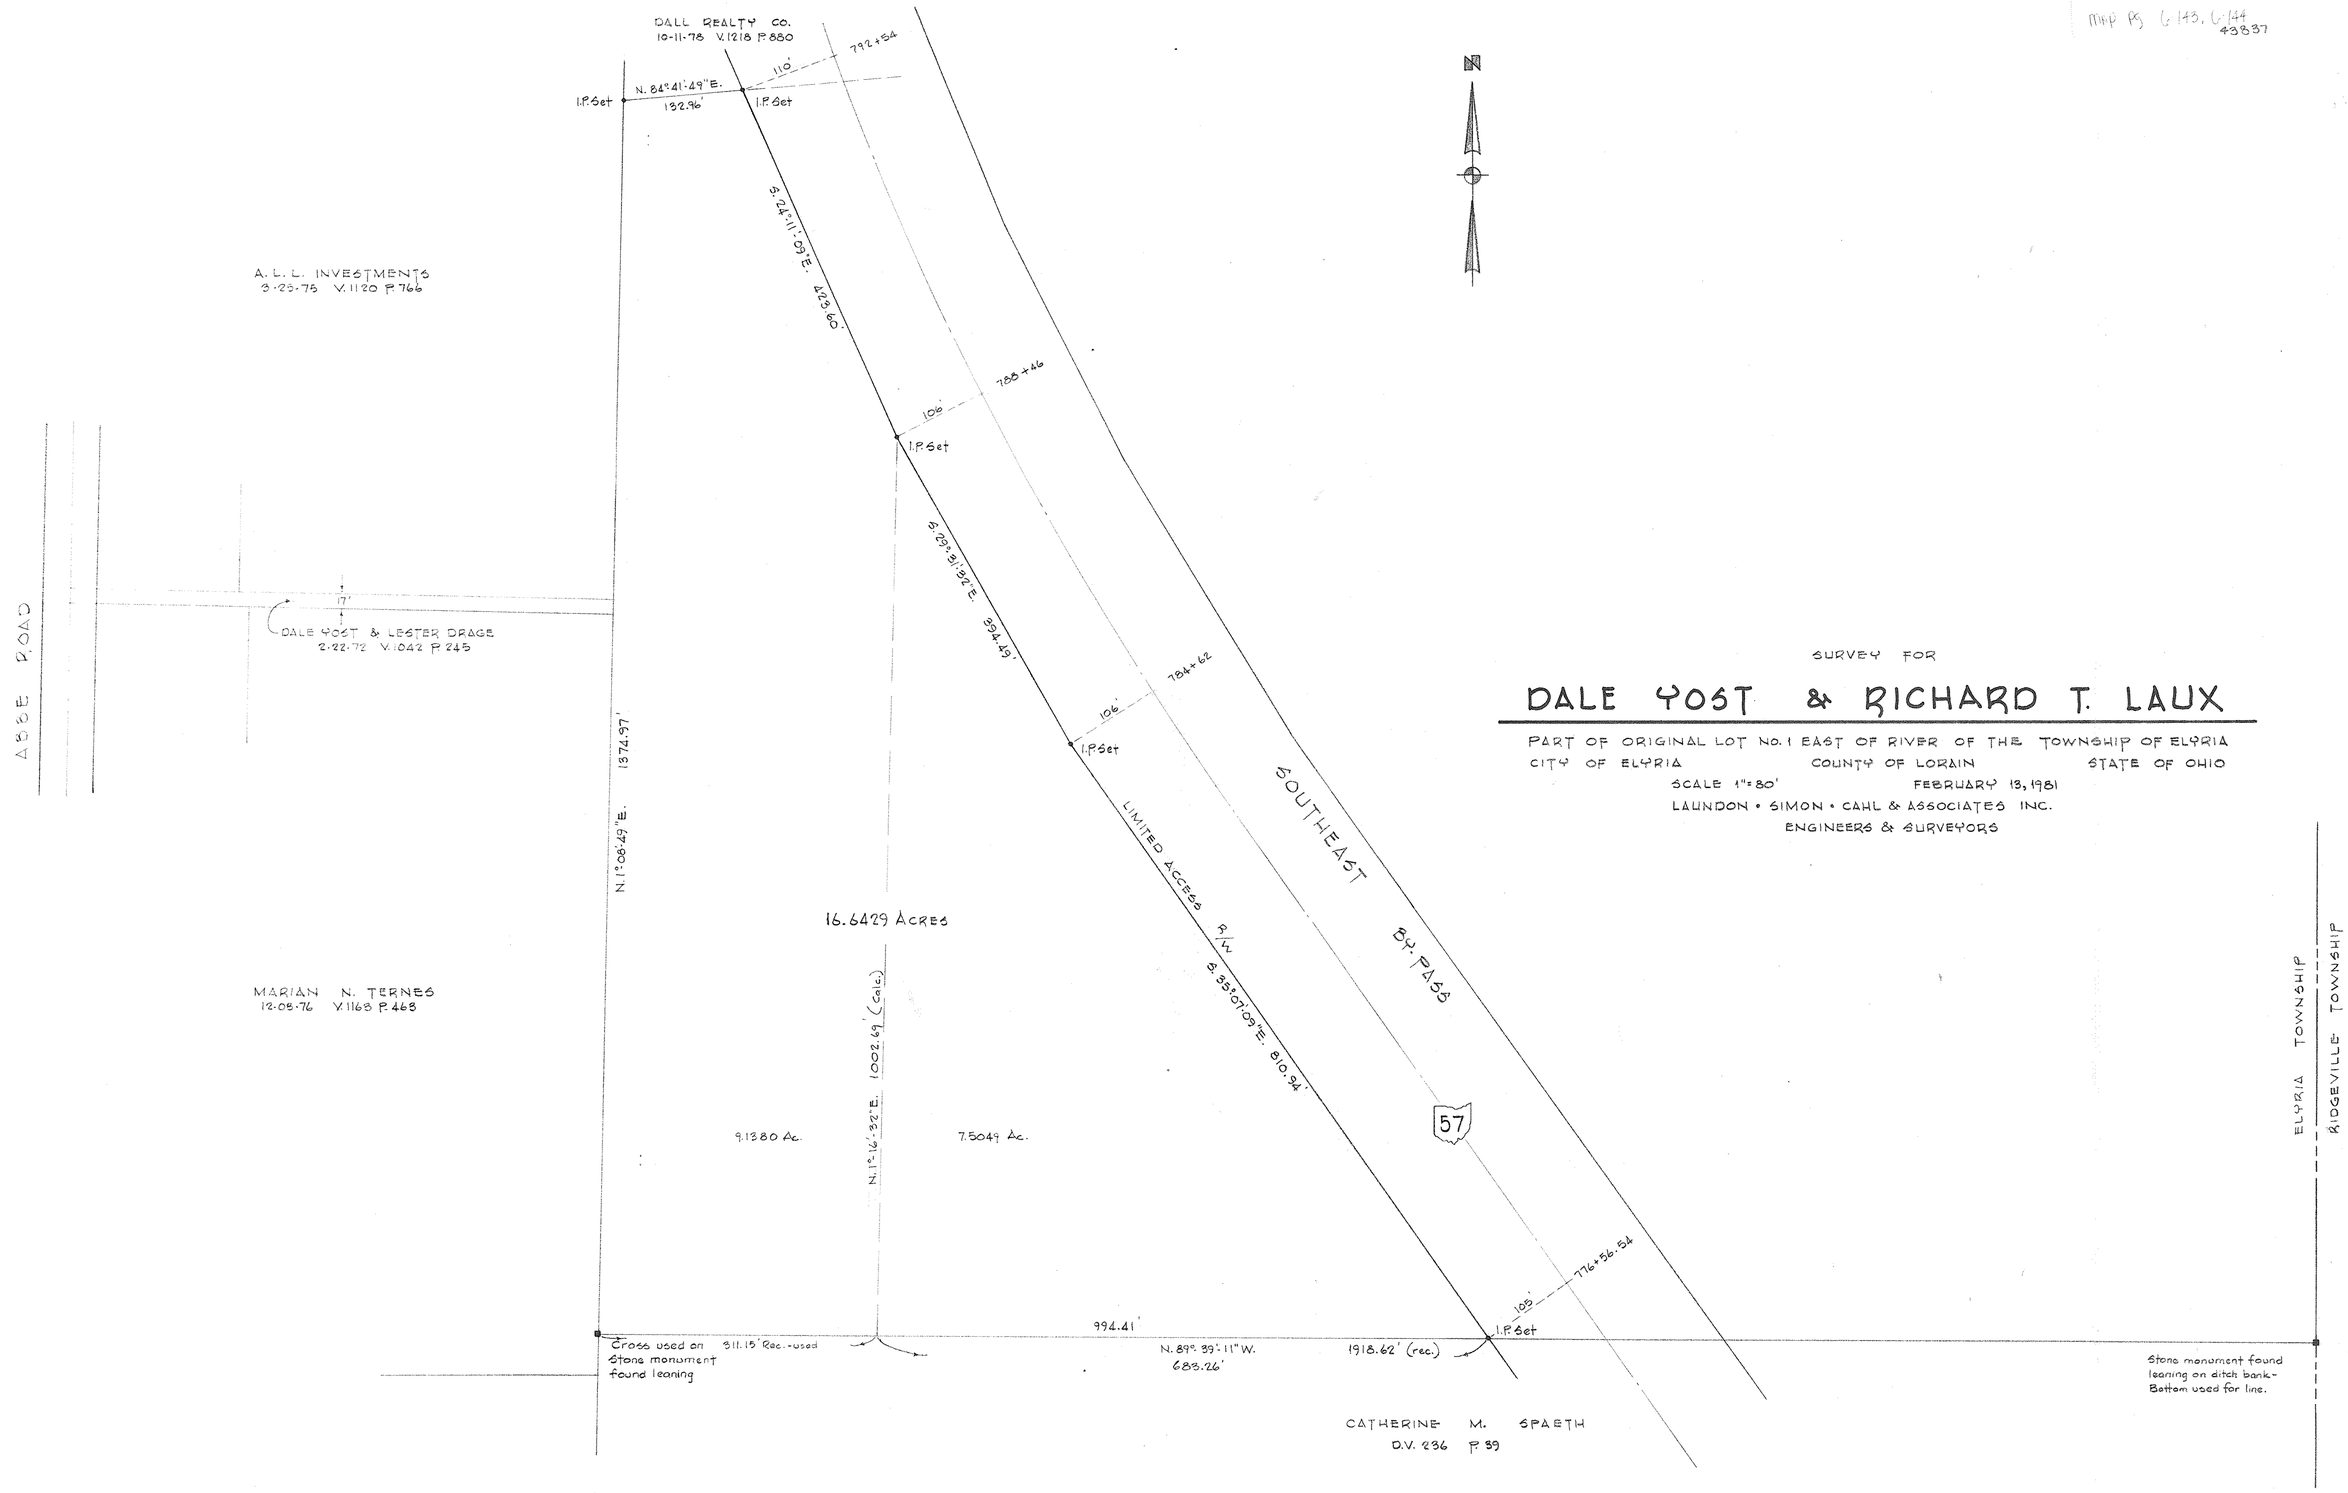

SURVEY FOR

DALE YOST & RICHARD T. LAUX

PART OF ORIGINAL LOT No. 1 EAST OF RIVER OF THE TOWNSHIP OF ELYRIA
CITY OF ELYRIA COUNTY OF LORAIN STATE OF OHIO
SCALE 1"=80' FEBRUARY 13, 1981
LAUNDON • SIMON • CAHL & ASSOCIATES INC.
ENGINEERS & SURVEYORS

Rev. 7-29-81
JOB NO. 81-1029 F.B. 156/57