PPN 06-24-031-107 ???

MAP PG 6-46, 6-47

43838

6-24-031-107
6-46
6-47

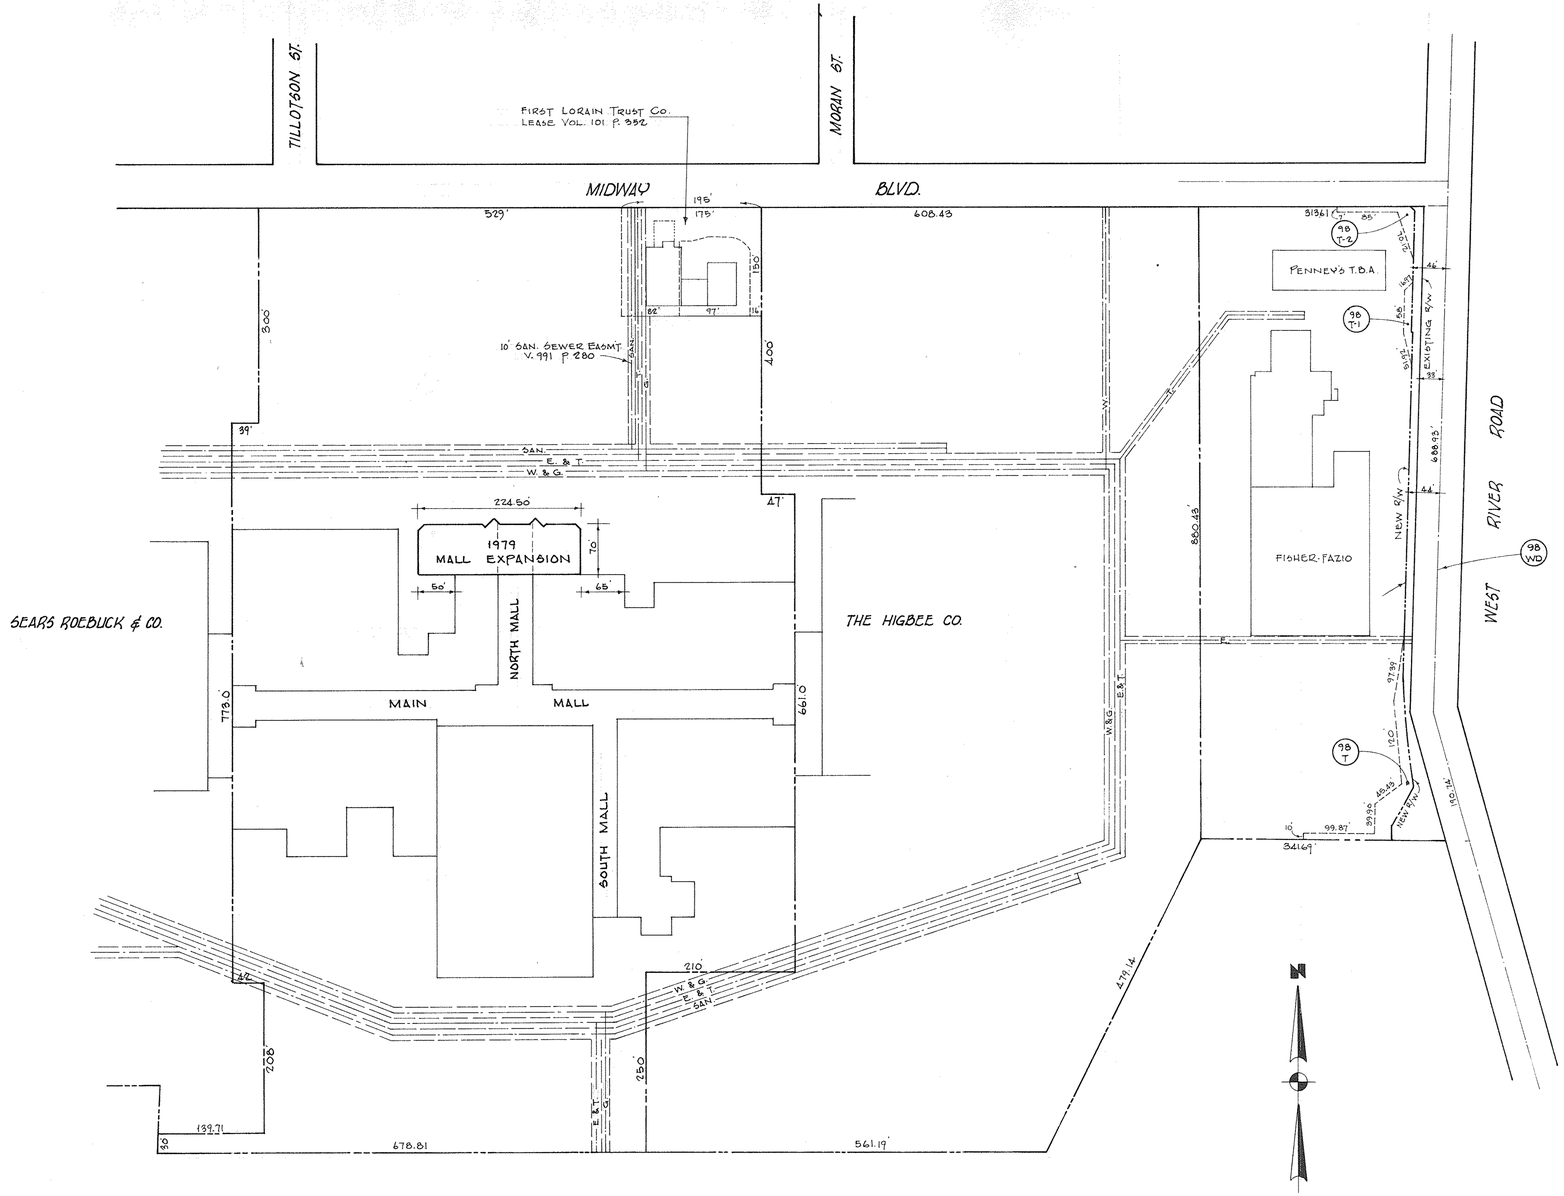

THIS IS TO CERTIFY THAT THE "1979 MALL EXPANSION" SHOWN HEREON IS IN PLACE AND THAT THERE WERE NO ENCROACHMENTS FOUND.

LAUNDON · SIMON · CAHL & ASSOC.
ENGINEERS SURVEYORS
504 MIDDLE AVE. ELYRIA, OHIO 44035 BY Rodger Simon 2/14/80
REG. SURVEYOR Nº 5101

MADE FOR AND AT THE INSTANCE OF CHICAGO TITLE INSURANCE COMPANY AND TEACHERS INSURANCE AND ANNUITY ASSOCIATION OF AMERICA.

THE EASEMENTS SHOWN HEREON ARE SUBJECT TO THE CONDITIONS AND DESIGNATED USES THAT ARE SHOWN ON THE "UTILITY EASEMENTS IN MIDWAY MALL SHOPPING CENTER" MAP AS RE-RECORDED ON DECEMBER 10, 1965 AND APPEARS IN PLAT VOL. 24 PAGES 41 & 41A OF THE LORAIN COUNTY RECORD OF PLATS.

BUILDING LOCATION
FOR
ELYRIA JOINT VENTURE, A PARTNERSHIP

MIDWAY MALL

1979 MALL EXPANSION

CITY OF ELYRIA LORAIN COUNTY OHIO

FEBRUARY 1980 SCALE 1" = 100'

LAUNDON · SIMON · CAHL & ASSOC. INC.

JOB Nº 79-936