6-24-099-000-001
6-24-100-000-001
6-24-101-000-001
6-24-102-000-001
6-116

PPN
Map Pg. 43939

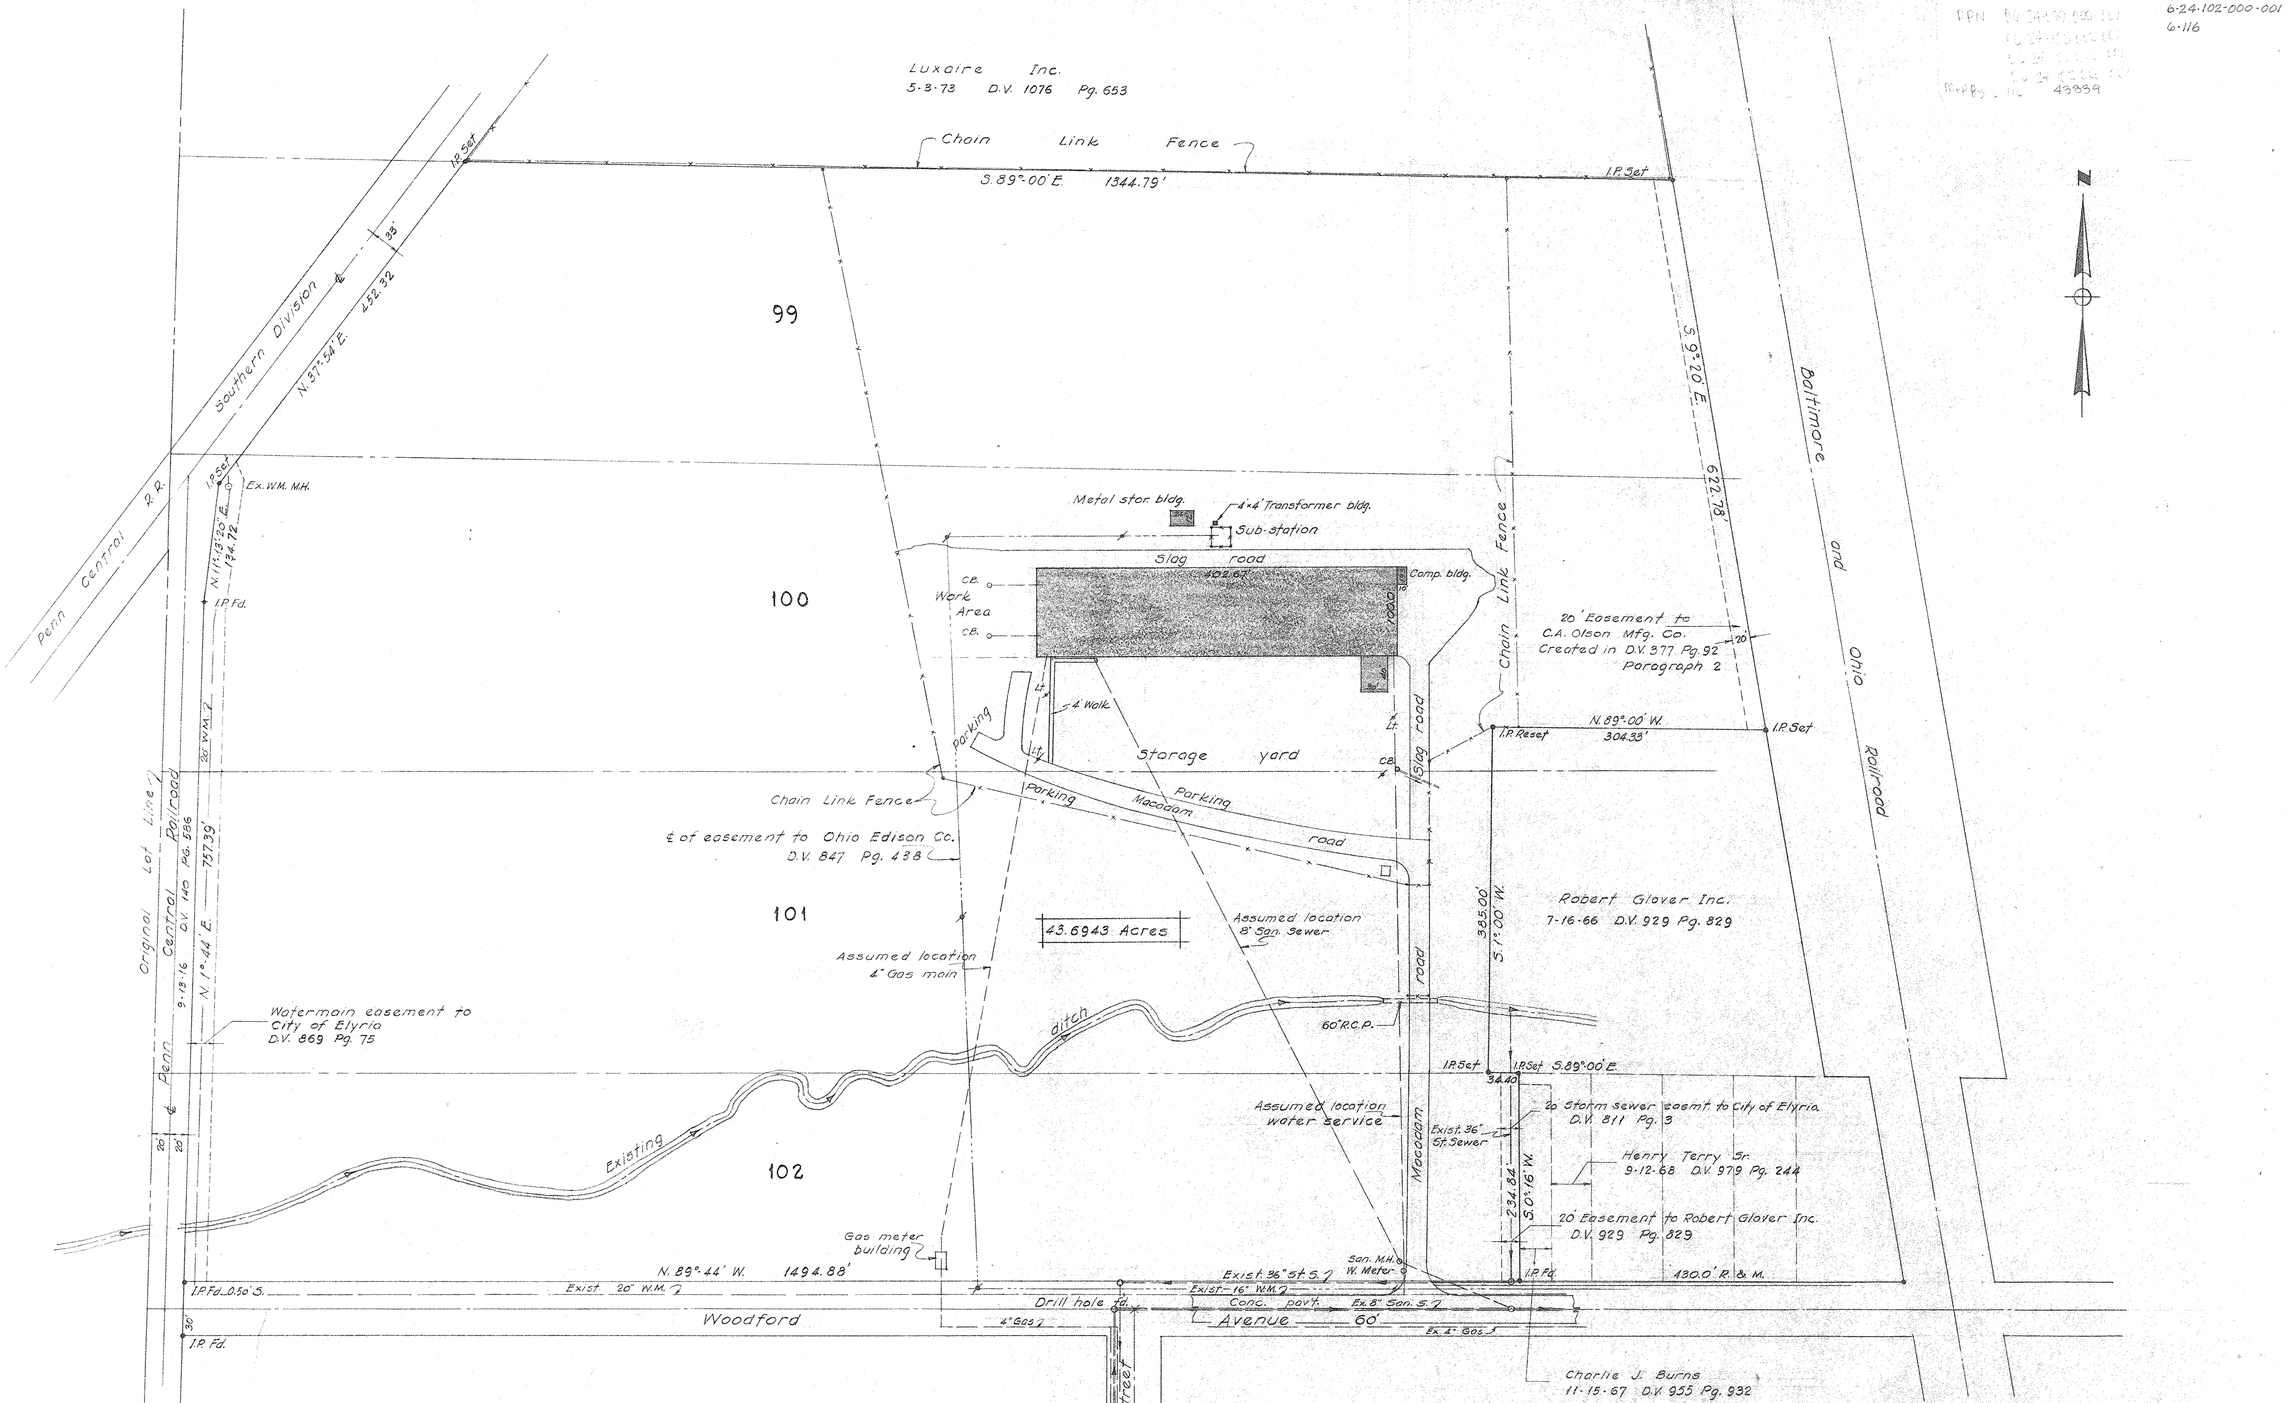

This is to certify that this is a plat of a true and accurate survey made by Laundon · Simon · Cahl and Assoc. - Engineers and Surveyors for and at the instance of:

Chicago Title Insurance Co.
and
Land Title Guarantee and Trust Co.

STATE OF OHIO
ROGER G. SIMON
5101
REGISTERED SURVEYOR

Revised 11-29-73

SURVEY AND BUILDING LOCATION

BROWN FINTUBE COMPANY

PART OF O.L.'s 99, 100, 101 & 102 WEST OF WEST BRANCH OF THE BLACK RIVER - TOWNSHIP OF ELYRIA

CITY OF ELYRIA - COUNTY OF LORAIN - STATE OF OHIO

SCALE 1"=60' NOVEMBER, 1973

LAUNDON · SIMON · CAHL & ASSOC. INC.
ENGINEERS & SURVEYORS ELYRIA, OHIO 44035
JOB Nº 73-195