06-25-075-101-001
G-121

PPN 06-25-075-101-001
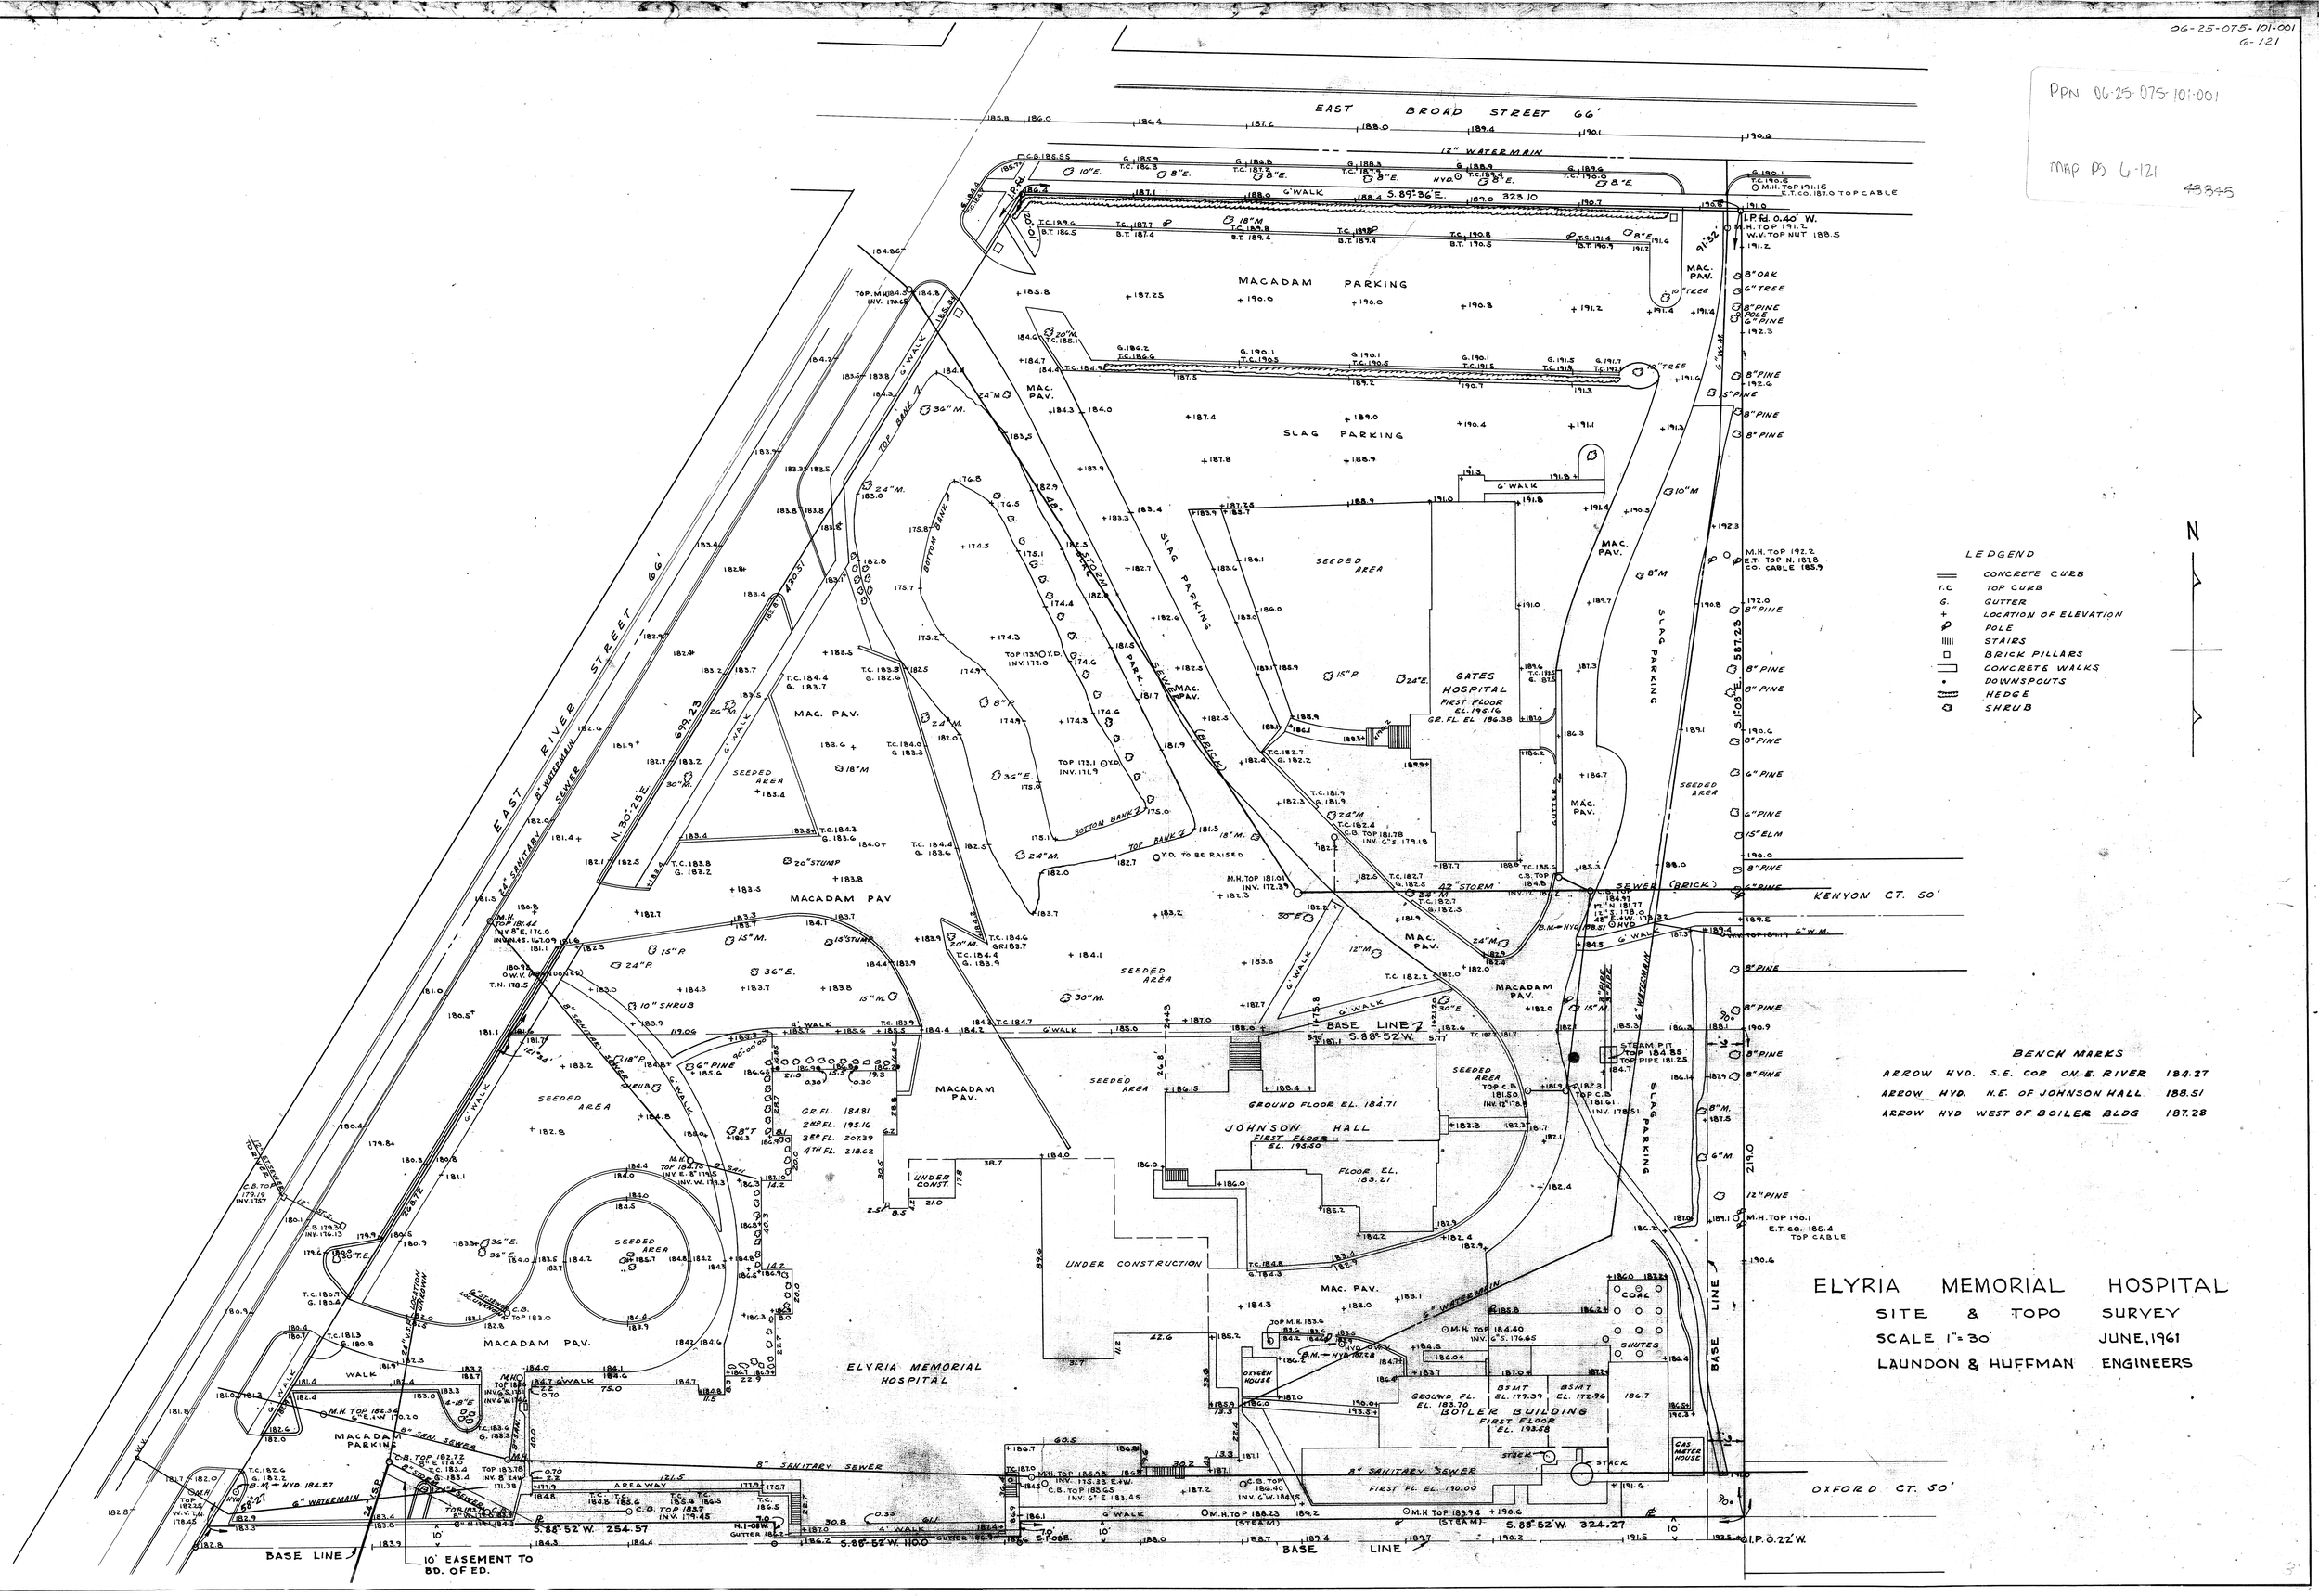
MAP PD G-121