6-121
06-25-075-101-010 thru 014
& Pt. - 015

PPN 06-25-075-101-010
thru
014
015
MAP PG 6-121 43853

SURVEY
AND
TOPOGRAPHY
OF
SUBLOT NOS. 1271 TO 1279
IN
EASTERN HGTS. CO'S SUBN. 5
ELYRIA, OHIO

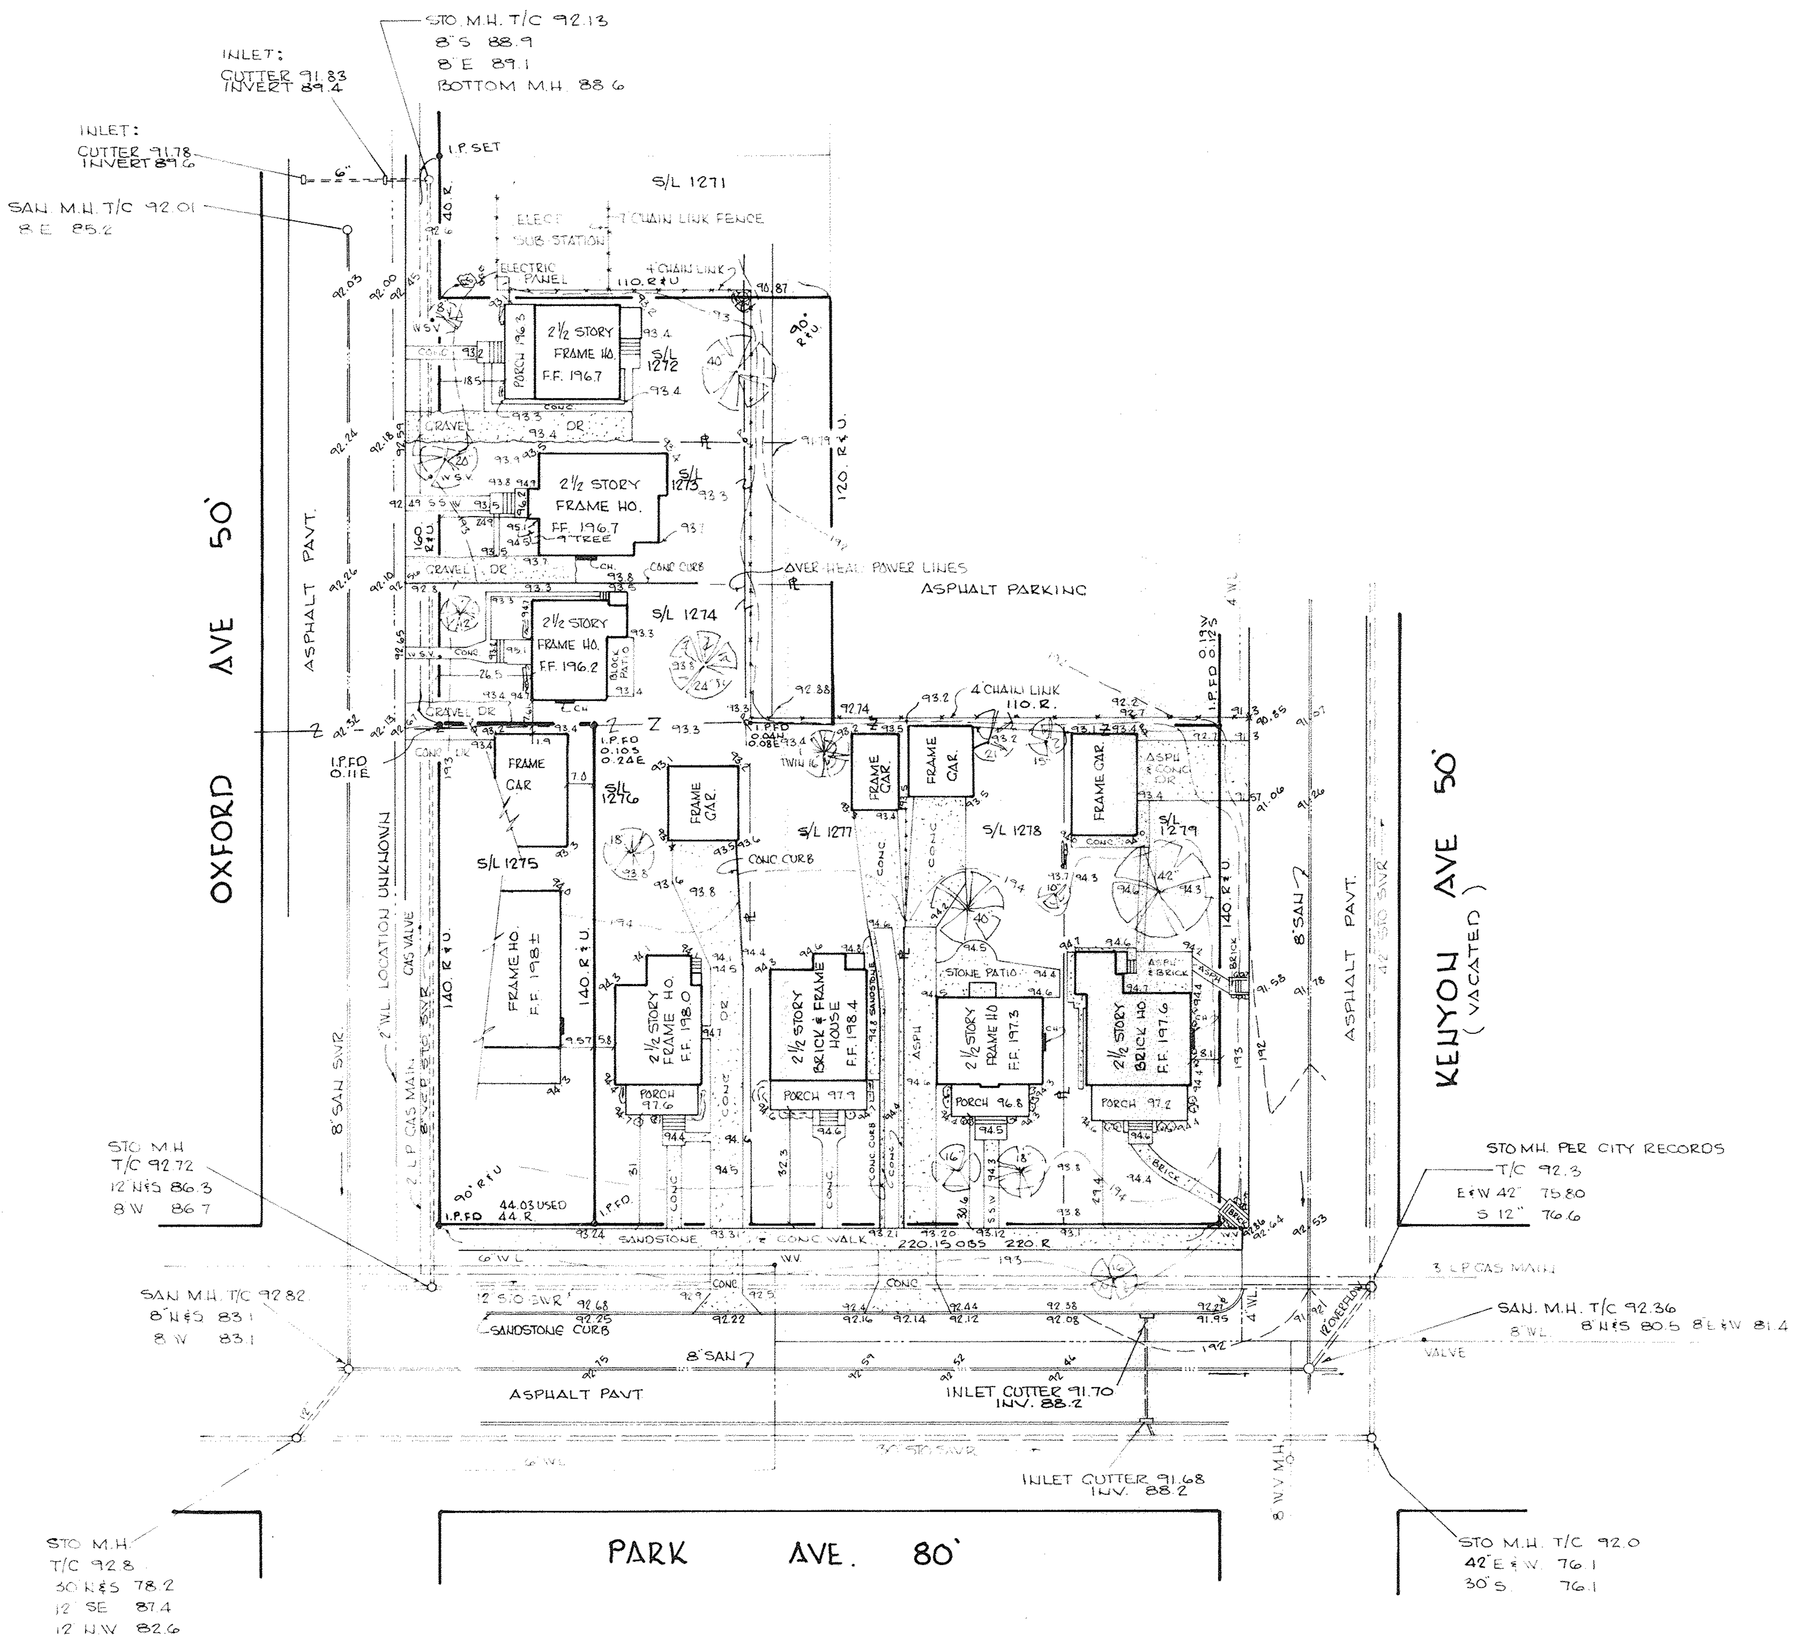

DATE: NOV. 1986
SCALE: 1" = 30'

LEGEND

W.S.V.	WATER SERVICE VALVE
	POWER POLE
	LIGHT POLE
S.S.W.	SANDSTONE SIDEWALK
C.H.	BRICK CHIMNEY
W.V.	WATER VALVE
PL	PROPERTY LINE
	DIRECTION OF SWR FLOW
	ORNAMENTAL BUSH

NOTE:
1. BASEMENT ELEV. COULD NOT BE OBTAINED DUE TO HOUSES BEING VACANT AND LOCKED EXCEPT S/L 1271
2. ALL HOUSES HAVE BASEMENTS AND ARE AST 4.5' DEEP.
3. BENCH MARK USED: FIN. FLOOR MAIN BLDG. E.M.H. ELEV. 184.56

PREPARED BY:

LAUNDON-SIMON-CAHL AND ASSOC., INC.
ENGINEERS AND SURVEYORS
219 COURT ST
ELYRIA, OHIO

JOB No. 86-1643