




11-00-055-000-029
CROW DZIEDZIAK PROPERTIES
DOC. #2003088618
10/17/03

O.L. 55 O.L. 46

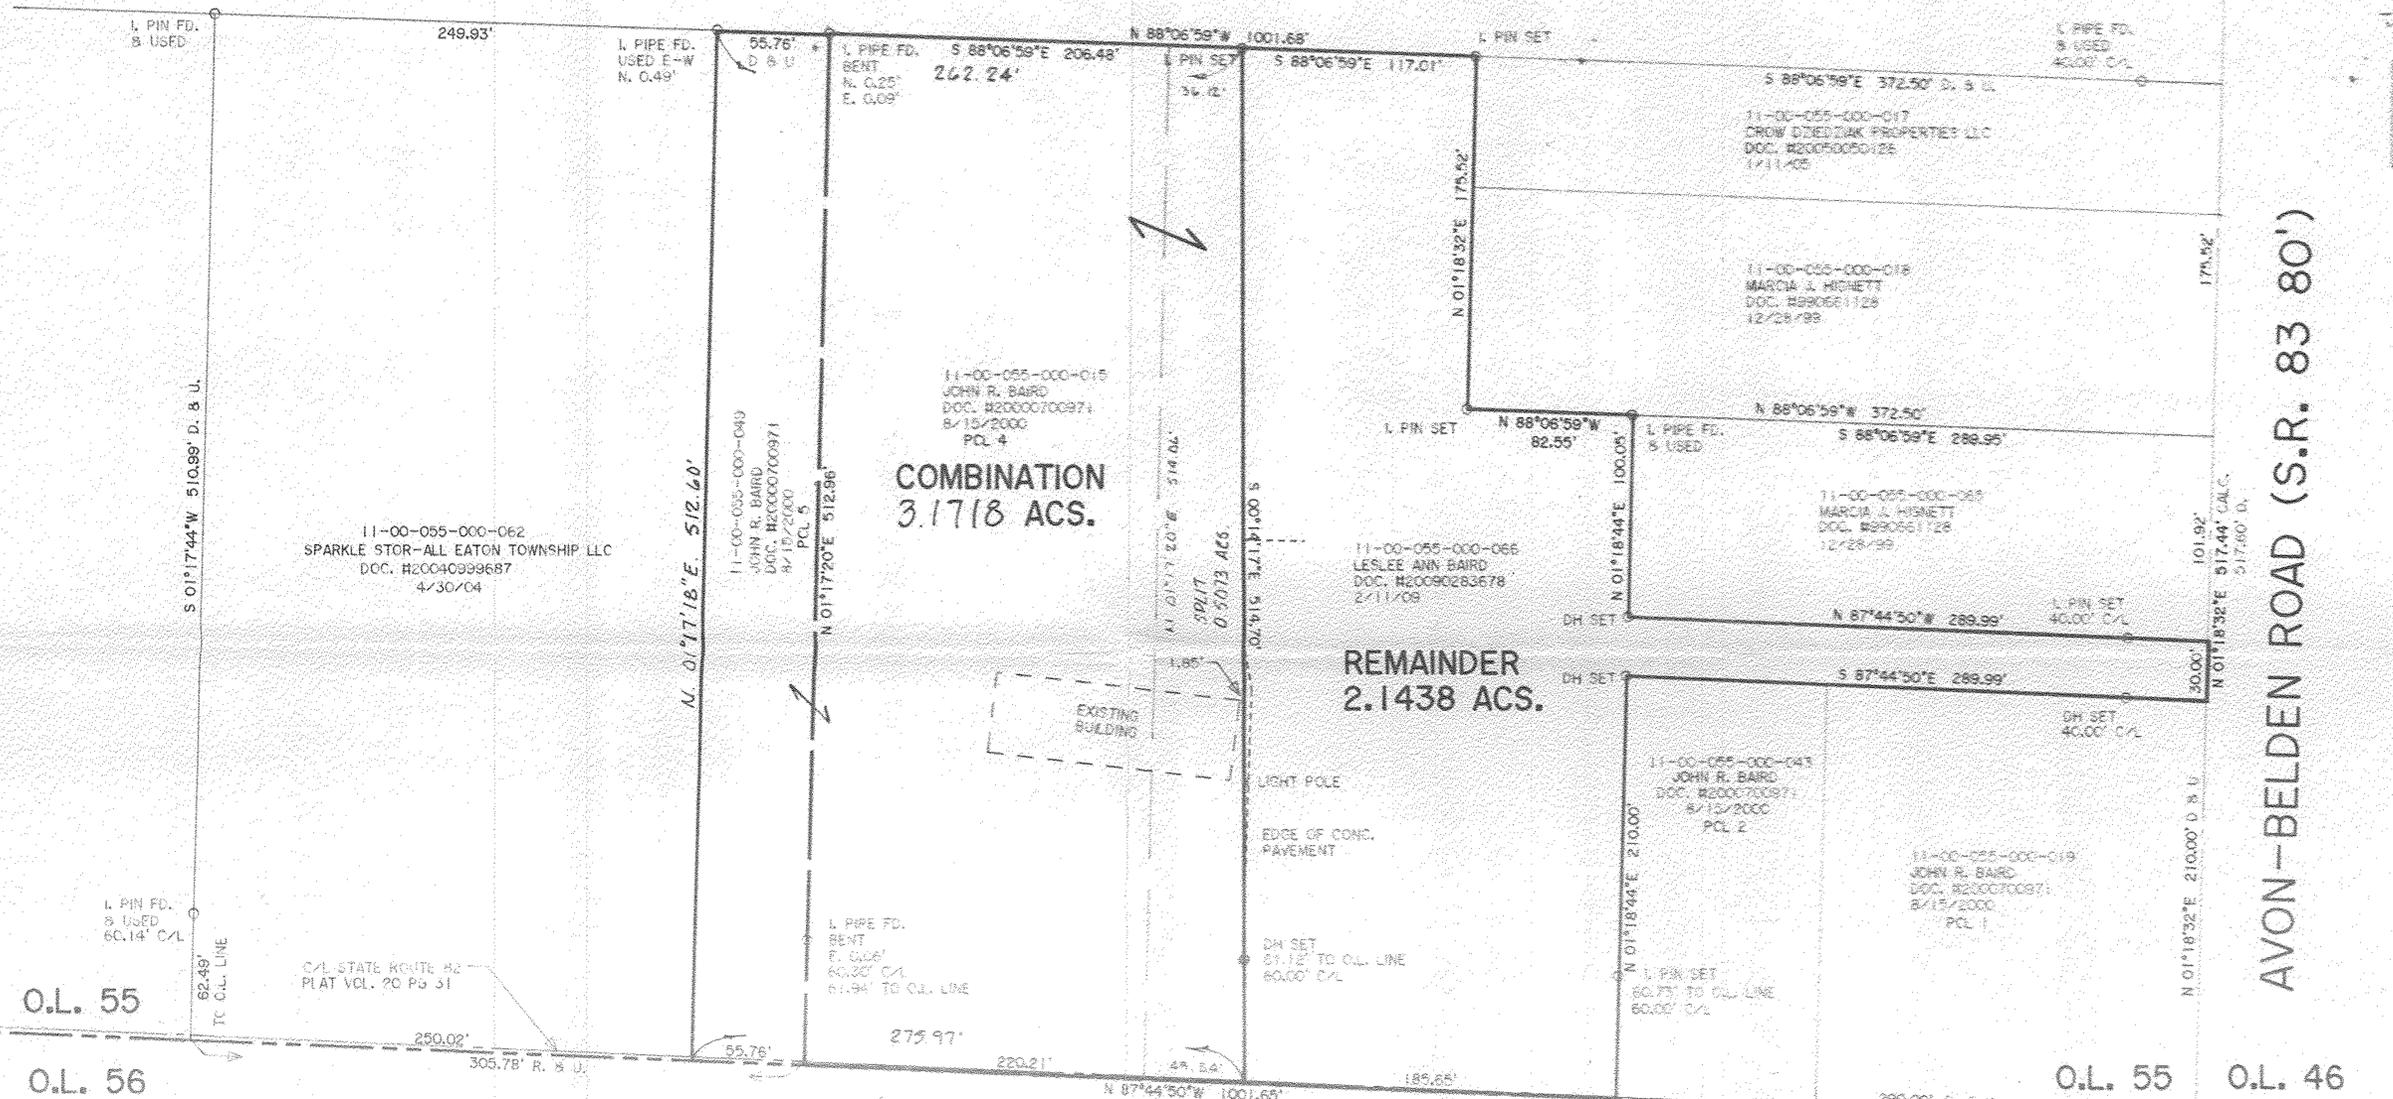

O.L. 55
O.L. 56

O.L. 55 O.L. 46
O.L. 56 O.L. 45

ELYRIA-TWINSBURG ROAD (S.R. 82, 120')


AVON-BELDEN ROAD (S.R. 83 80')

NAME OF BEARING IS THE CENTERLINE OF AVON-BELDEN ROAD (NORTH 01°18'32" EAST), IRON PINS SET ARE 5/8" DIAMETER, 30" LONG WITH PLASTIC CAPS T.T. SIMON, C-7775.

DIMENSIONS SHOWN ON THIS PLAT ARE EXPRESSED IN FEET AND DECIMAL PARTS THEREOF, ALL BEARINGS ARE TO AN ASSUMED MERIDIAN AND ARE USED TO INDICATE ANGLES ONLY. PERMANENT MONUMENTS WERE FOUND OR SET AT ALL POINTS INDICATED HEREON, ALL OF WHICH I CERTIFY TO BE CORRECT.

THOMAS SIMON & ASSOCIATES, INC.
PROFESSIONAL LAND SURVEYORS

150 SOUTH OLIVE STREET
ELYRIA, OHIO 44035
(440) 327-2925
FAX 327-2964

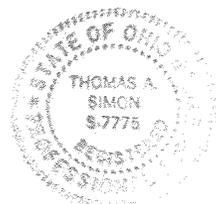

Thomas A. Simon
THOMAS A. SIMON
REG. PROFESSIONAL SURVEYOR
NO. S-7775

02802 ;
APPROVED
LORAIN CO.
MAP DEPT
DATE 2-17-10
11-00-055-000-046, 015, 049
PAGE 11-00-055-B
BY JWH/field
#10-07802

PLAT OF SURVEY
SPLIT & COMBINATION
FOR
JOHN BAIRD
LESLEE ANN BAIRD
BEING KNOWN AS PART OF ORIGINAL EATON TOWNSHIP
LOT NO. 55

COUNTY OF LORAIN STATE OF OHIO
NOVEMBER, 2009 SCALE: 1" = 60'