


12-00-064-A  
 12-00-064-101-001  
 -003  
 -029  
 -005  
 -006

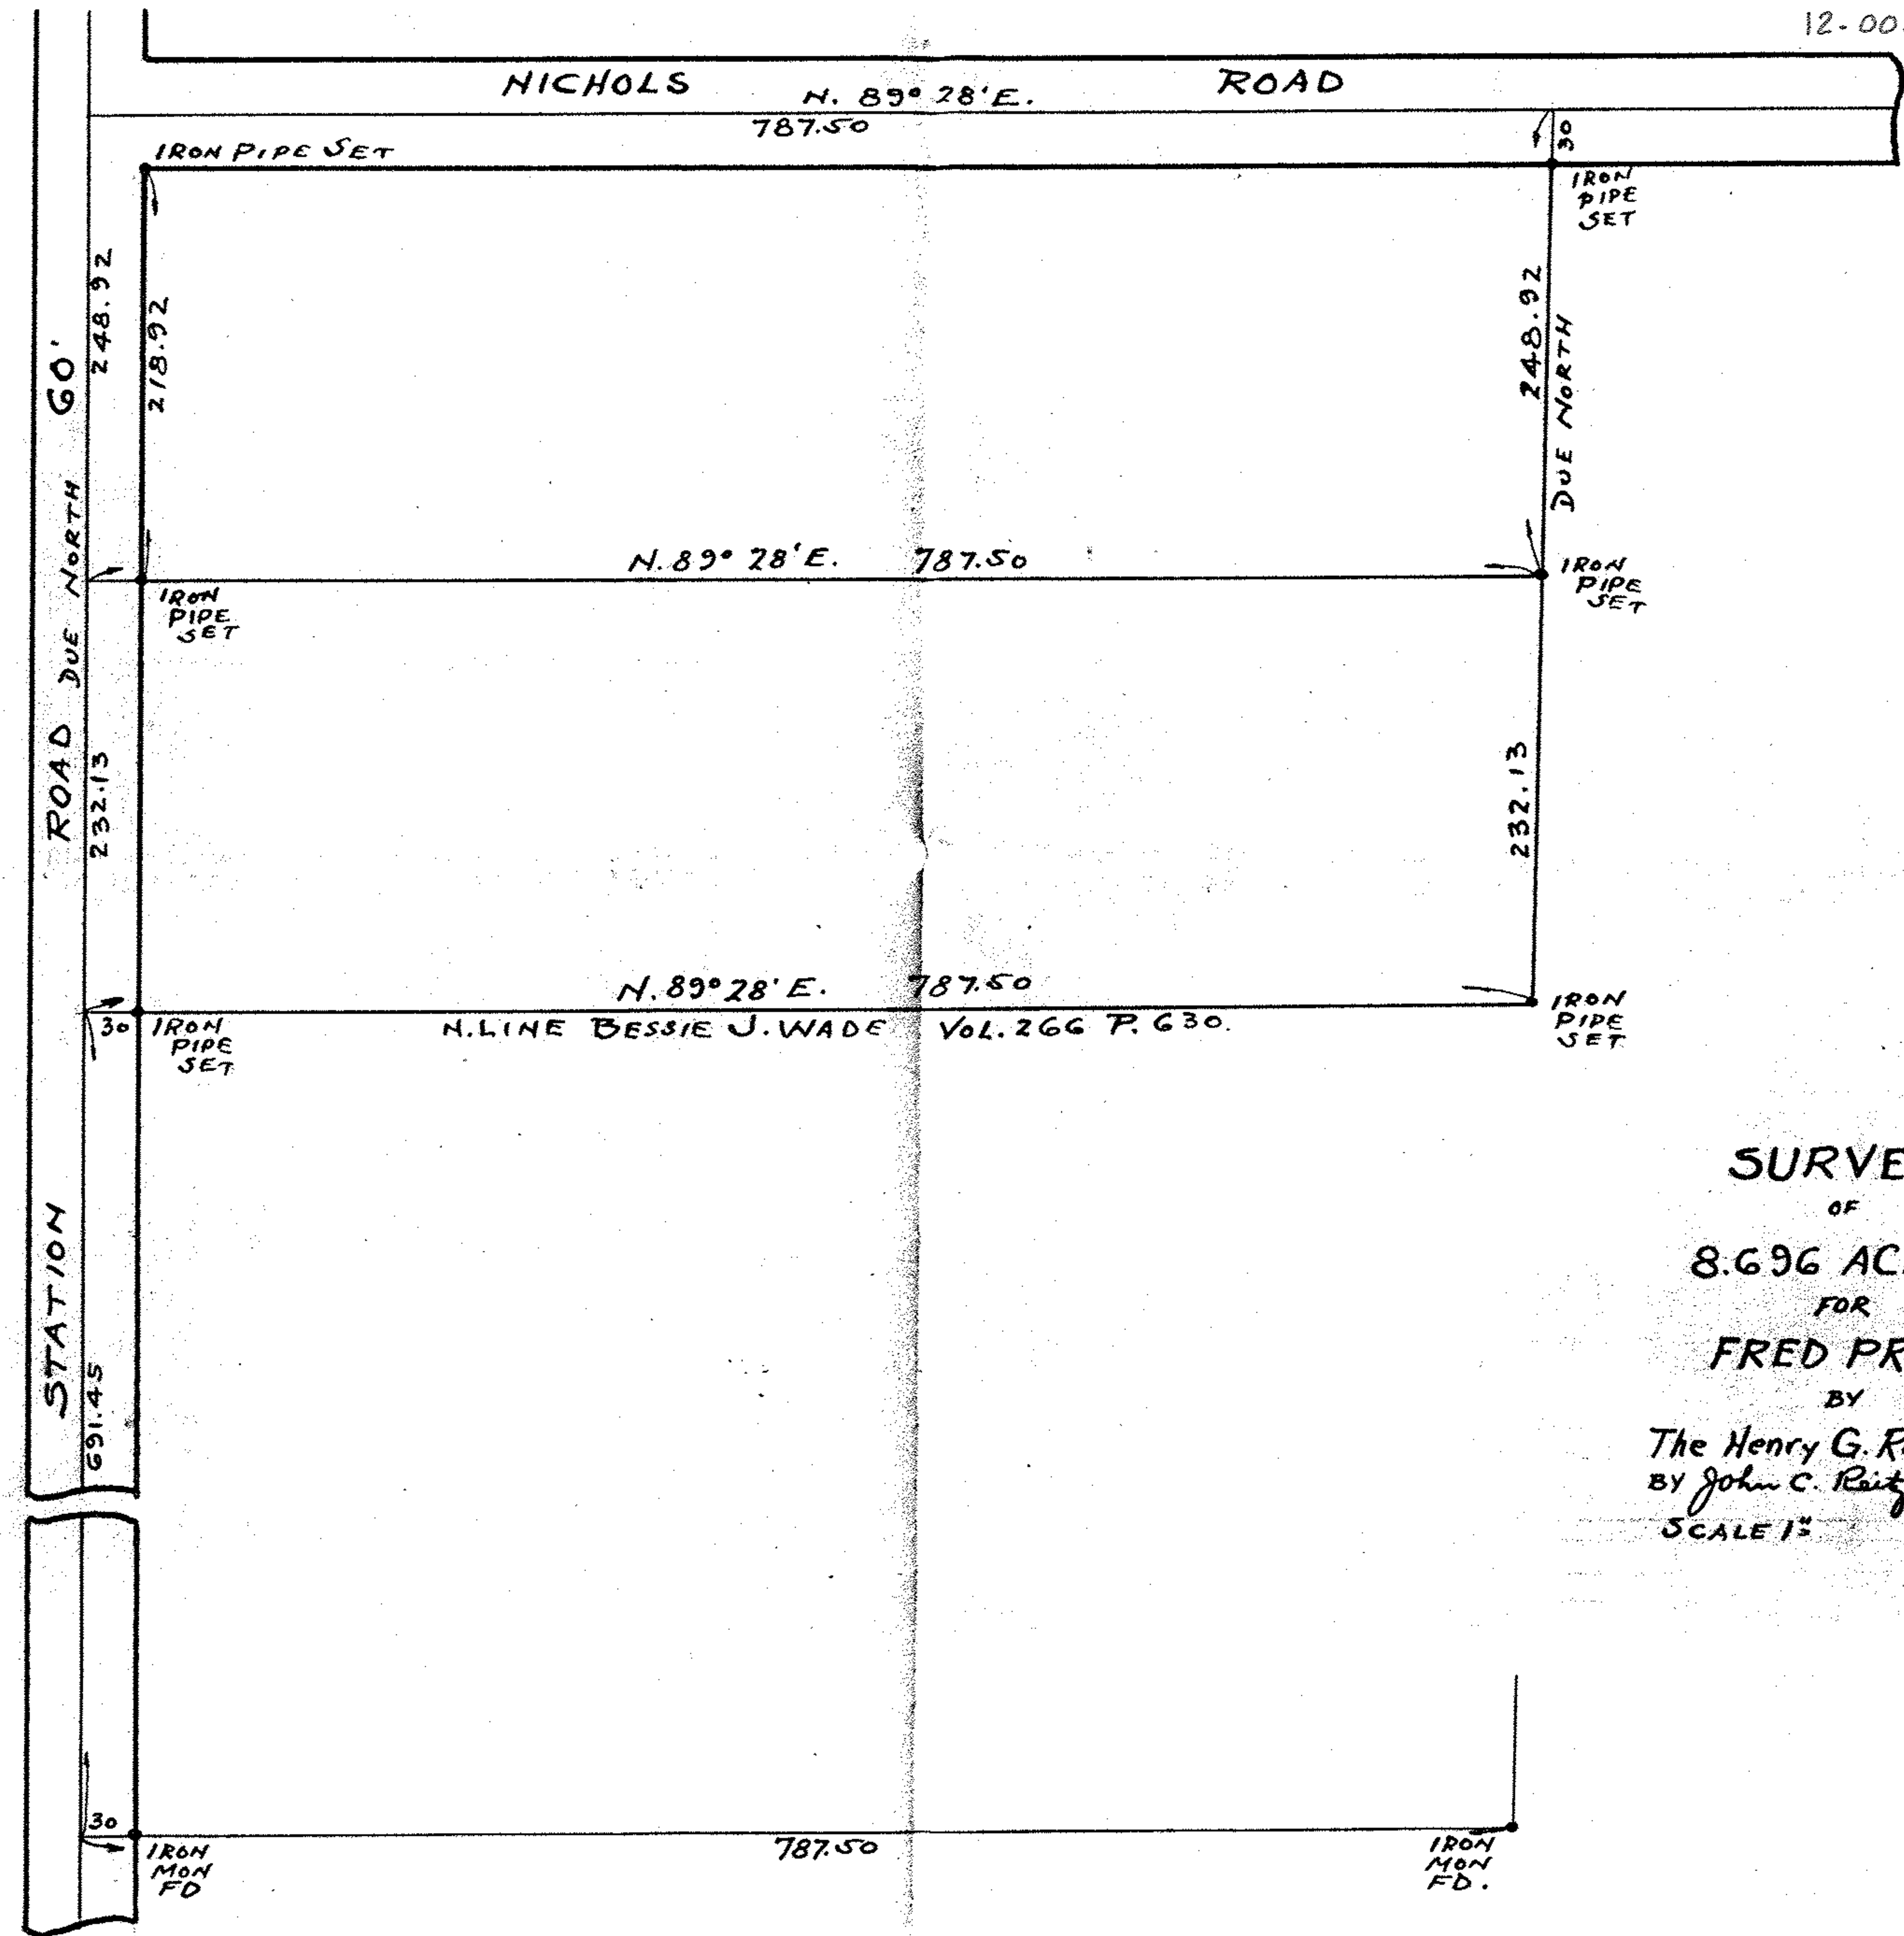

PPN 12-00-064-101-001  
 003  
 029  
 005  
 006  
 43874  
 MAP PG 1200-064-A

**SURVEY**  
 OF  
**8.696 ACRES**  
 FOR  
**FRED PROBST**  
 BY  
*The Henry G. Reitz Eng. Co.*  
 BY *John C. Reitz Sec'y & Treas*  
 SCALE 1" = OCT. 1943