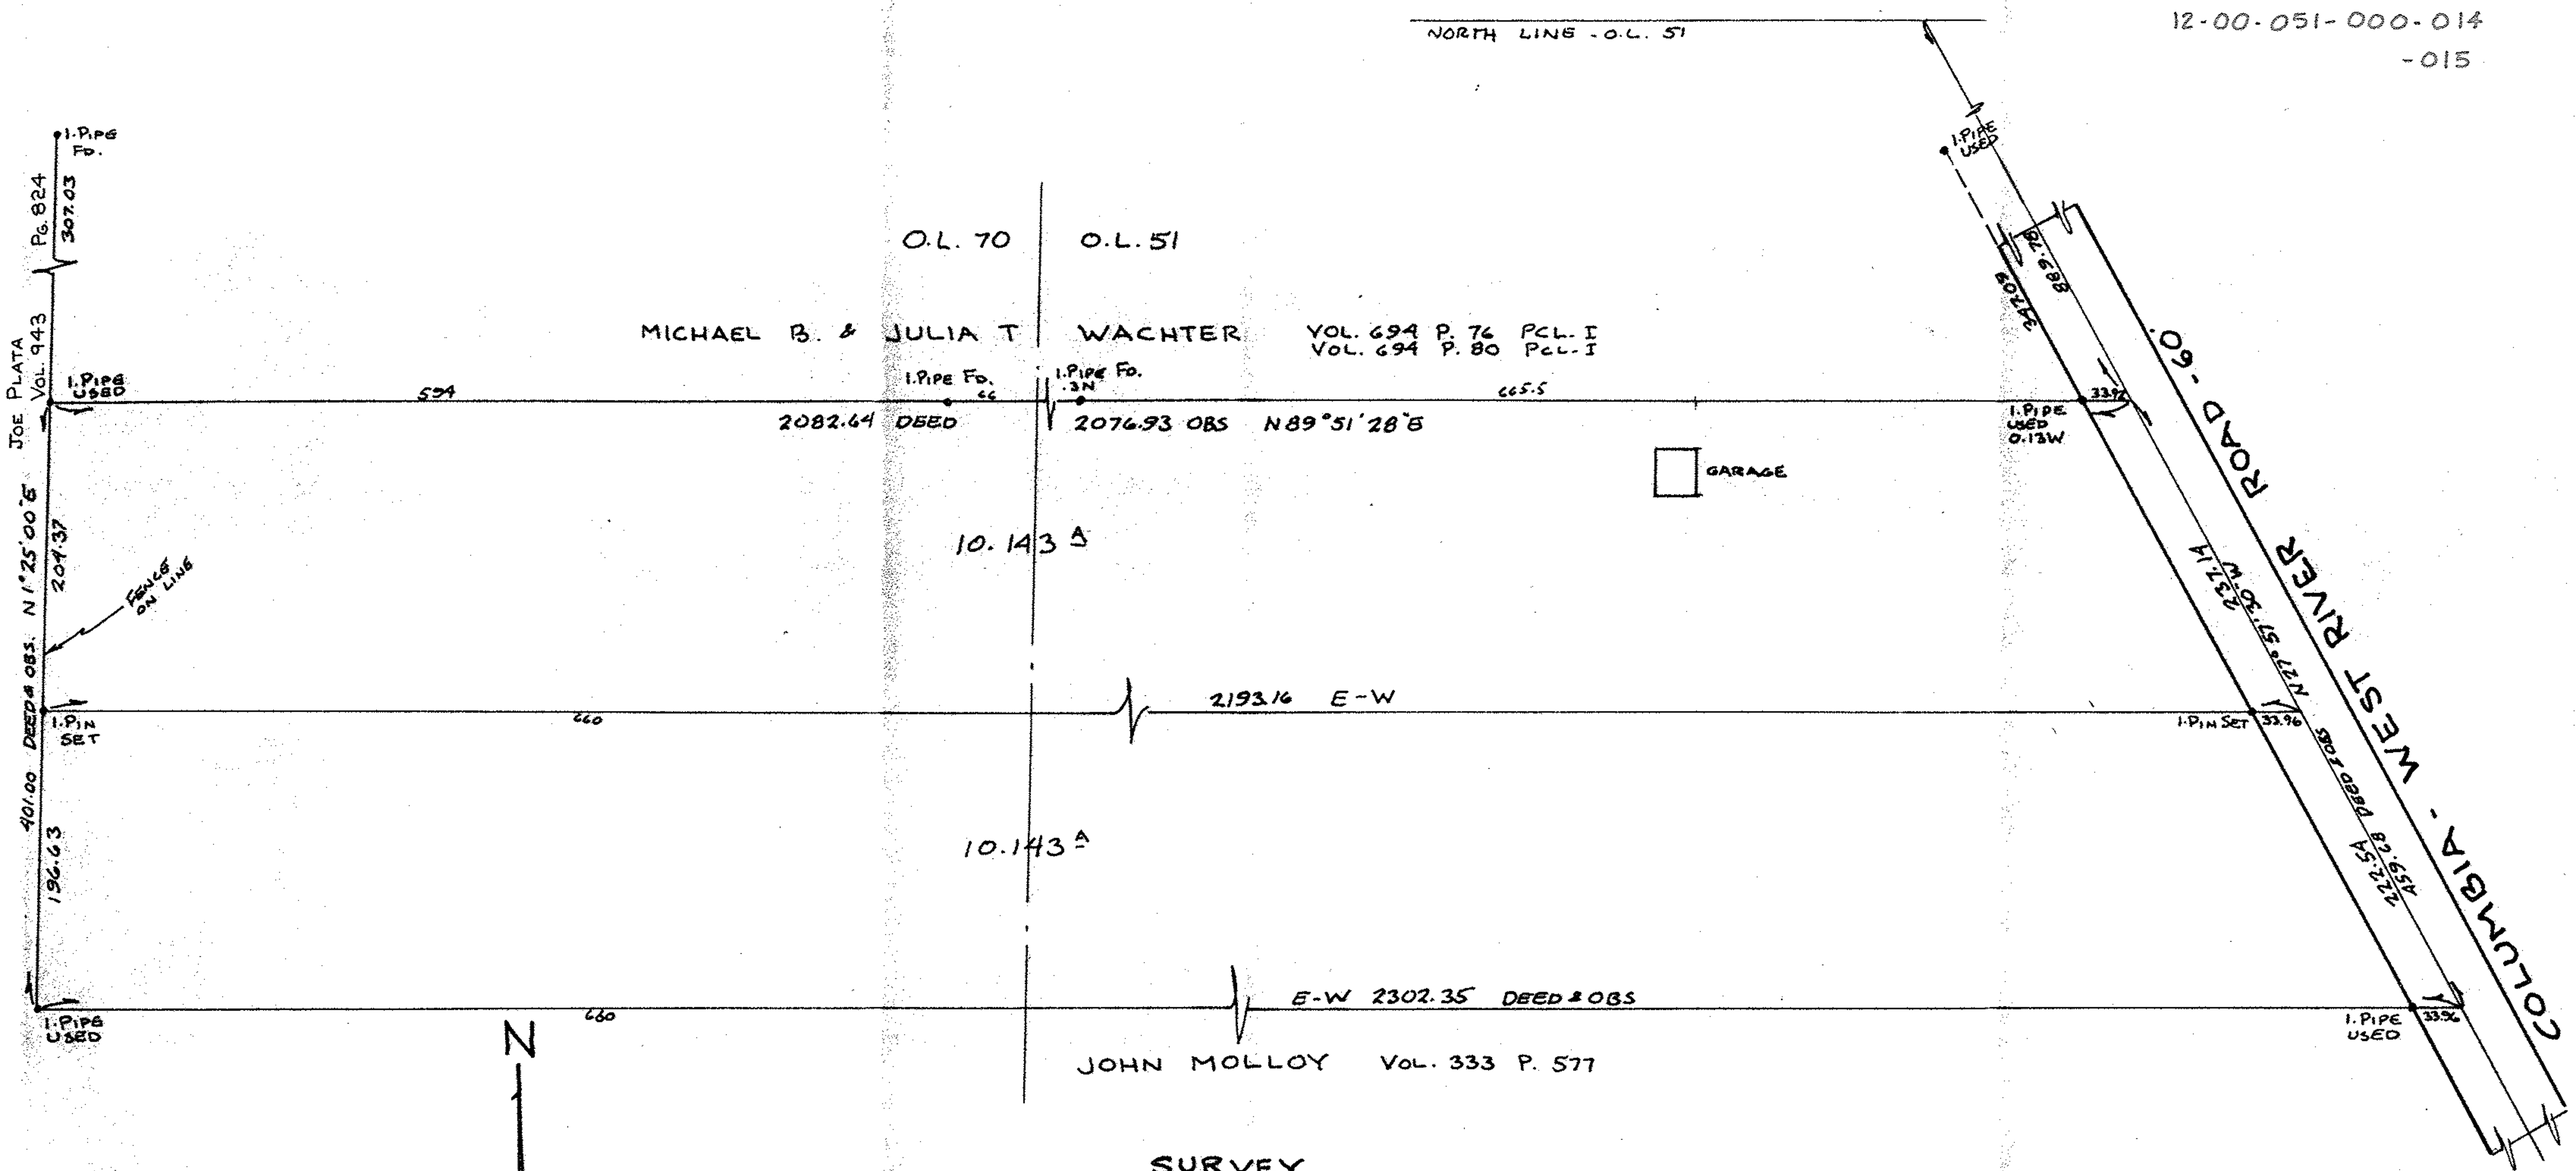

SURVEY
OF
2-10.143 A PARCELS
IN
COLUMBIA TWP. ORIG. LOTS 51 & 70
FOR
ROBERT KULOW
BY
THE HENRY G. REITZ ENG. CO.
BY John D. Seyler PRES
SCALE 1" = 100' JUNE 1969

PPN 12-00-051-000-014
015

MAP PG 12-F

43875