


12-00-039-B
12-00-039-000-015
12-00-022-A
12-00-022-000-001

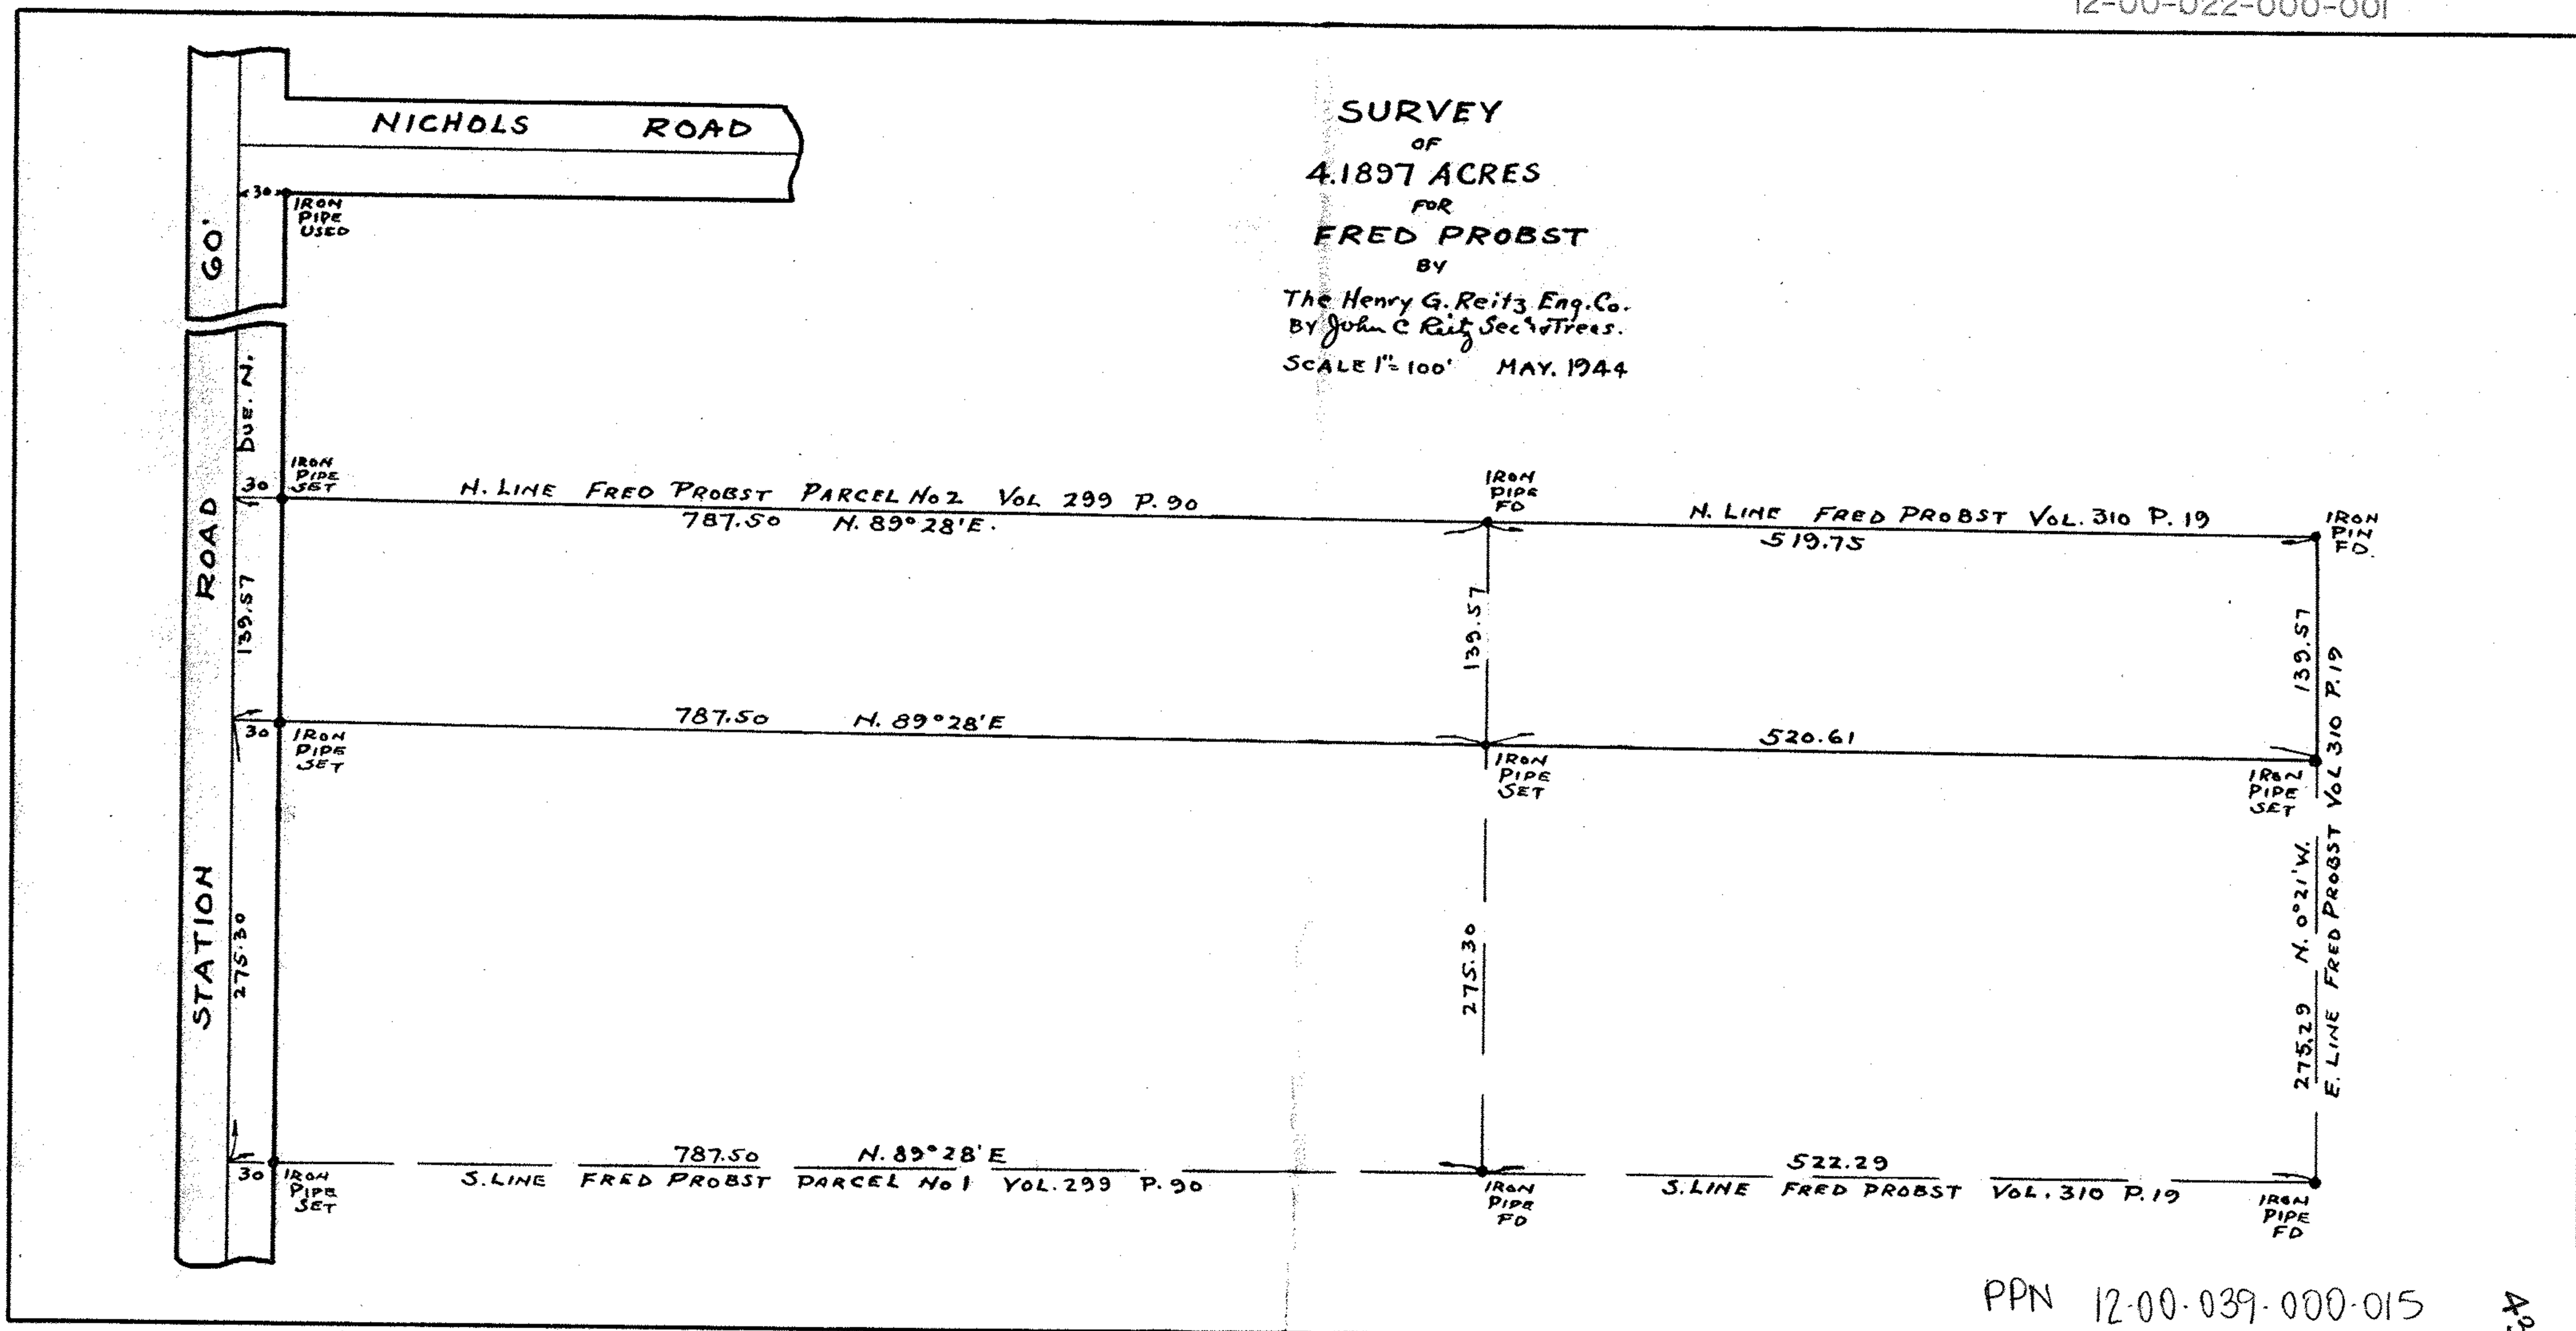

SURVEY
OF
4.1897 ACRES
FOR
FRED PROBST
BY
The Henry G. Reitz Eng. Co.
BY John C. Reitz Sec'y & Treas.
SCALE 1" = 100' MAY, 1944

PPN 12-00-039-000-015
12-00-022-000-001

MAP pg 12-00-039-B
022-A

430891