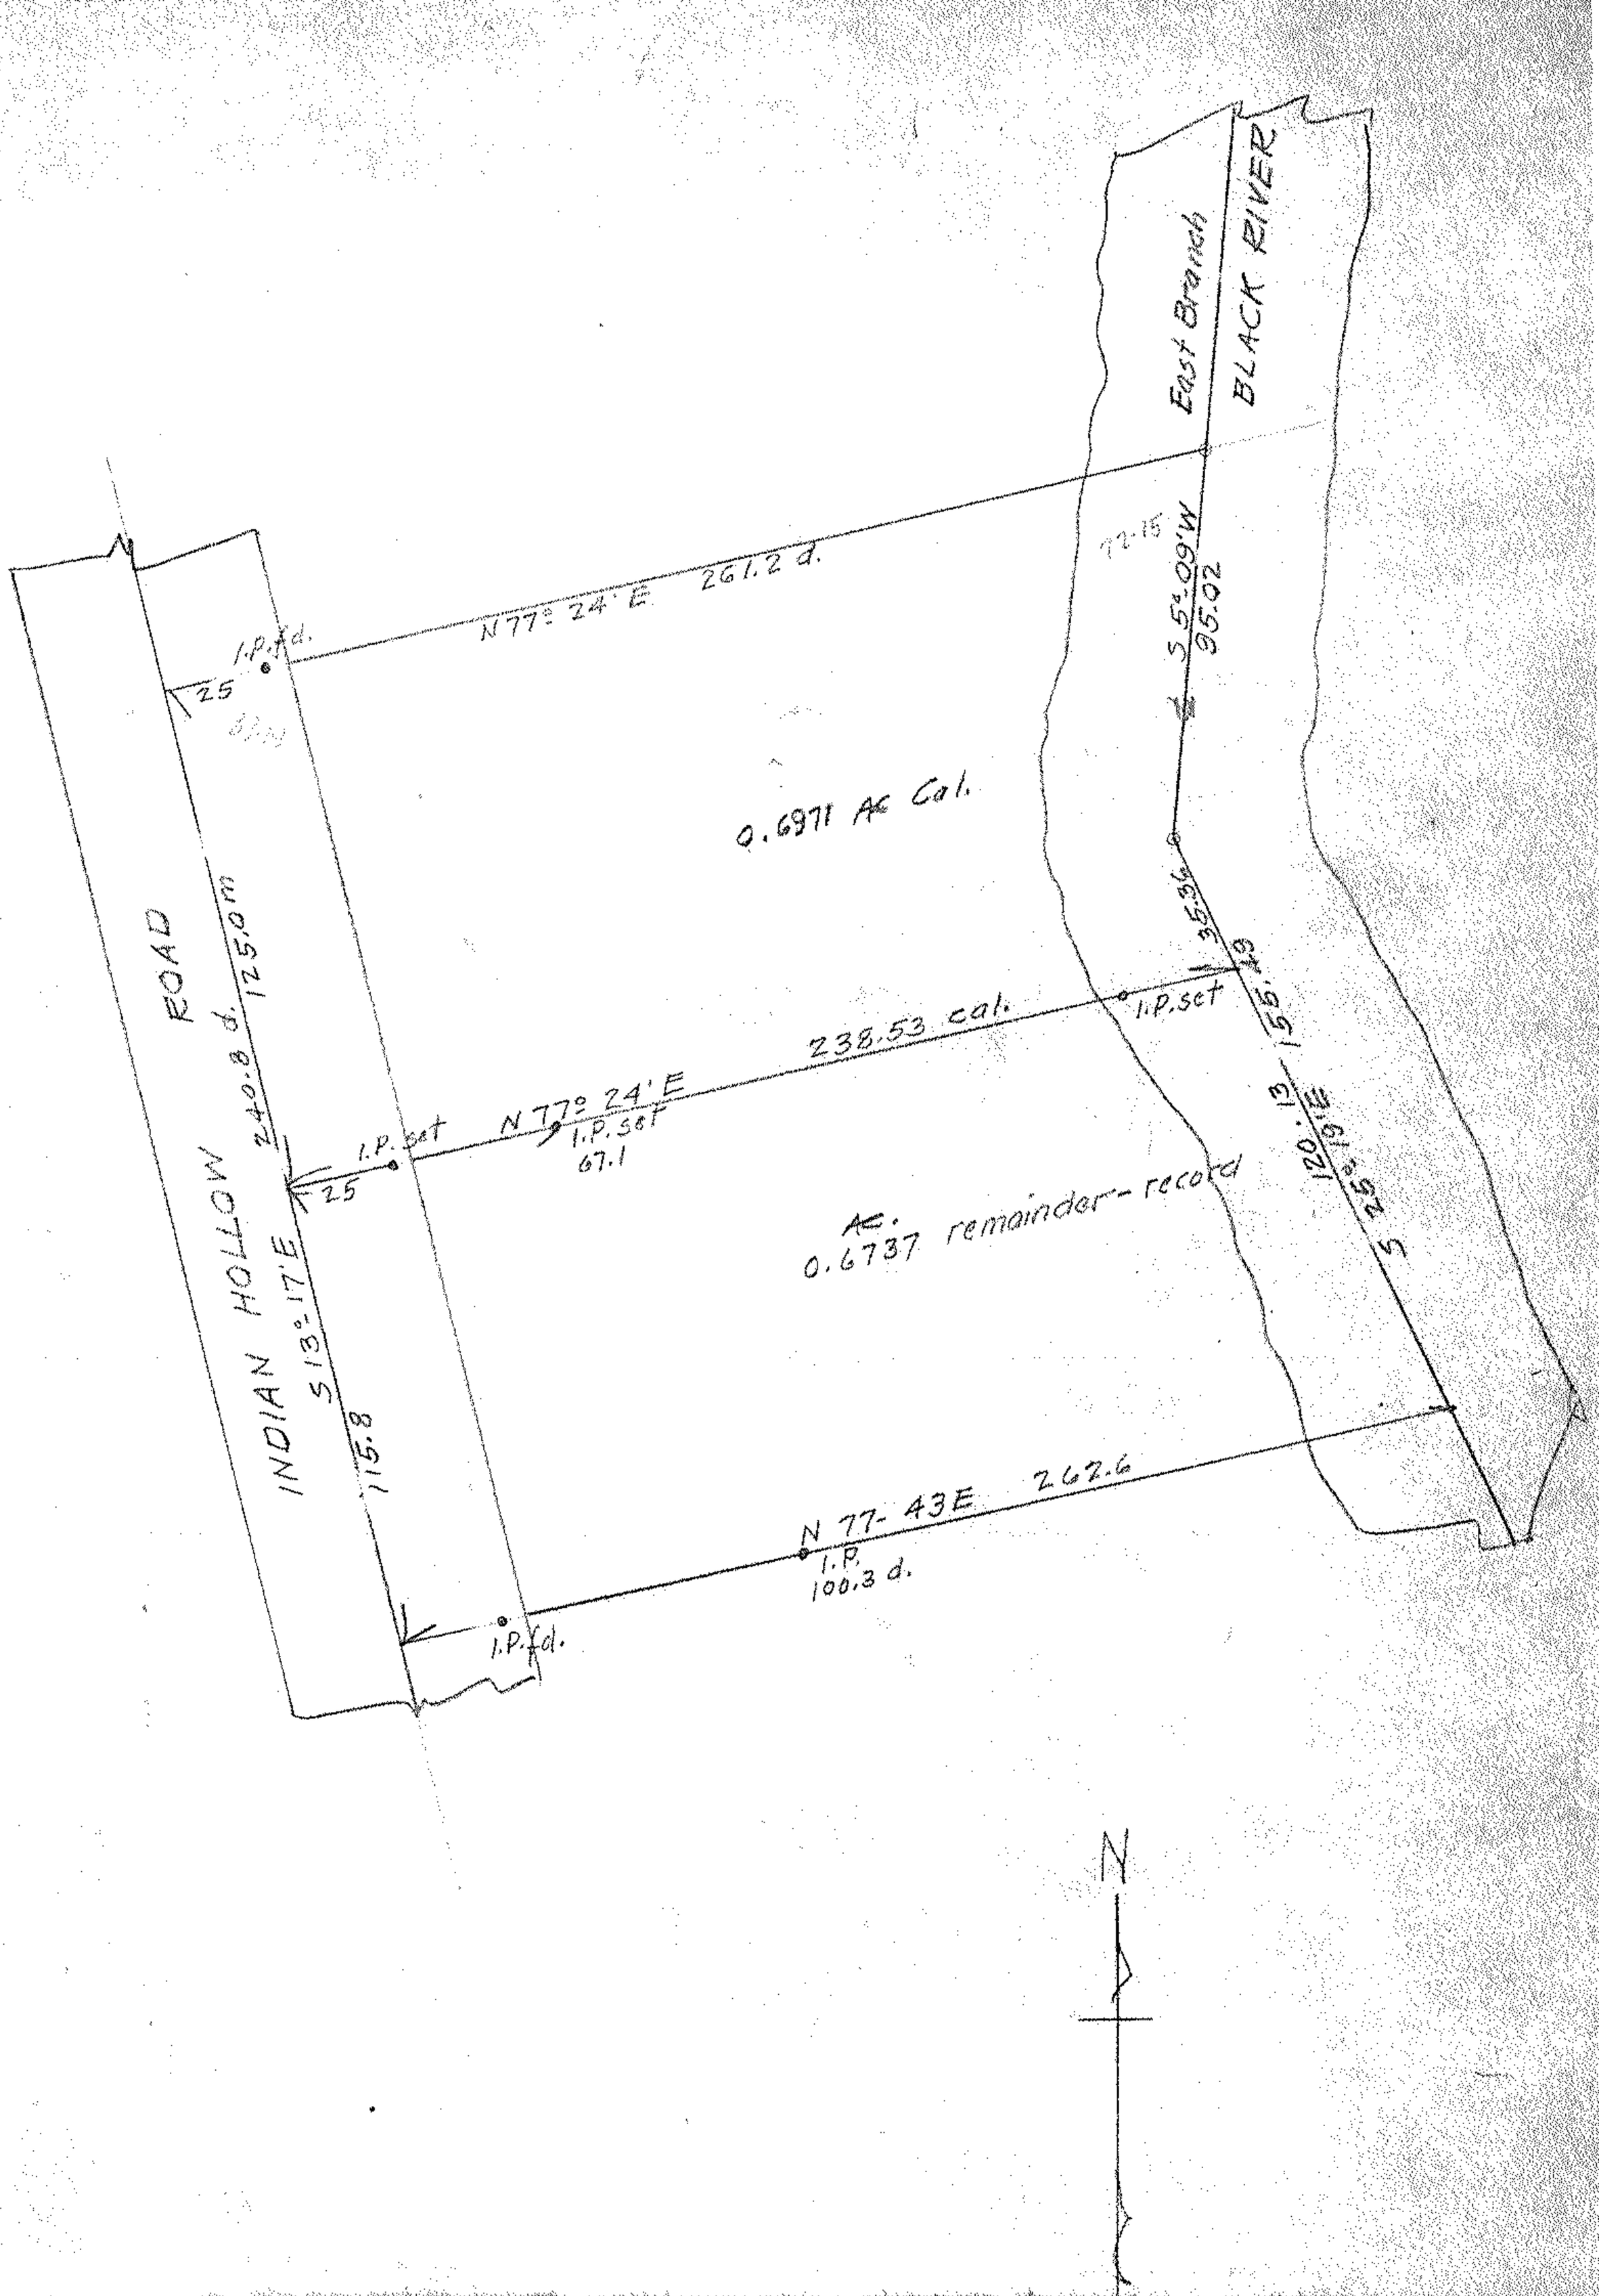

SURVEY FOR MARTIN PETRUZZI
PART OF SECTION 25 CARLISLE TWP.
LORAIN CO. OHIO SCALE 1"=50'
MAR, 25, 53 T.W. LAUNDON REG. SURVEYOR.