10-00-012-D

10-00-012-000

PPN 10-00-012-000-???

MAP PG 10-00-012-D 43927

CWB 2

PREPARED FOR
LORAIN COUNTY METROPOLITAN PARK BOARD
CARLISLE TWP.
SECT. 12
LORAIN CO. OHIO

Prepared by
JAMES H. SCHMIDT
Registered Surveyor
307 Robinson Bldg., Elyria, O.

DATE: OCT. 21, 1968 SCALE: 1" = 100'

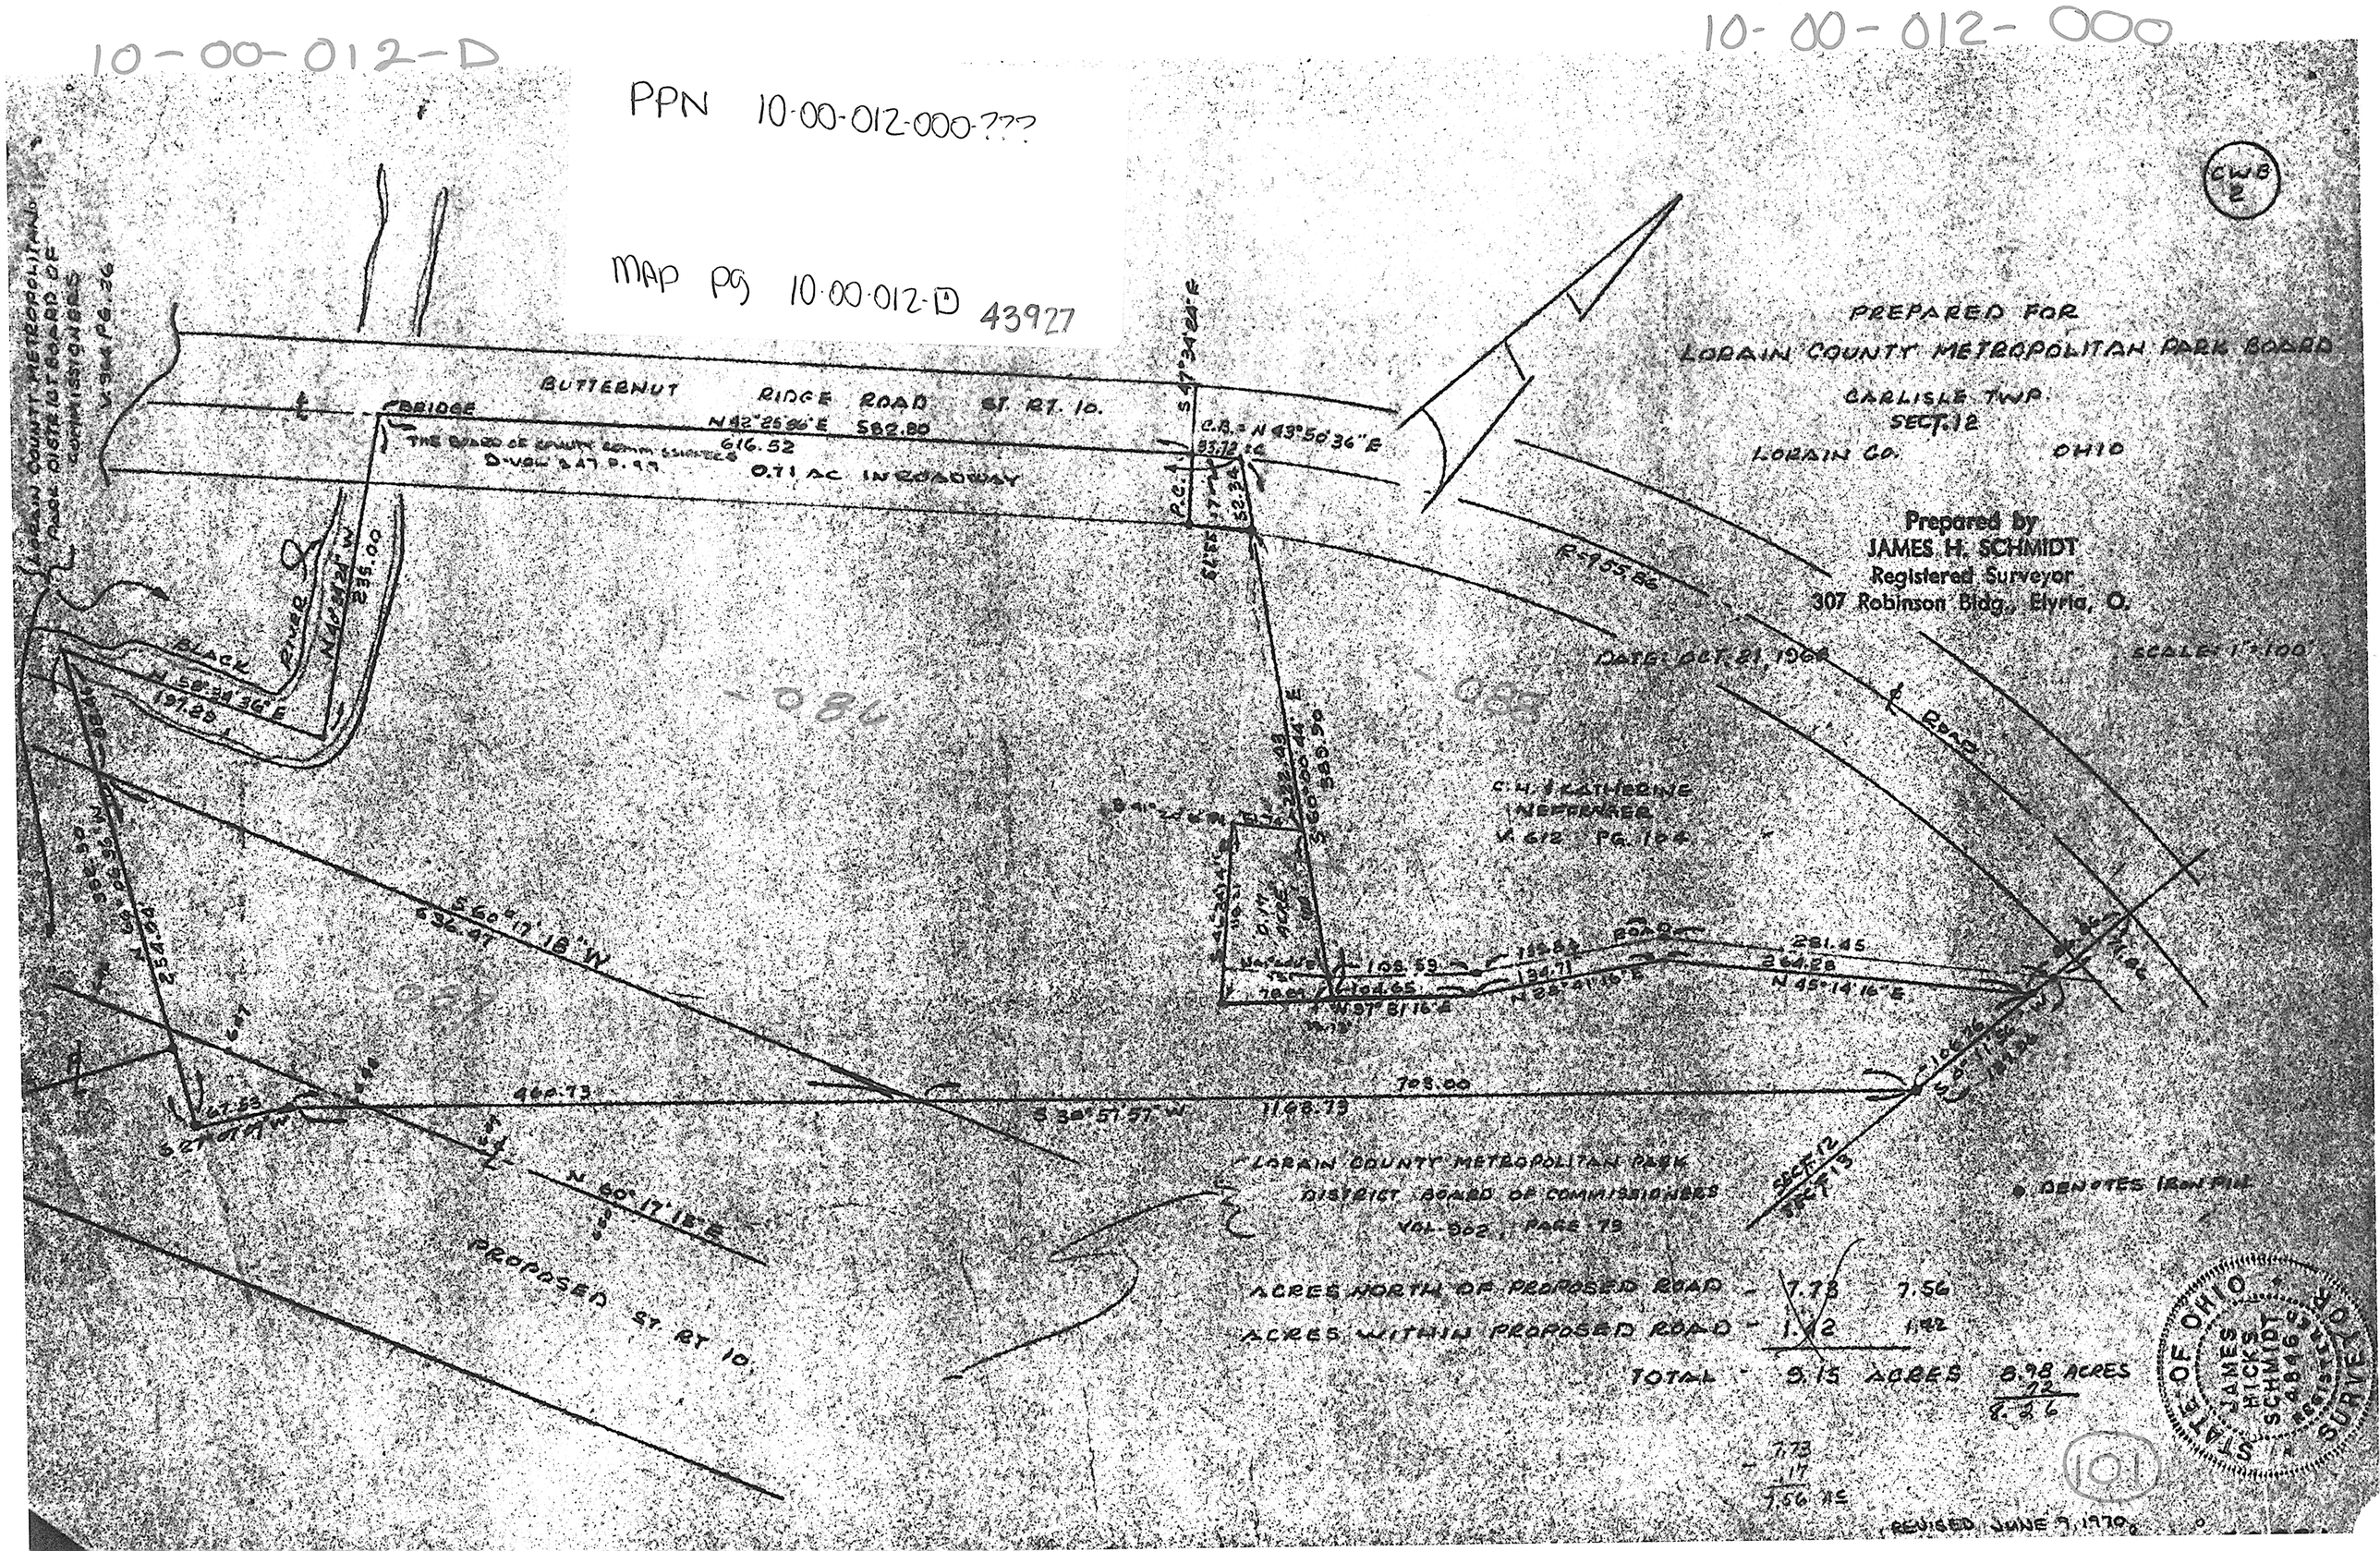

ACRES NORTH OF PROPOSED ROAD - ~~7.73~~ 7.56

ACRES WITHIN PROPOSED ROAD - ~~1.12~~ 1.42

TOTAL 9.15 ACRES 8.98 ACRES
.12
8.86

7.73
.17
7.56 AC

STATE OF OHIO
JAMES HICKS SCHMIDT
REGISTERED SURVEYOR

REVISED JUNE 9, 1970

10-1