PREPARED FOR: LORAIN COUNTY METROPOLITAN PARK BOARD

CWB 6

CARLISLE TOWNSHIP
O.L. 20 12
LORAIN COUNTY, OHIO

Prepared by
JAMES H. SCHMIDT
Registered Surveyor
307 Robinson Bldg., Elyria, O.

AUG. 12, 1968 1"=100'

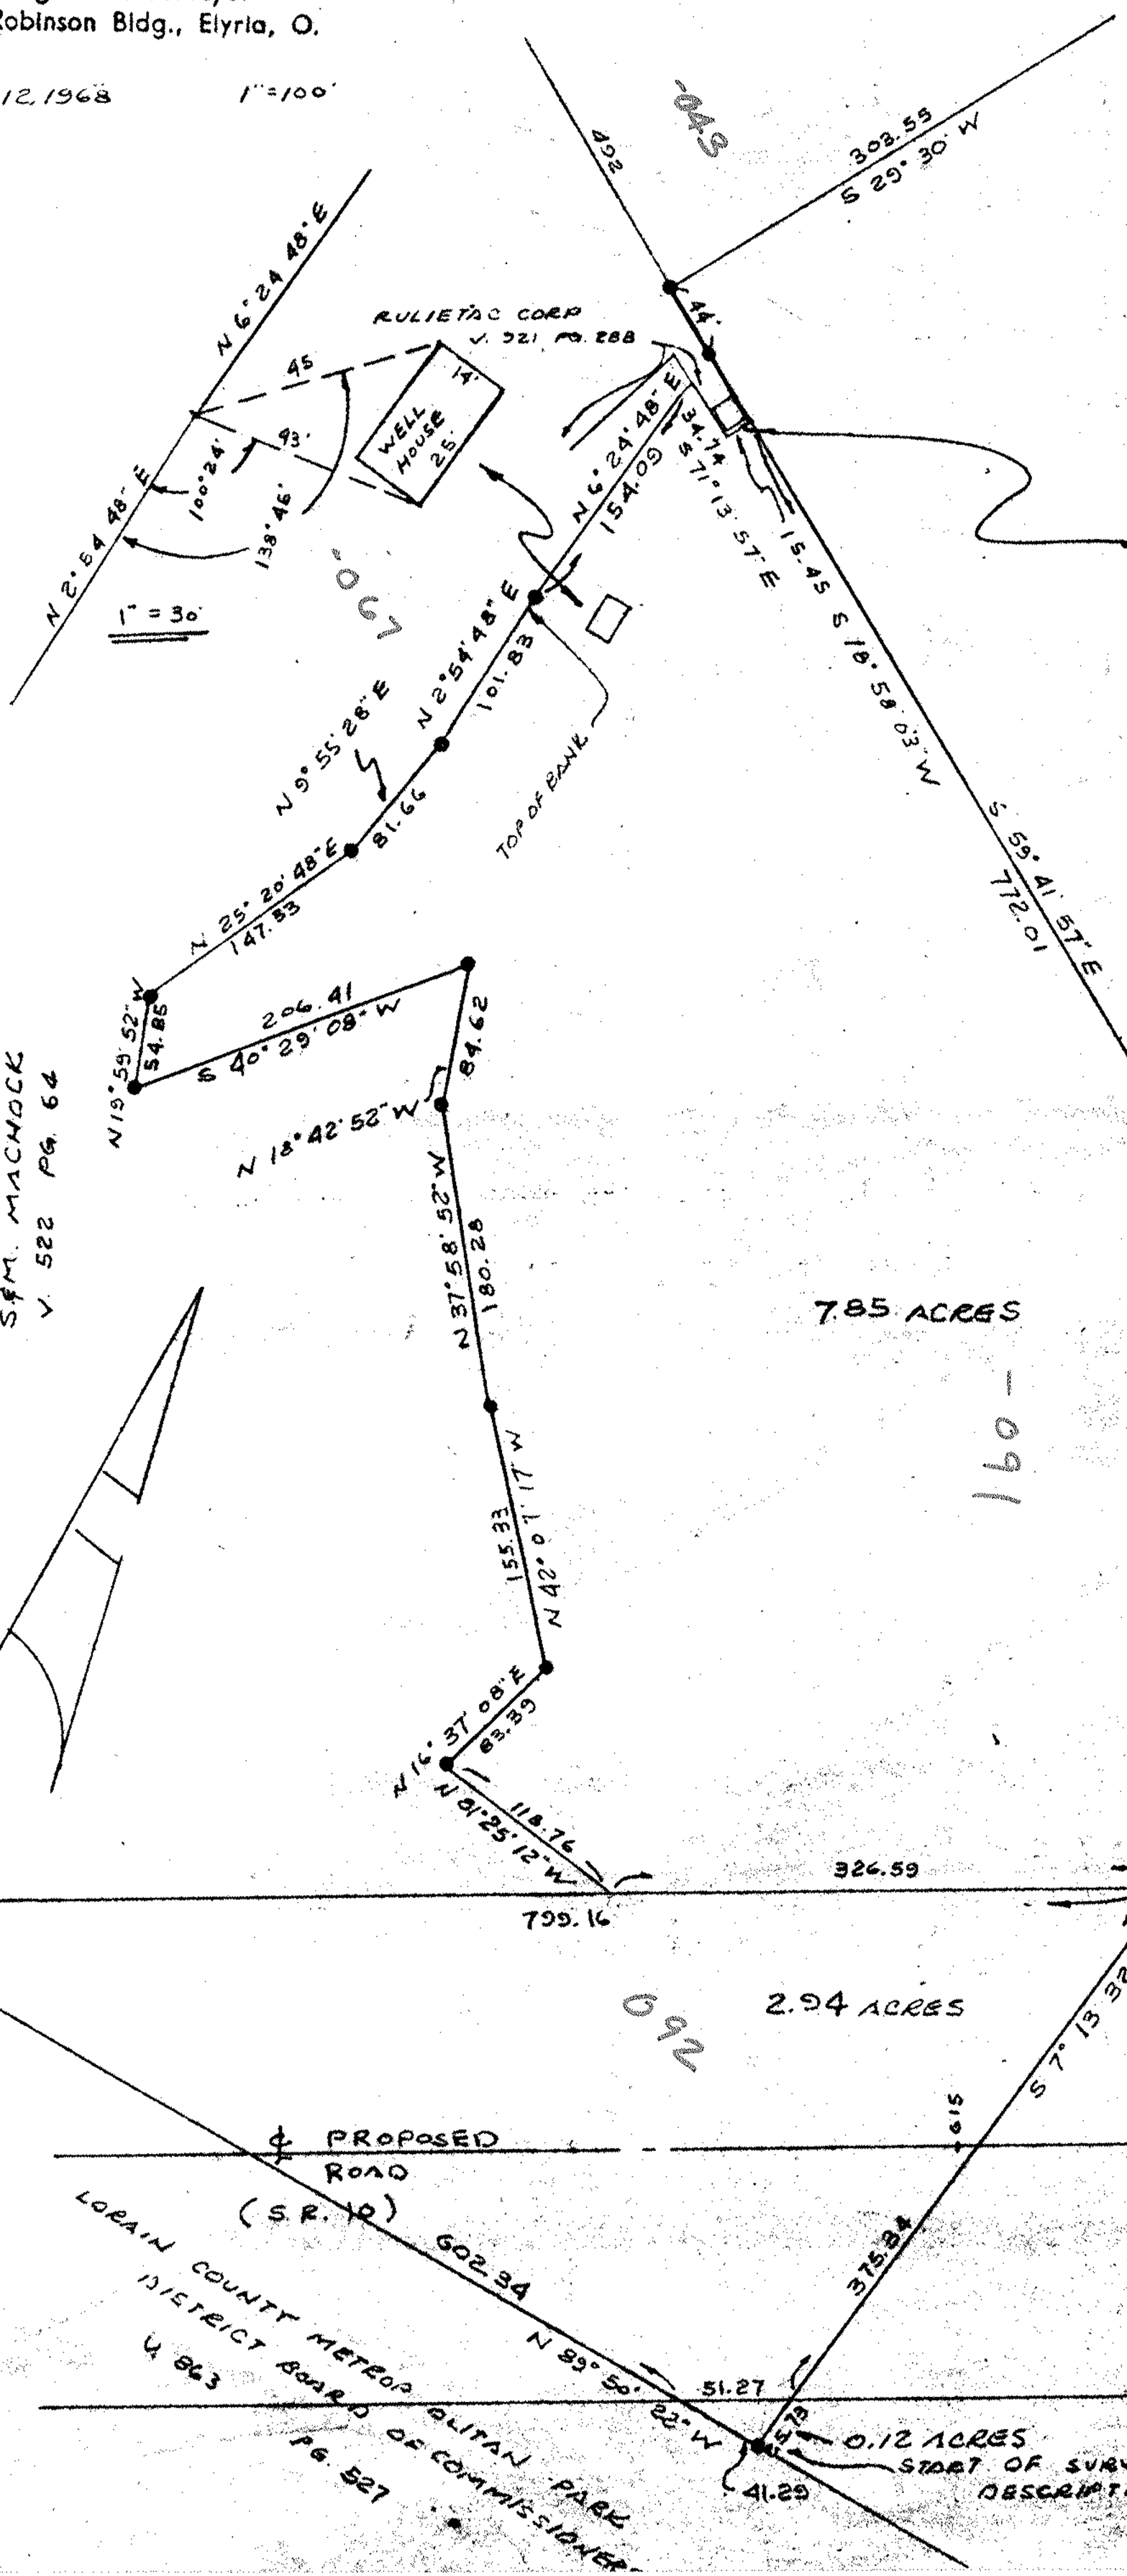

PELTER CWB 6

10-00-012-51

10-00-012-21

10-00-012-01