10-00-007-102-
10-00-00

PPN 10·00·007-102·004
Map Pg 10·00·007-D
43937

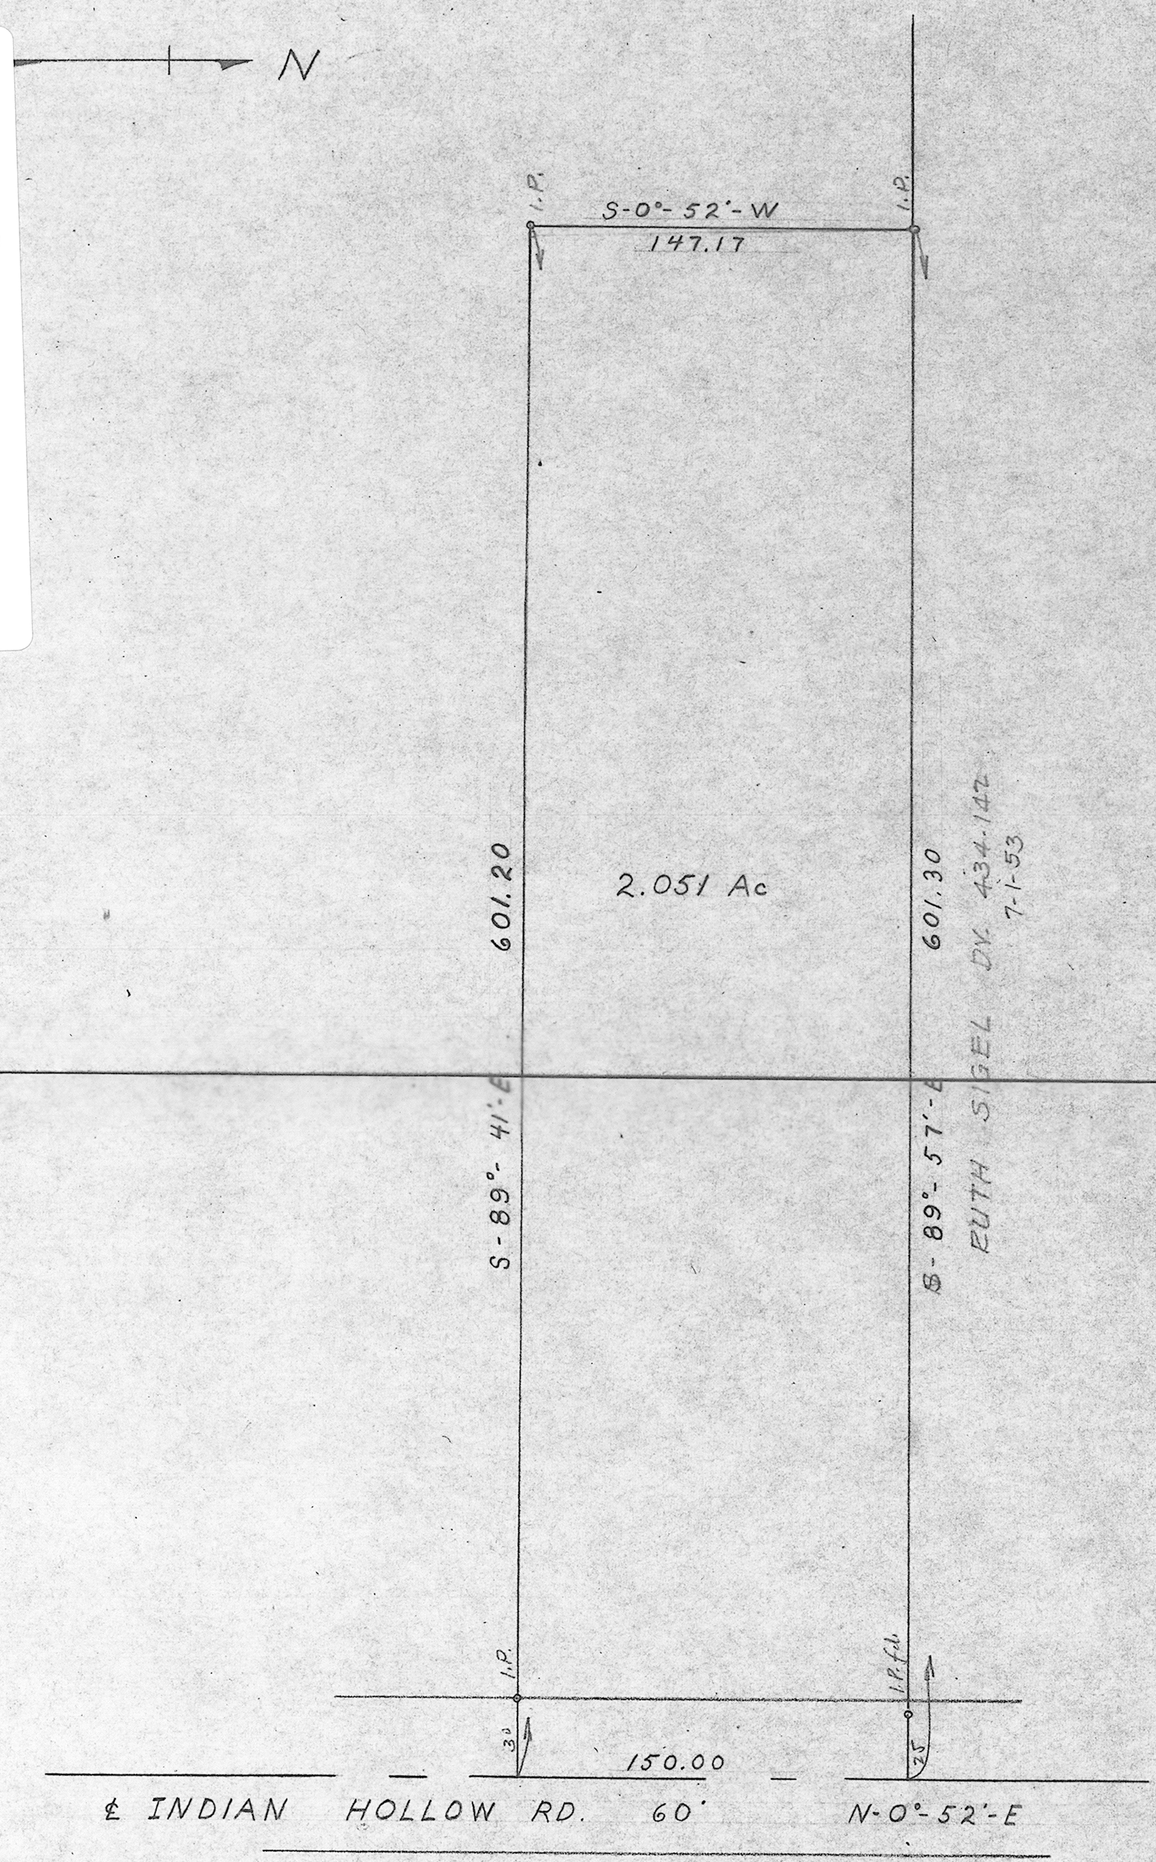

SURVEY FOR ORWOOD & MARILYN
OFFENBERG. PART OF O.L. 7
CARLISLE TWNP. LORAIN CO. OHIO
SCALE 1" = 60' AUGUST 1956
T.W. LAUNDON REG. SURVEYOR

FB 18 PG 32