Map Pg 10-00-006-H
43938

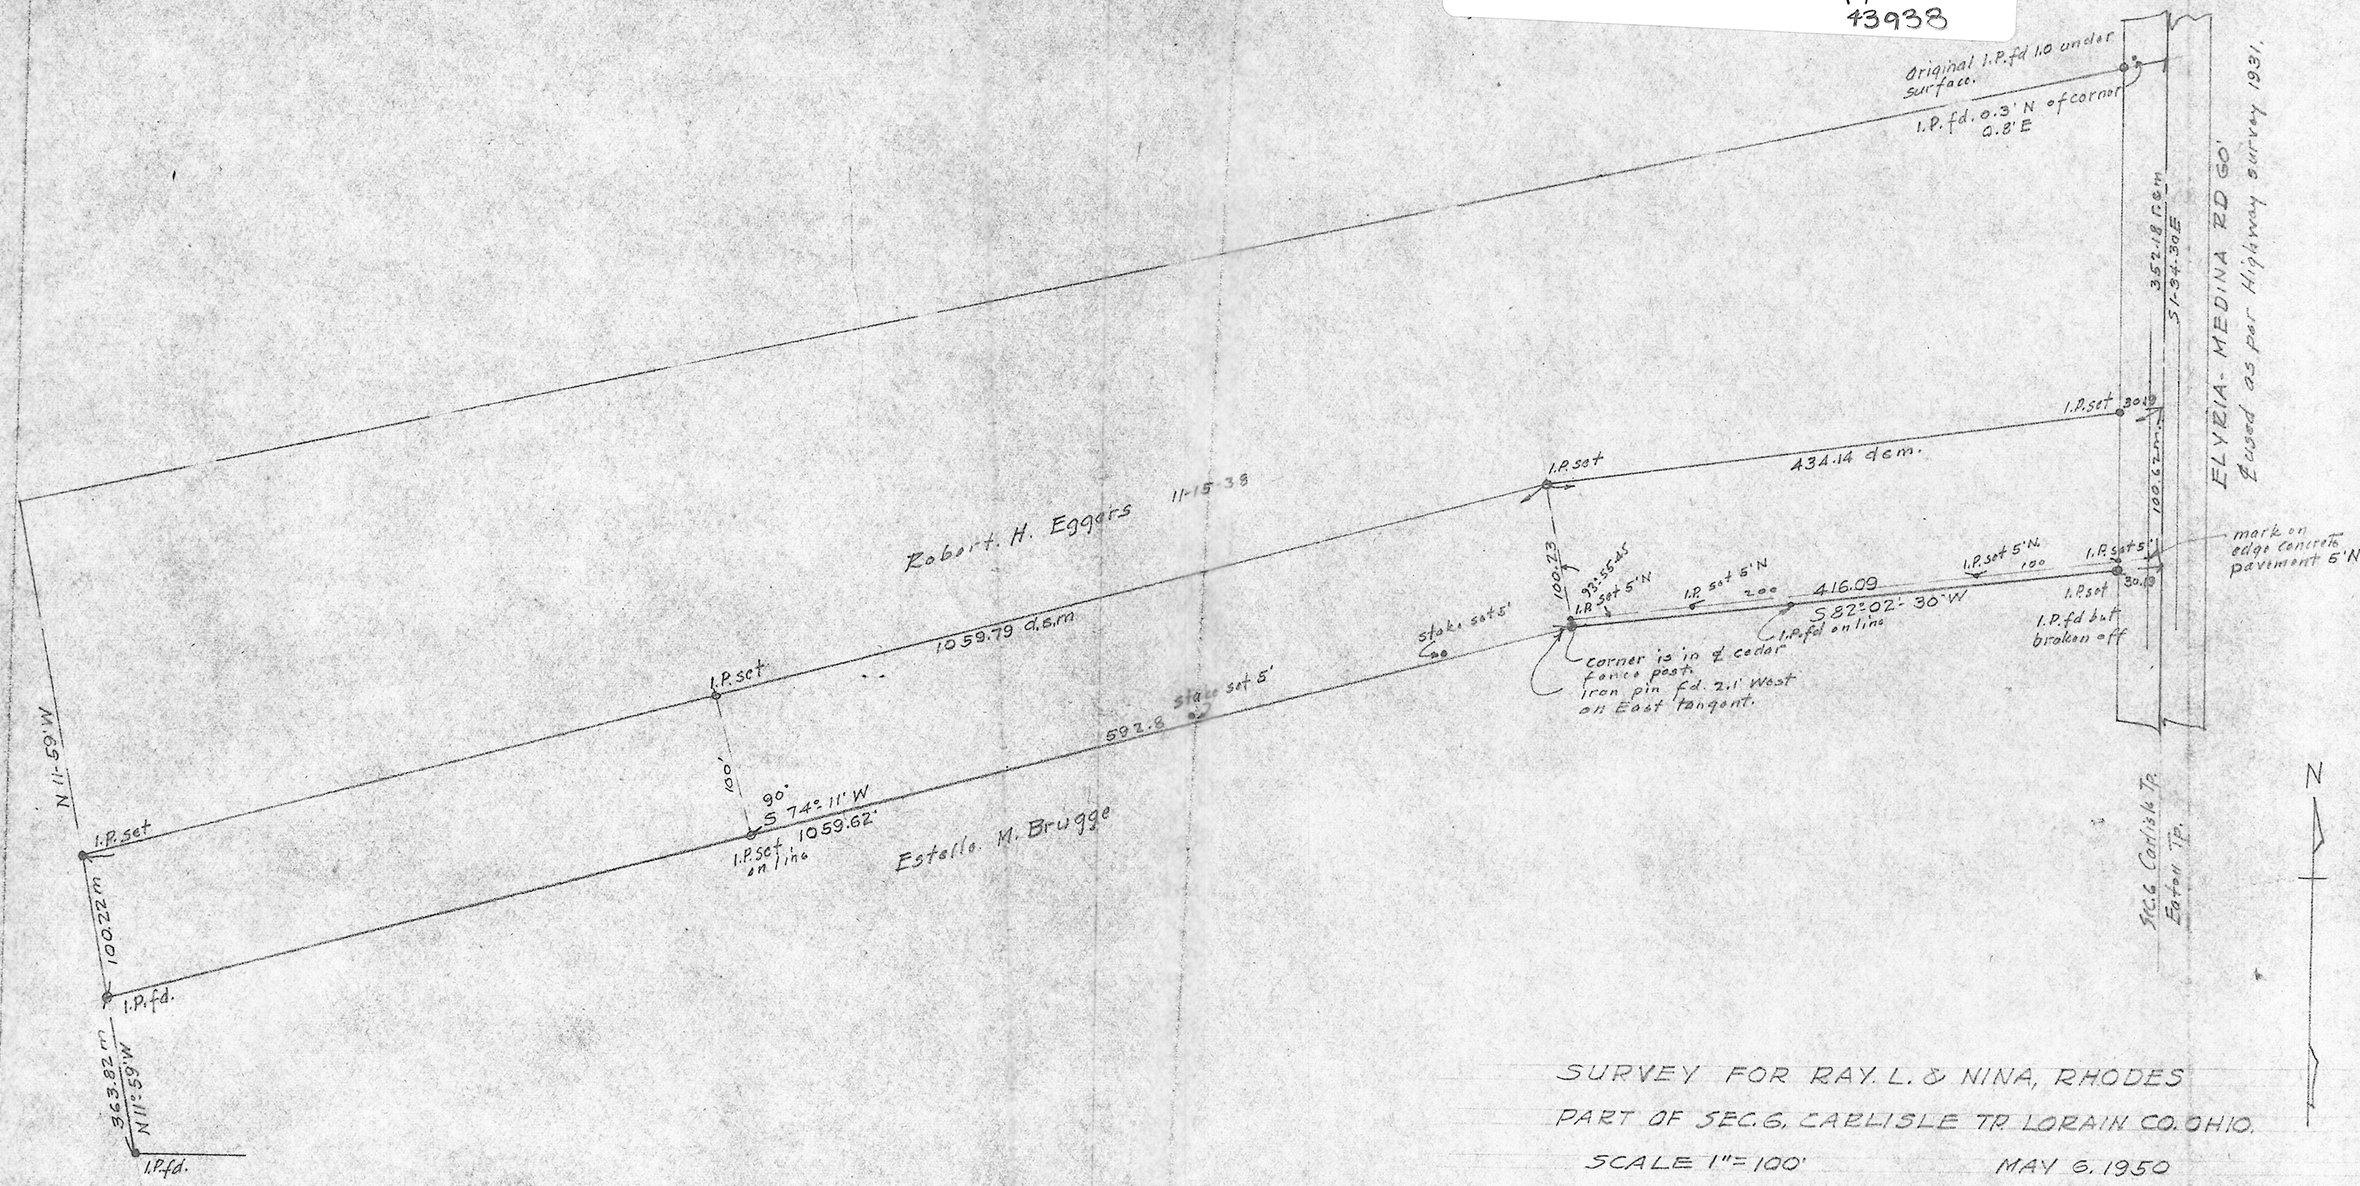

SURVEY FOR RAY. L. & NINA, RHODES

PART OF SEC. 6, CARLISLE TR. LORAIN CO. OHIO.

SCALE 1" = 100' MAY 6, 1950

T.W. LAUNDON REGISTERED SURVEYOR

FB 79 PG 29

3