9-00-085-112

9-00-085-B

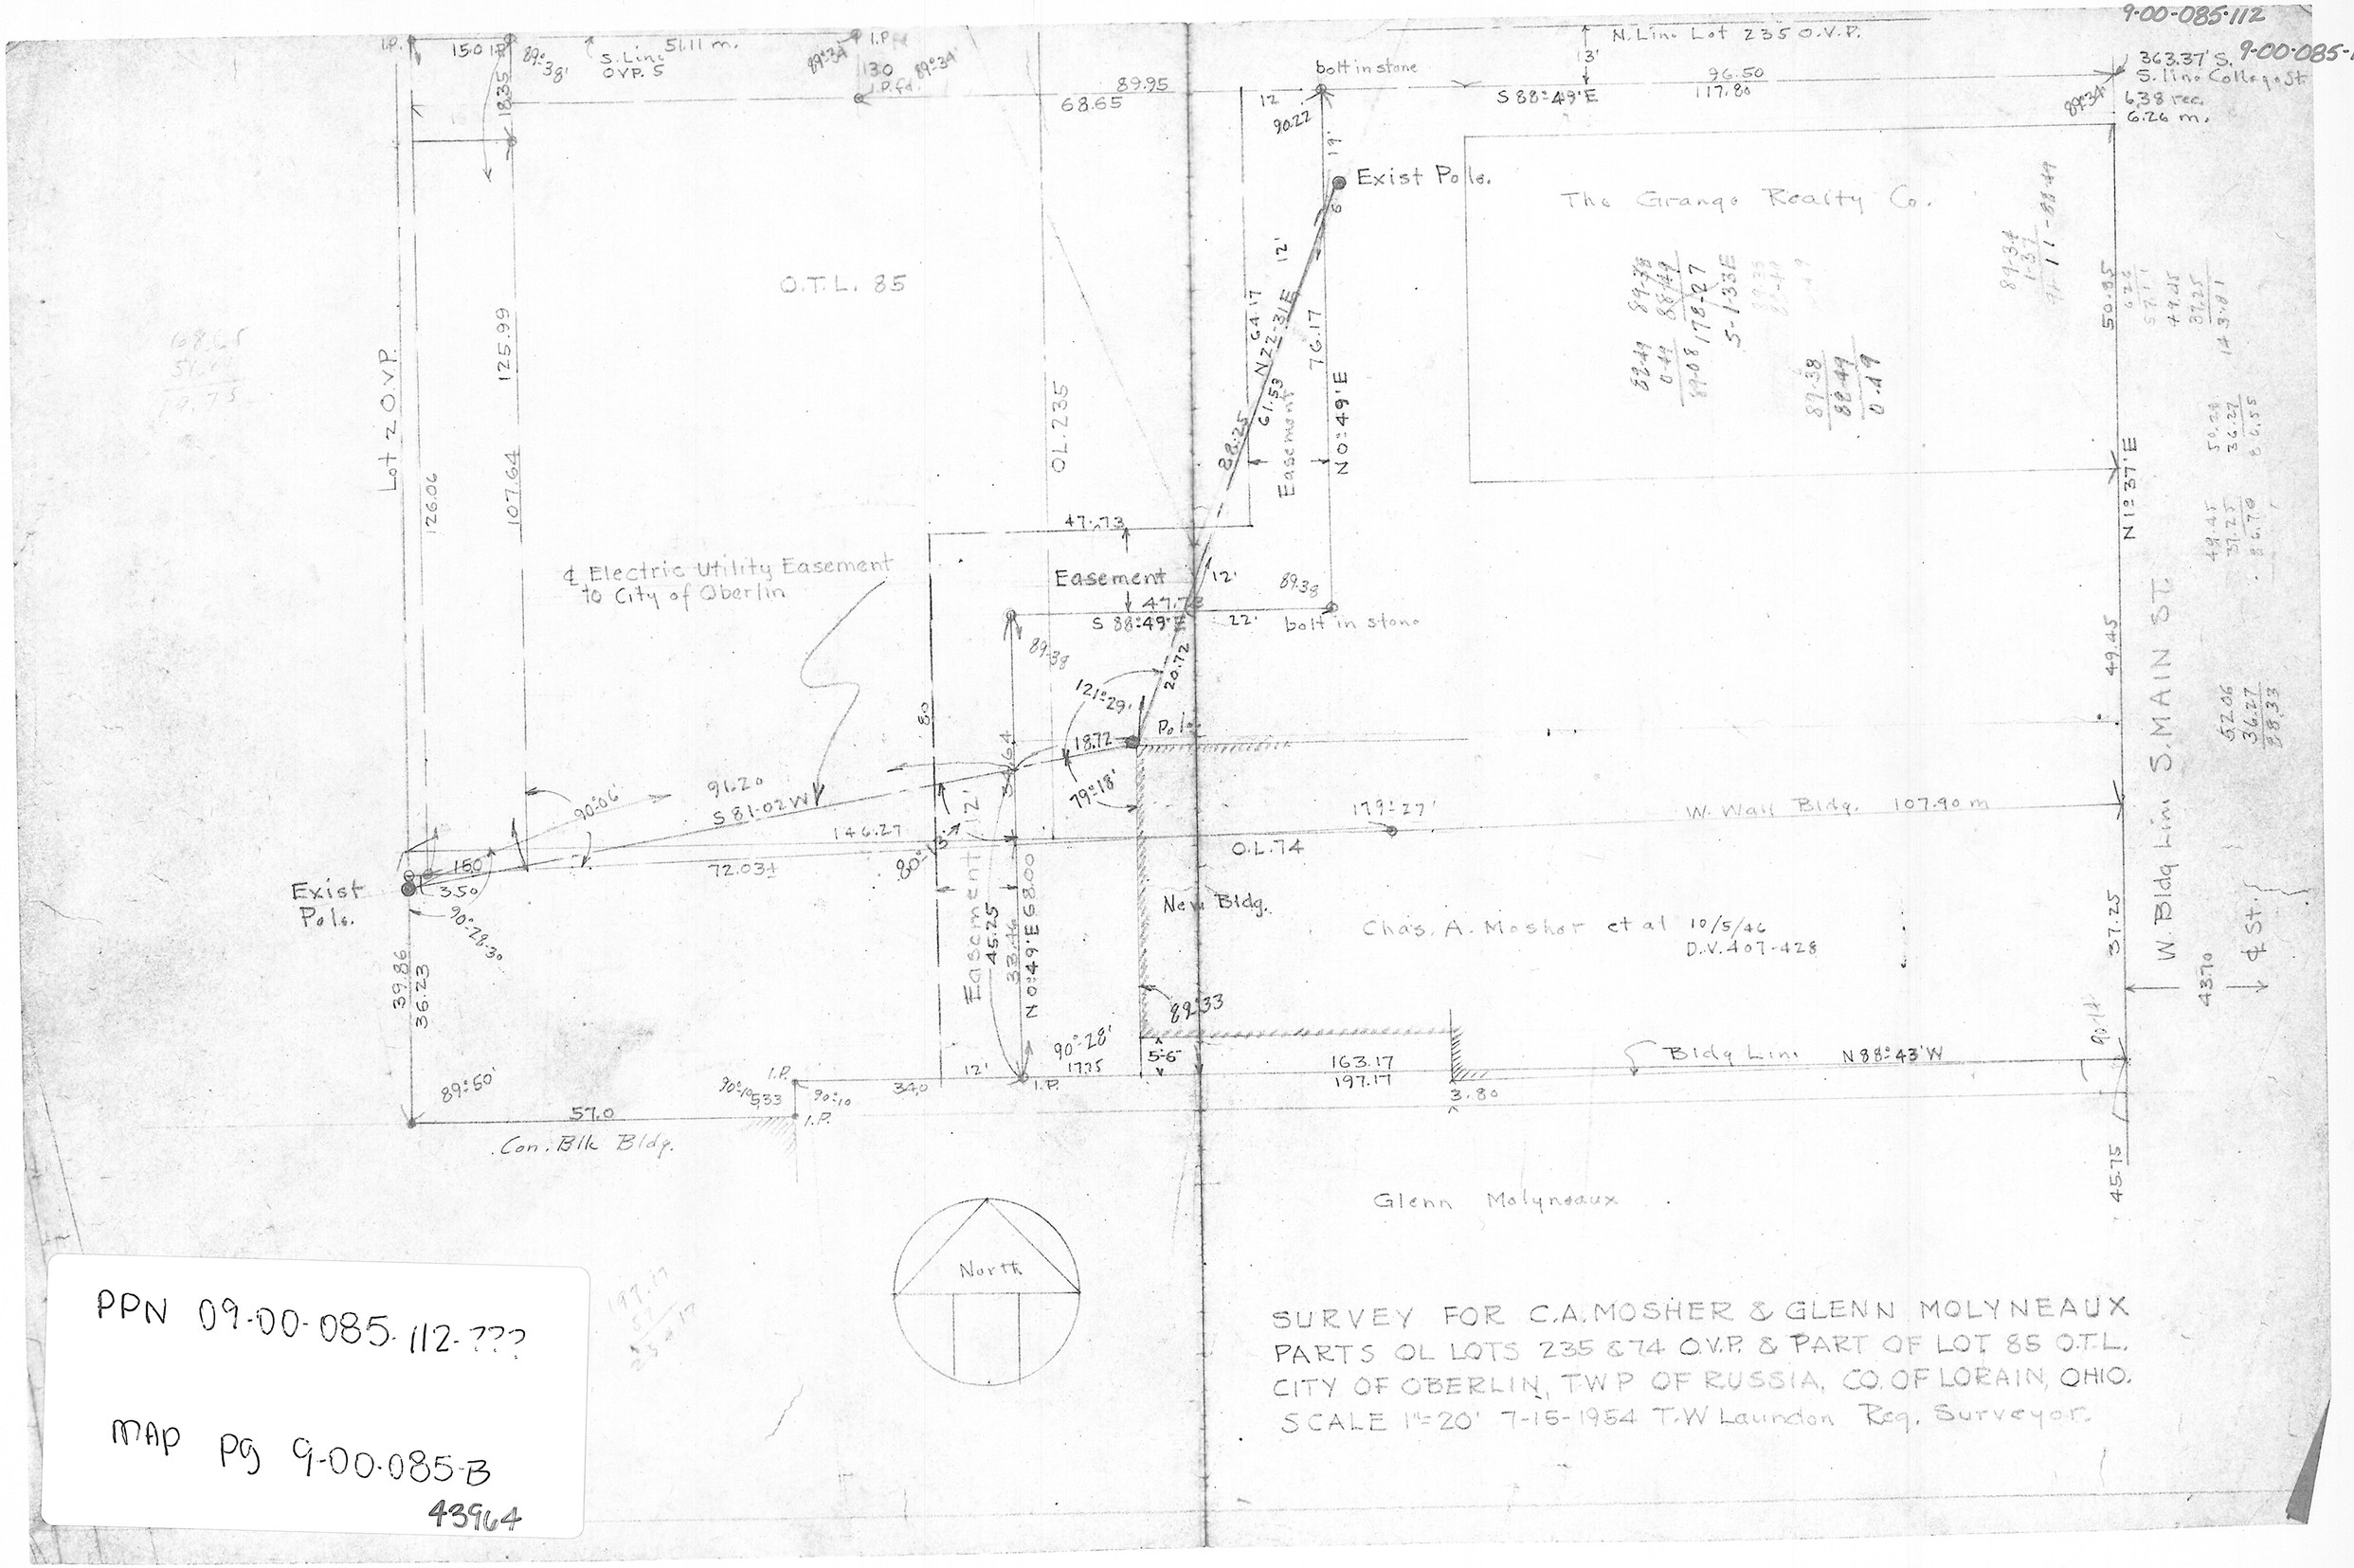

PPN 09-00-085-112-???

MAP PG 9-00-085-B

43964

SURVEY FOR C.A. MOSHER & GLENN MOLYNEAUX
PARTS OL LOTS 235 & 74 O.V.P. & PART OF LOT 85 O.T.L.
CITY OF OBERLIN, TWP OF RUSSIA, CO. OF LORAIN, OHIO.
SCALE 1"=20' 7-15-1954 T.W Laundon Reg. Surveyor.