

14-00-115-000-008  
14-00-115-000-010  
14-00-115-000-010  
14-F

PPN 14-00-115-000-008  
-010  
MAP PG 14-F 43973


LEON W. & NAOMI L. LINTON  
6-25-73 DV. 1081 PG. 80  
N. 4° 05' E.  
1575.66'

PcL. 1  
9.1525 Ac.

PcL. 3  
23.9476 Ac.  
22.2876 Ac.

DALE JACKSON  
10-6-65 DV. 915 PG. 80

WHITNEY ROAD 60'

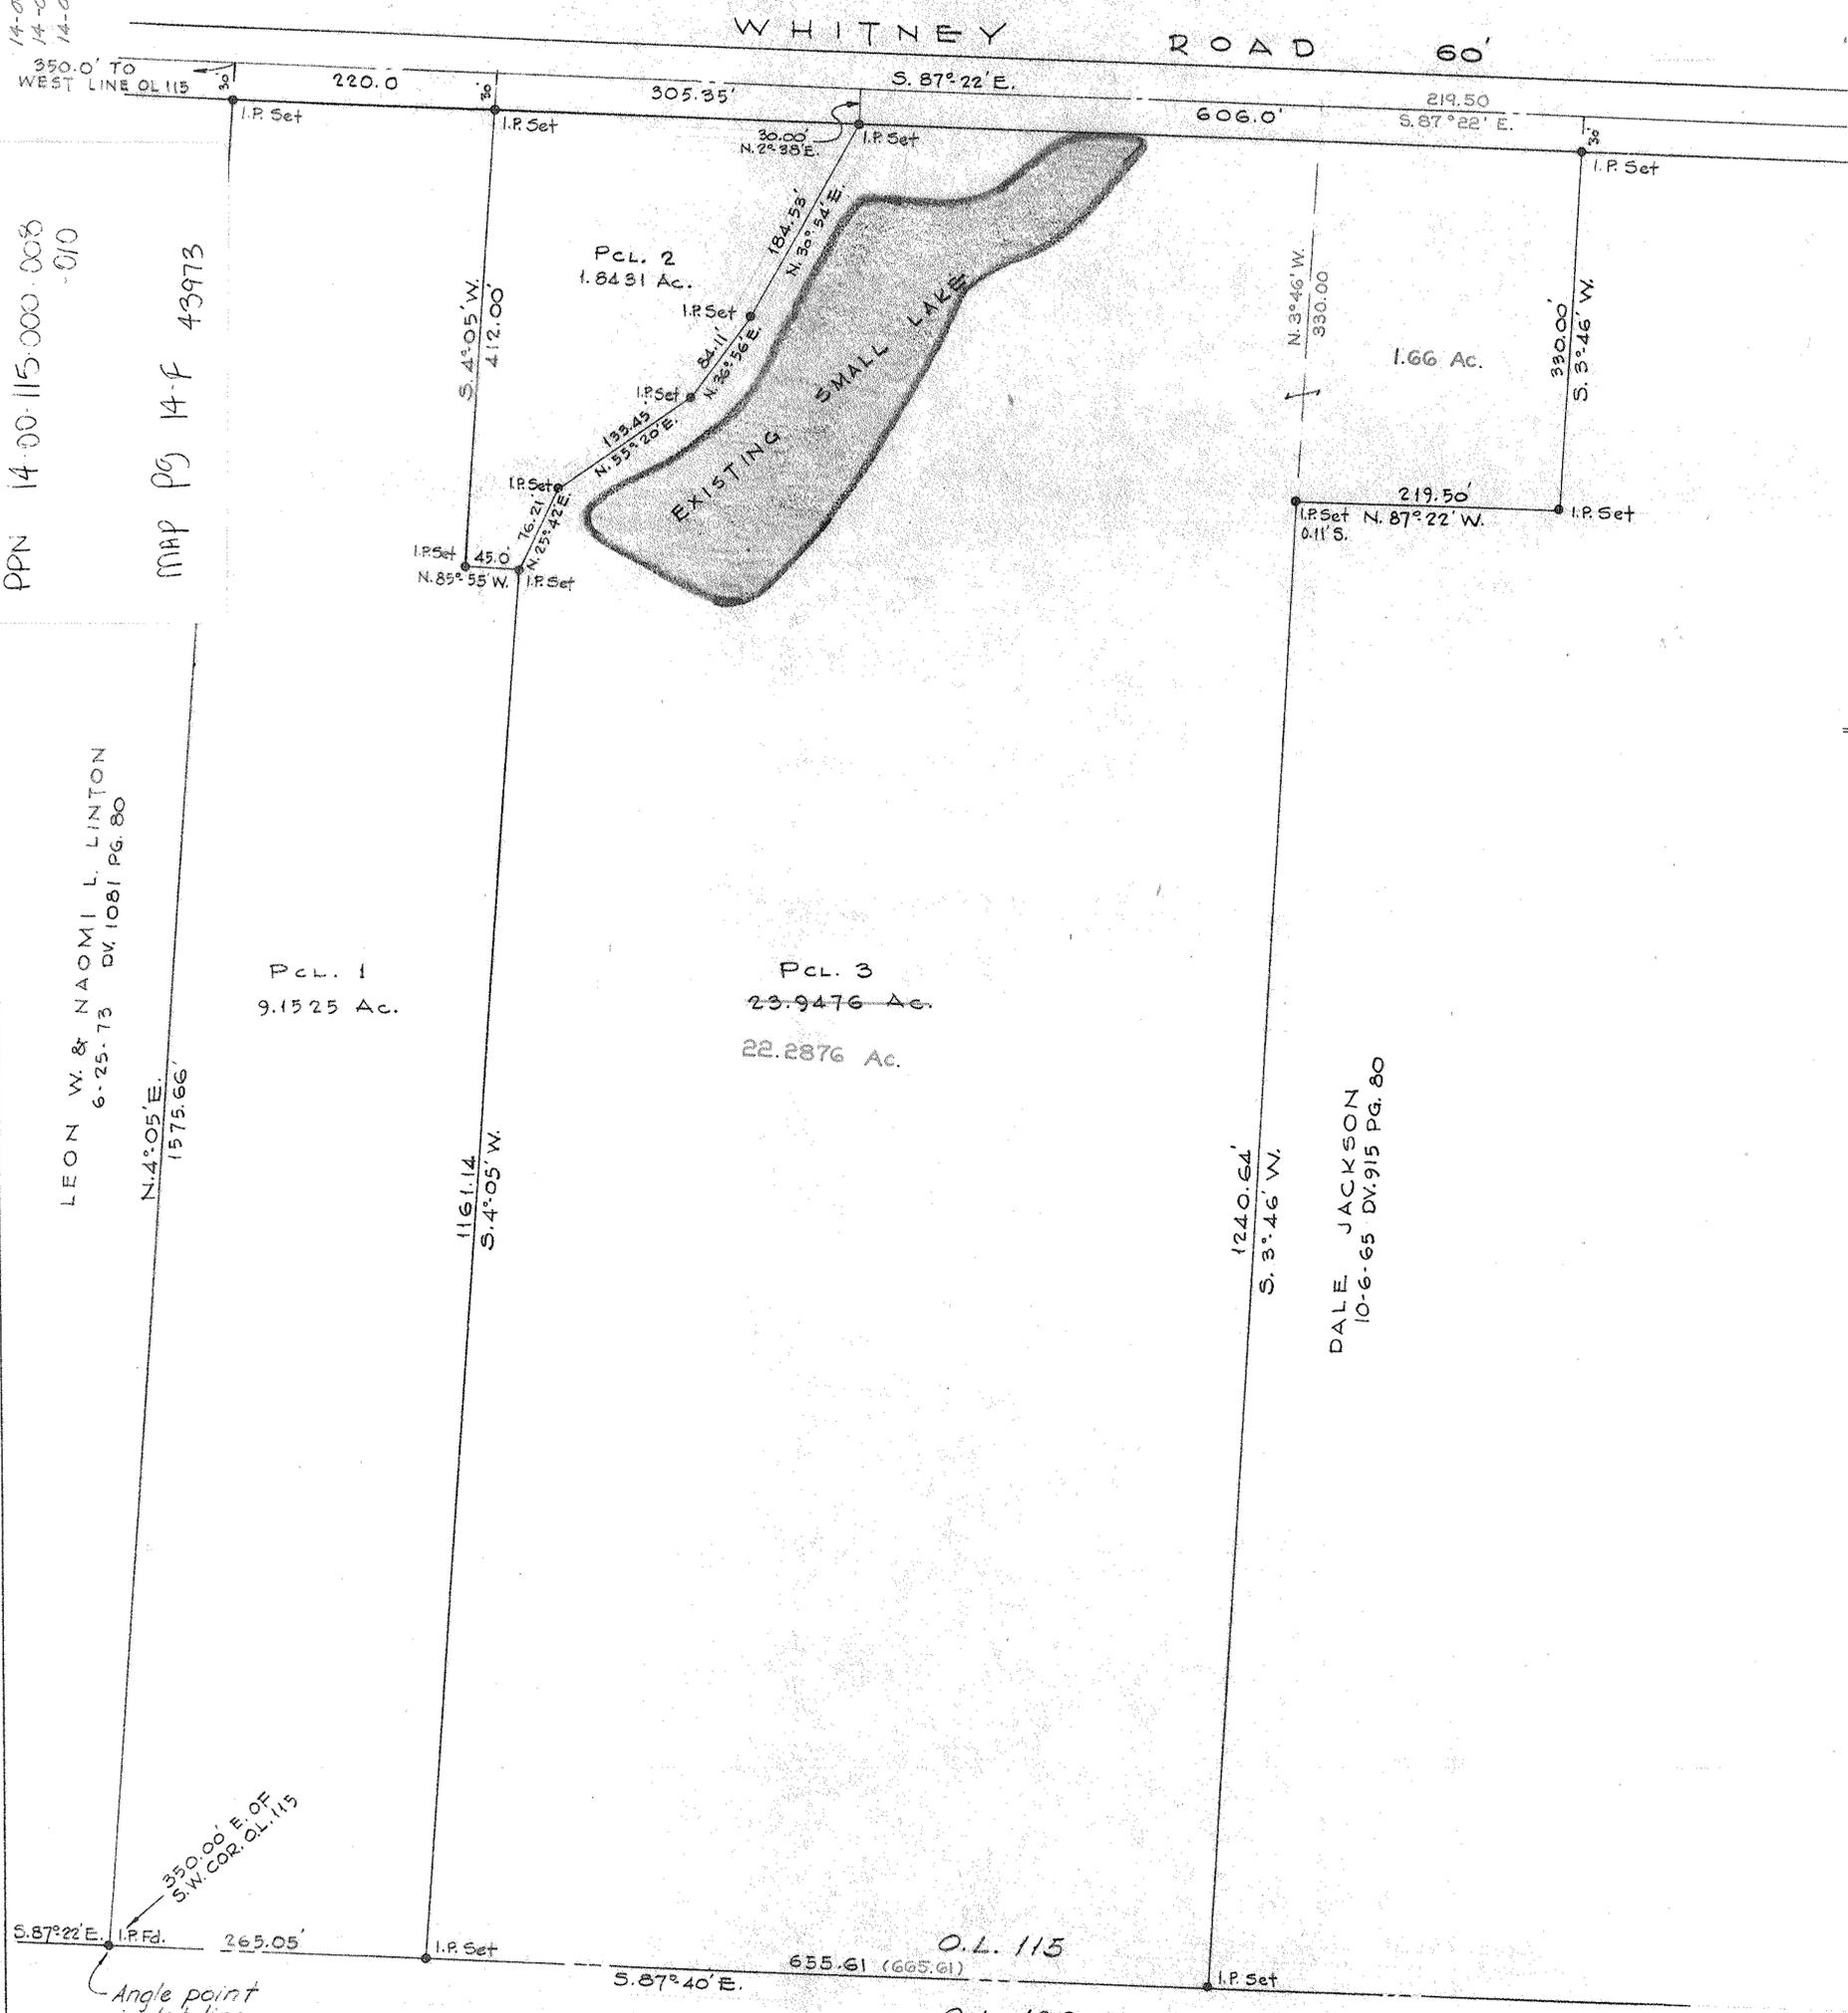

NOTE: THINGS IN RED DRAWN FROM  
PAPER COPY OF MAP 7-8-87  
BY: *C. Ahlert*

SURVEY OF ZEPP LANDS

O.L. 115                      PITTSFIELD TOWNSHIP  
COUNTY OF LORAIN        STATE OF OHIO  
SCALE 1"=100'                      AUGUST 14, 1973  
LAUNDON • SIMON • CAHL & ASSOC.  
ENGINEERS & SURVEYORS

ROBERT L. KING - REALTOR