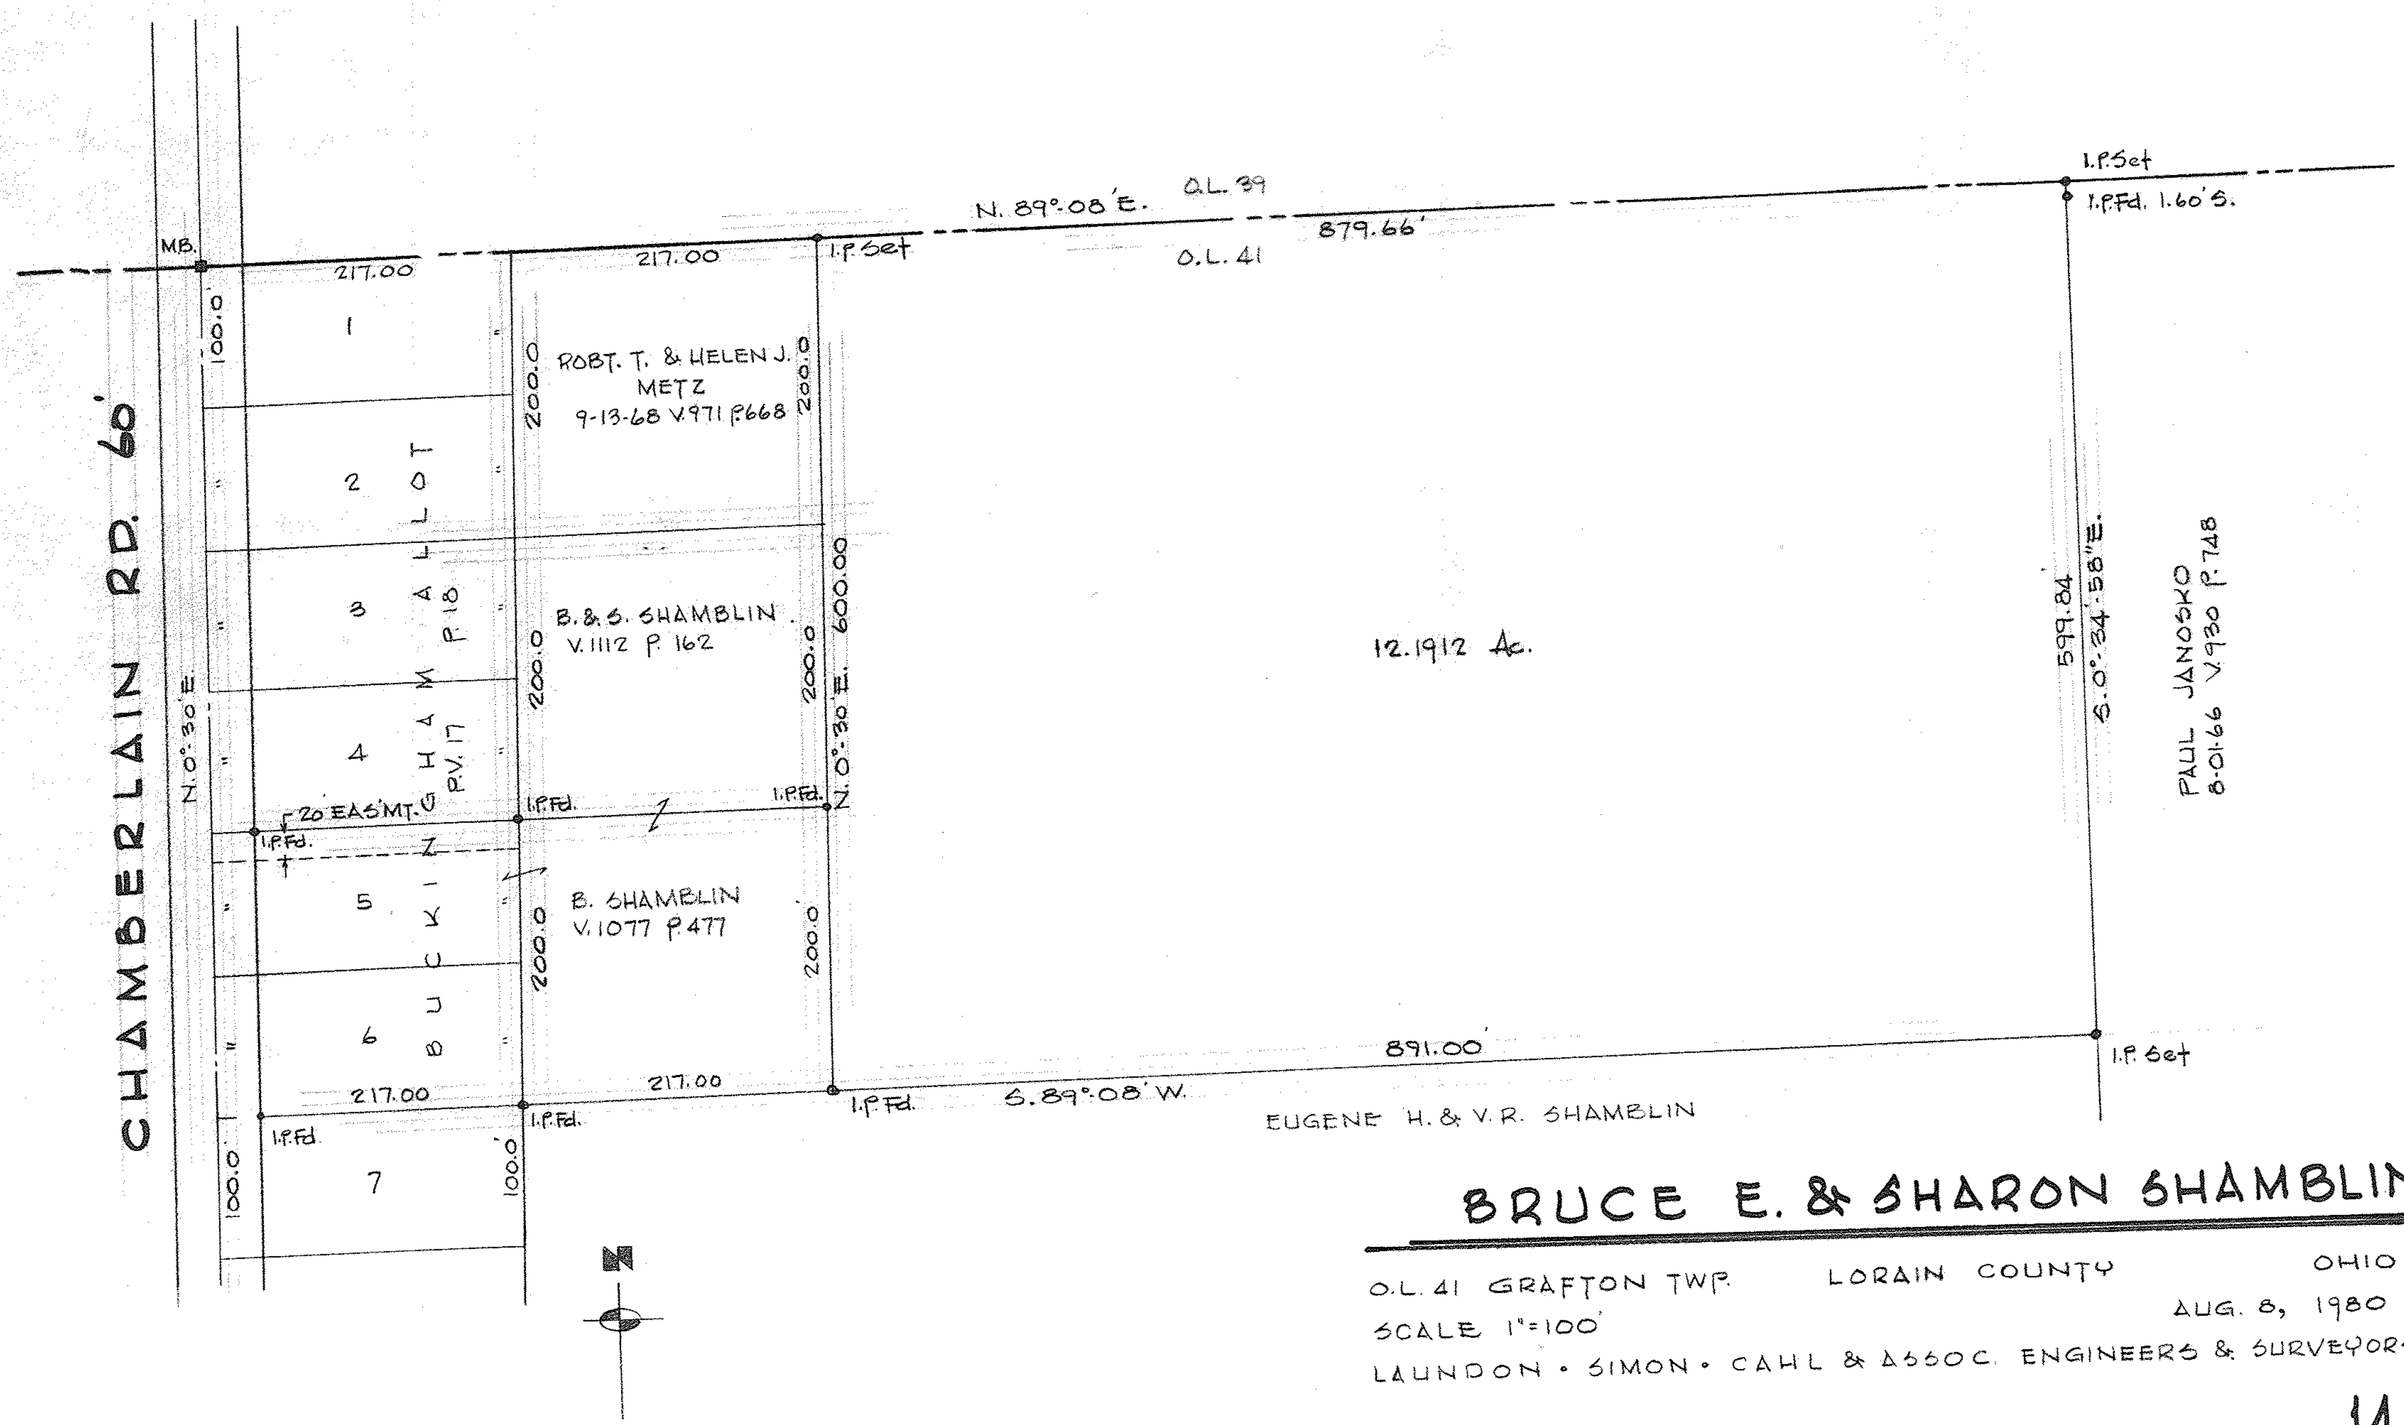

BRUCE E. & SHARON SHAMBLIN

O.L. 41 GRAFTON TWP. LORAIN COUNTY OHIO

SCALE 1"=100' AUG. 8, 1980

LAUNDON • SIMON • CAHL & ASSOC. ENGINEERS & SURVEYORS

141

F.B. 181/14 JOB No. 80-994