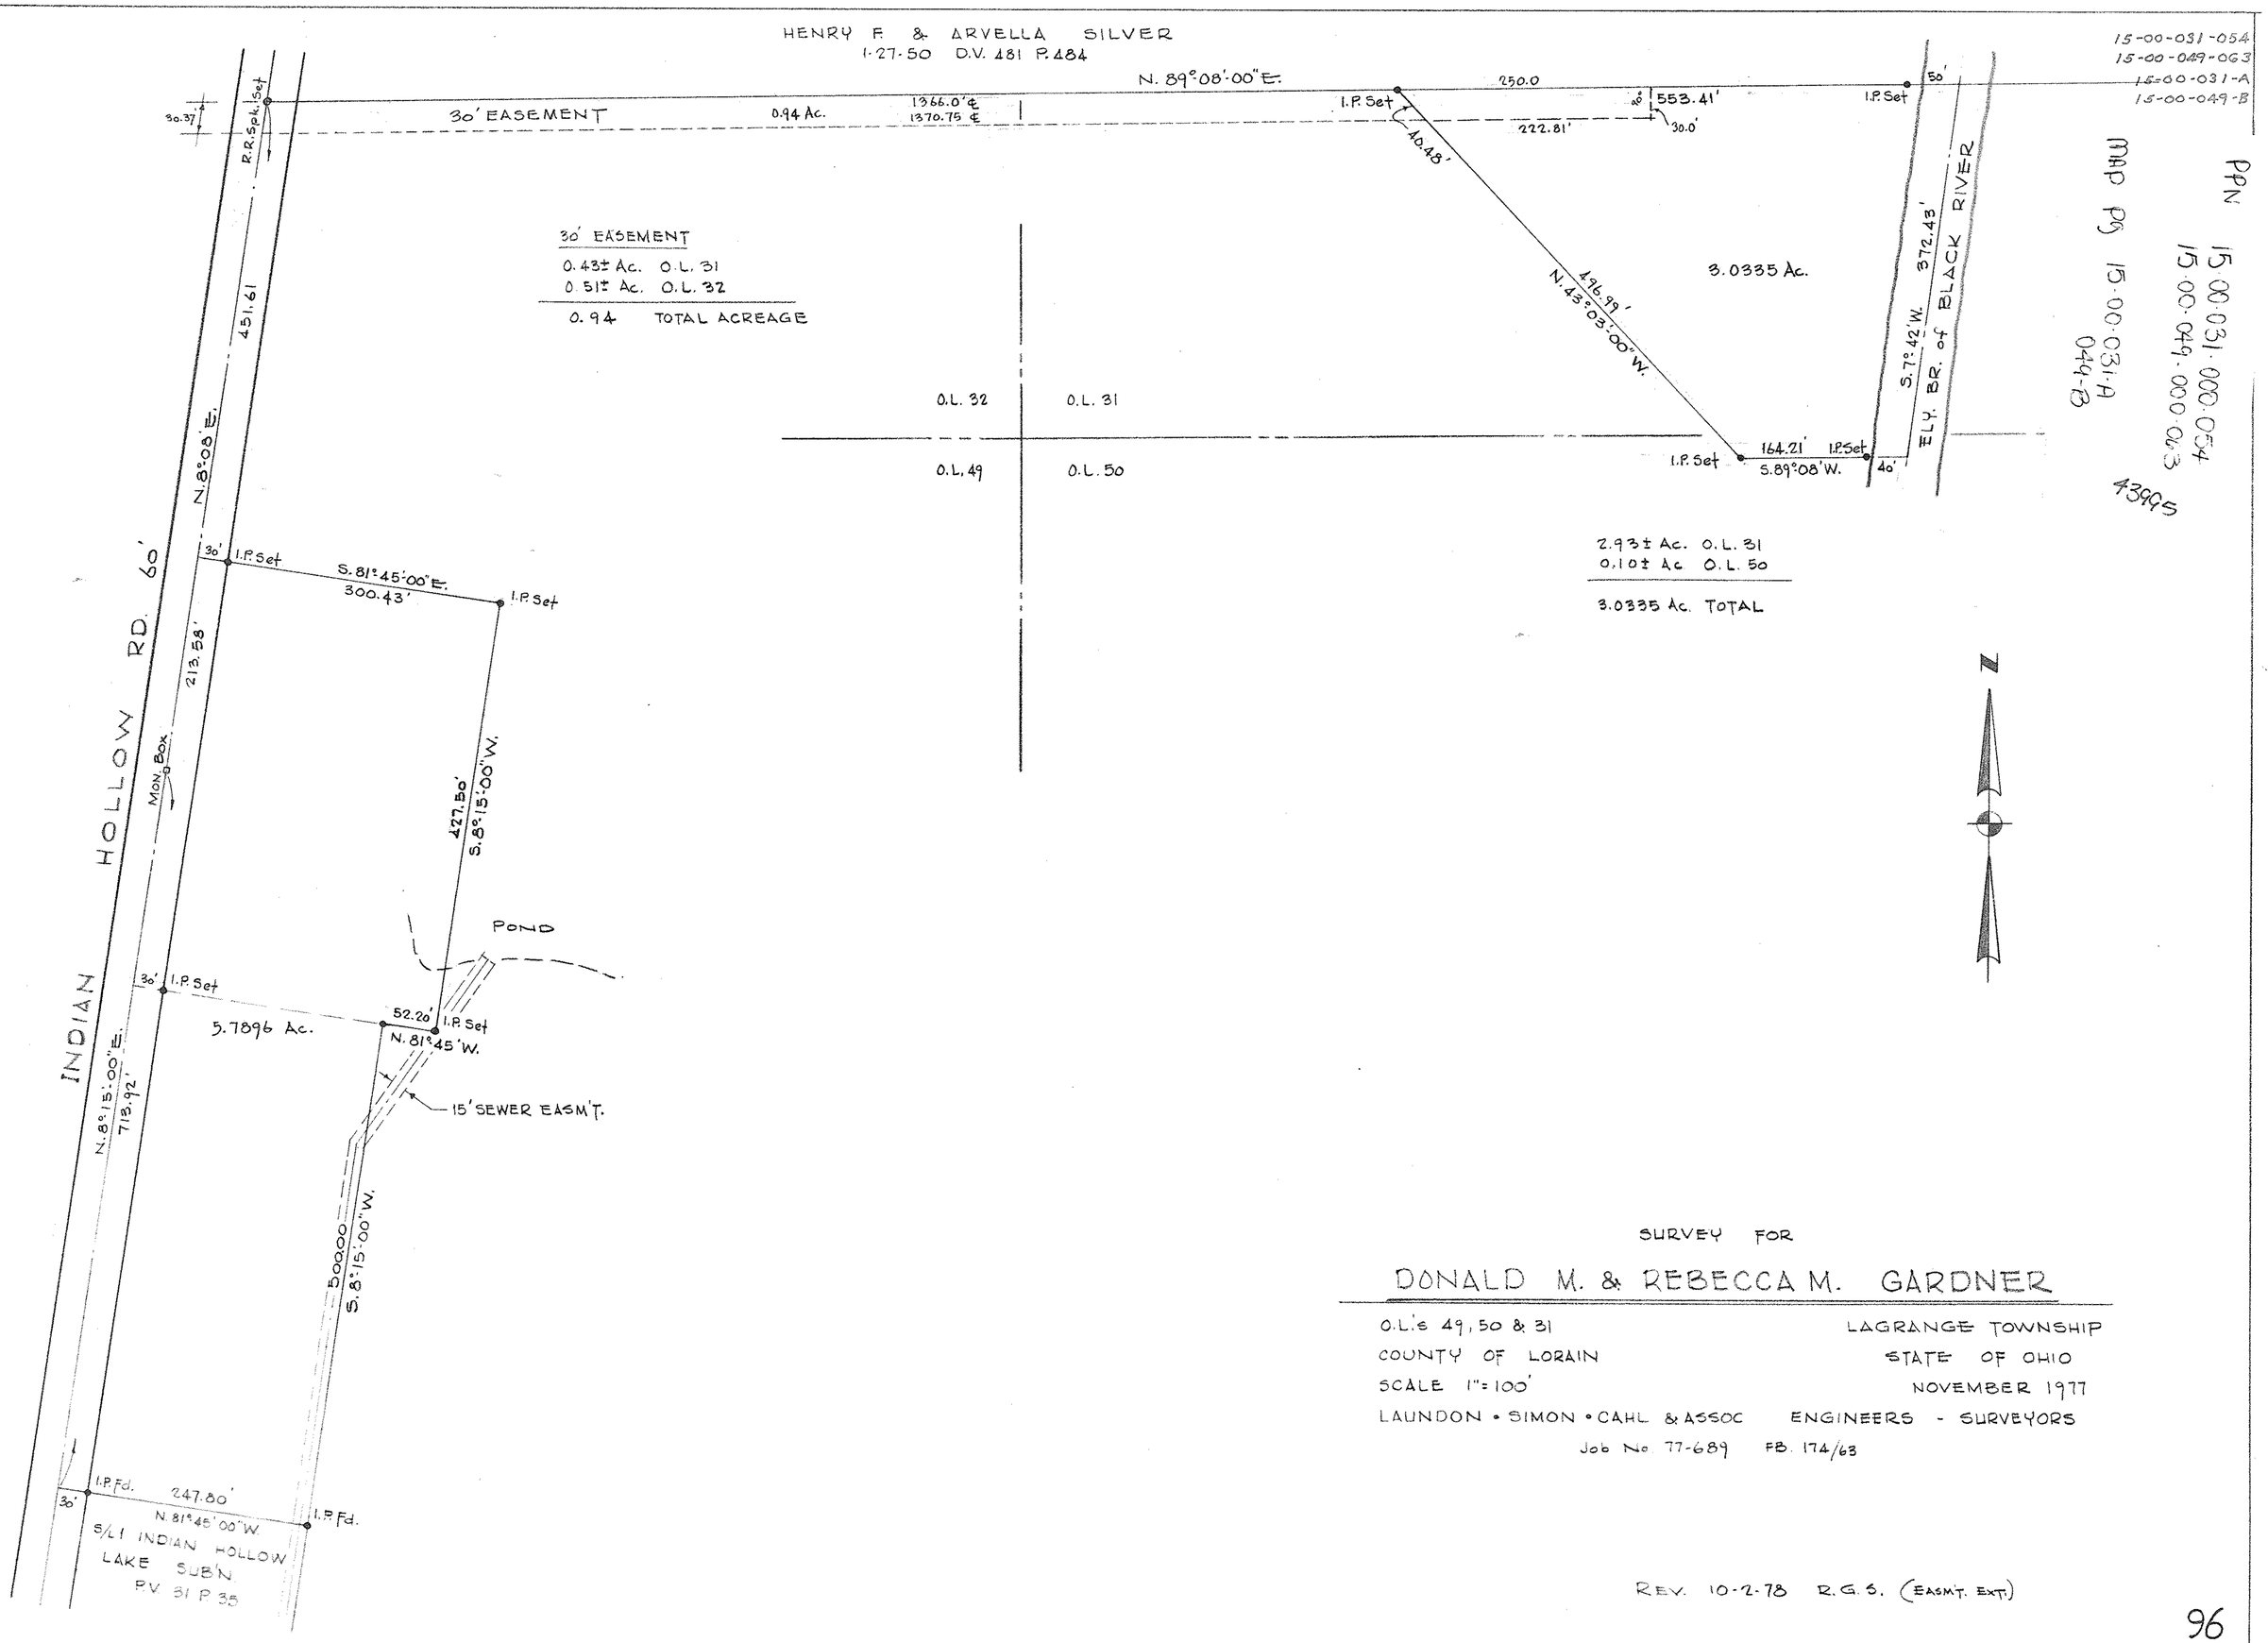

SURVEY FOR

DONALD M. & REBECCA M. GARDNER

O.L.'s 49, 50 & 31 — LAGRANGE TOWNSHIP
COUNTY OF LORAIN — STATE OF OHIO
SCALE 1" = 100' — NOVEMBER 1977
LAUNDON • SIMON • CAHL & ASSOC ENGINEERS - SURVEYORS
Job No. 77-689 FB. 174/63

REV. 10-2-78 R.G.S. (EASM'T. EXT.)