15-D

PPN 15-00-013-000-018
019

MAP PG 15-D 43998

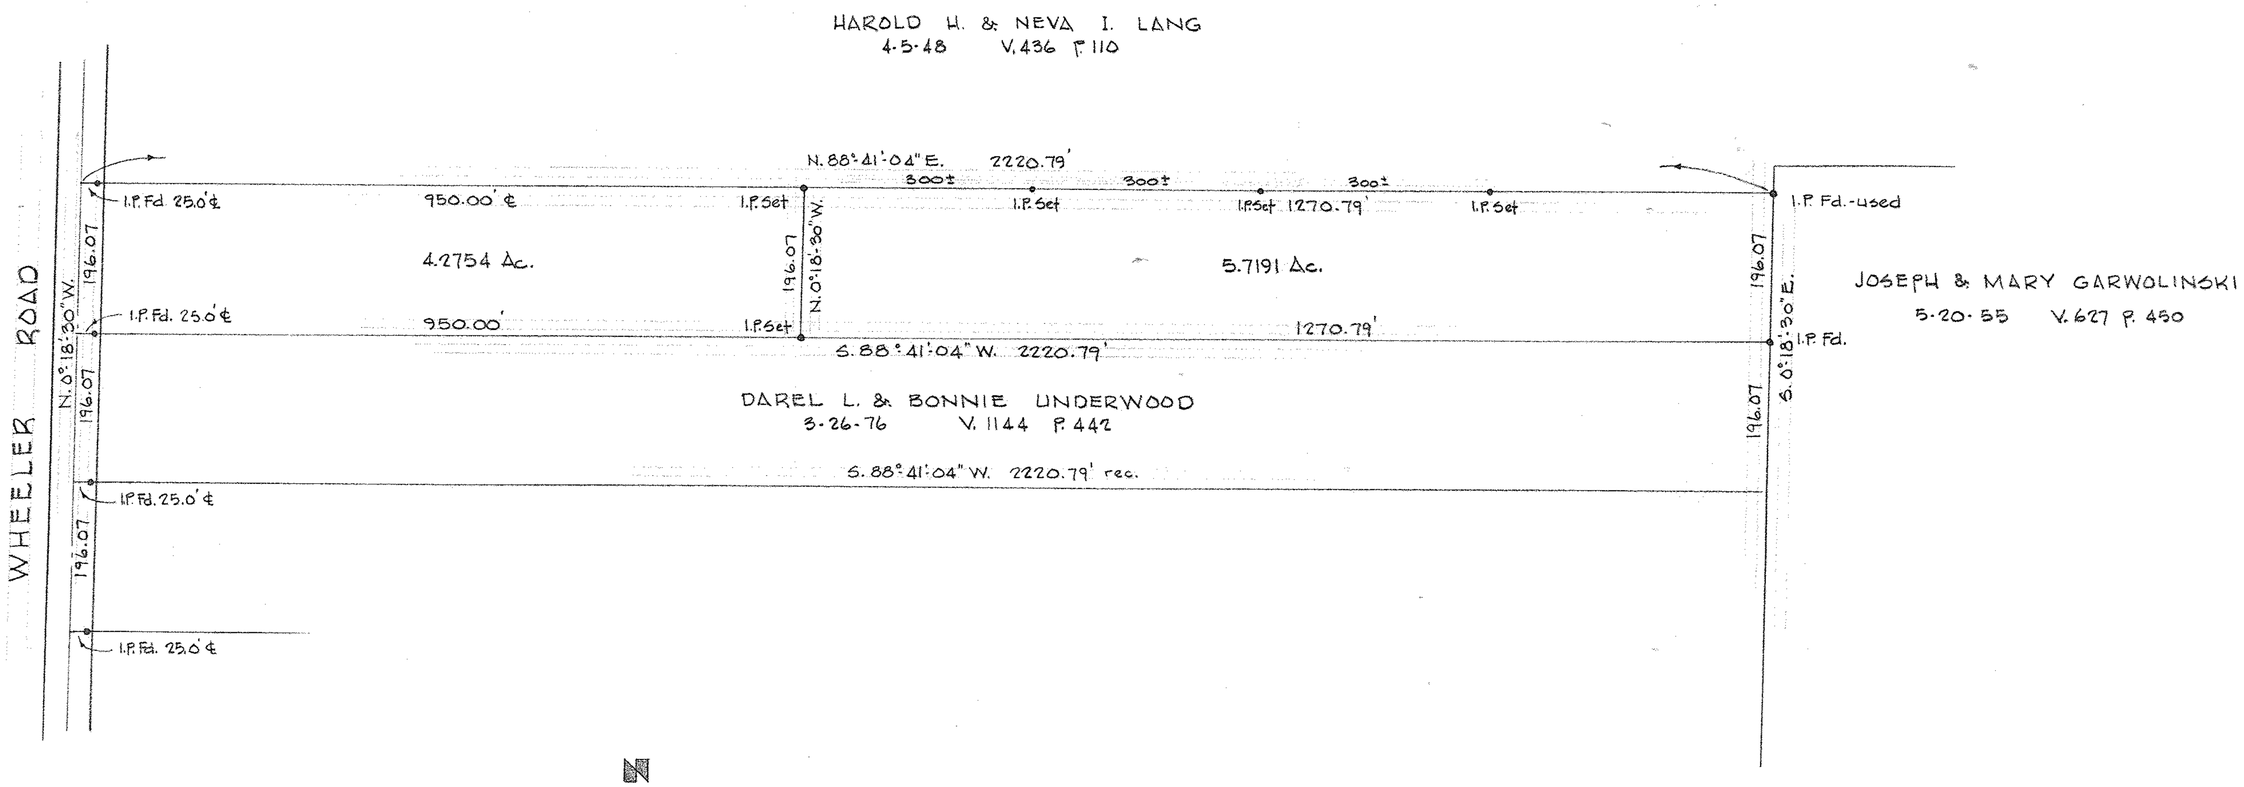

SURVEY FOR

MYRON D. & MARY ANNE JASON

PART OF O.L. 13 LAGRANGE TWP LORAIN COUNTY OHIO
SCALE 1"=150' APRIL, 1981
LAUNDON • SIMON • CAHL & ASSOC. ENGINEERS & SURVEYORS
JOB NO. 81-1050