PPN 12-00-029-000-???
12-00-030-000-???
12-00-031-000-???
12-00-032-000-???

MAP PG 12-G #003

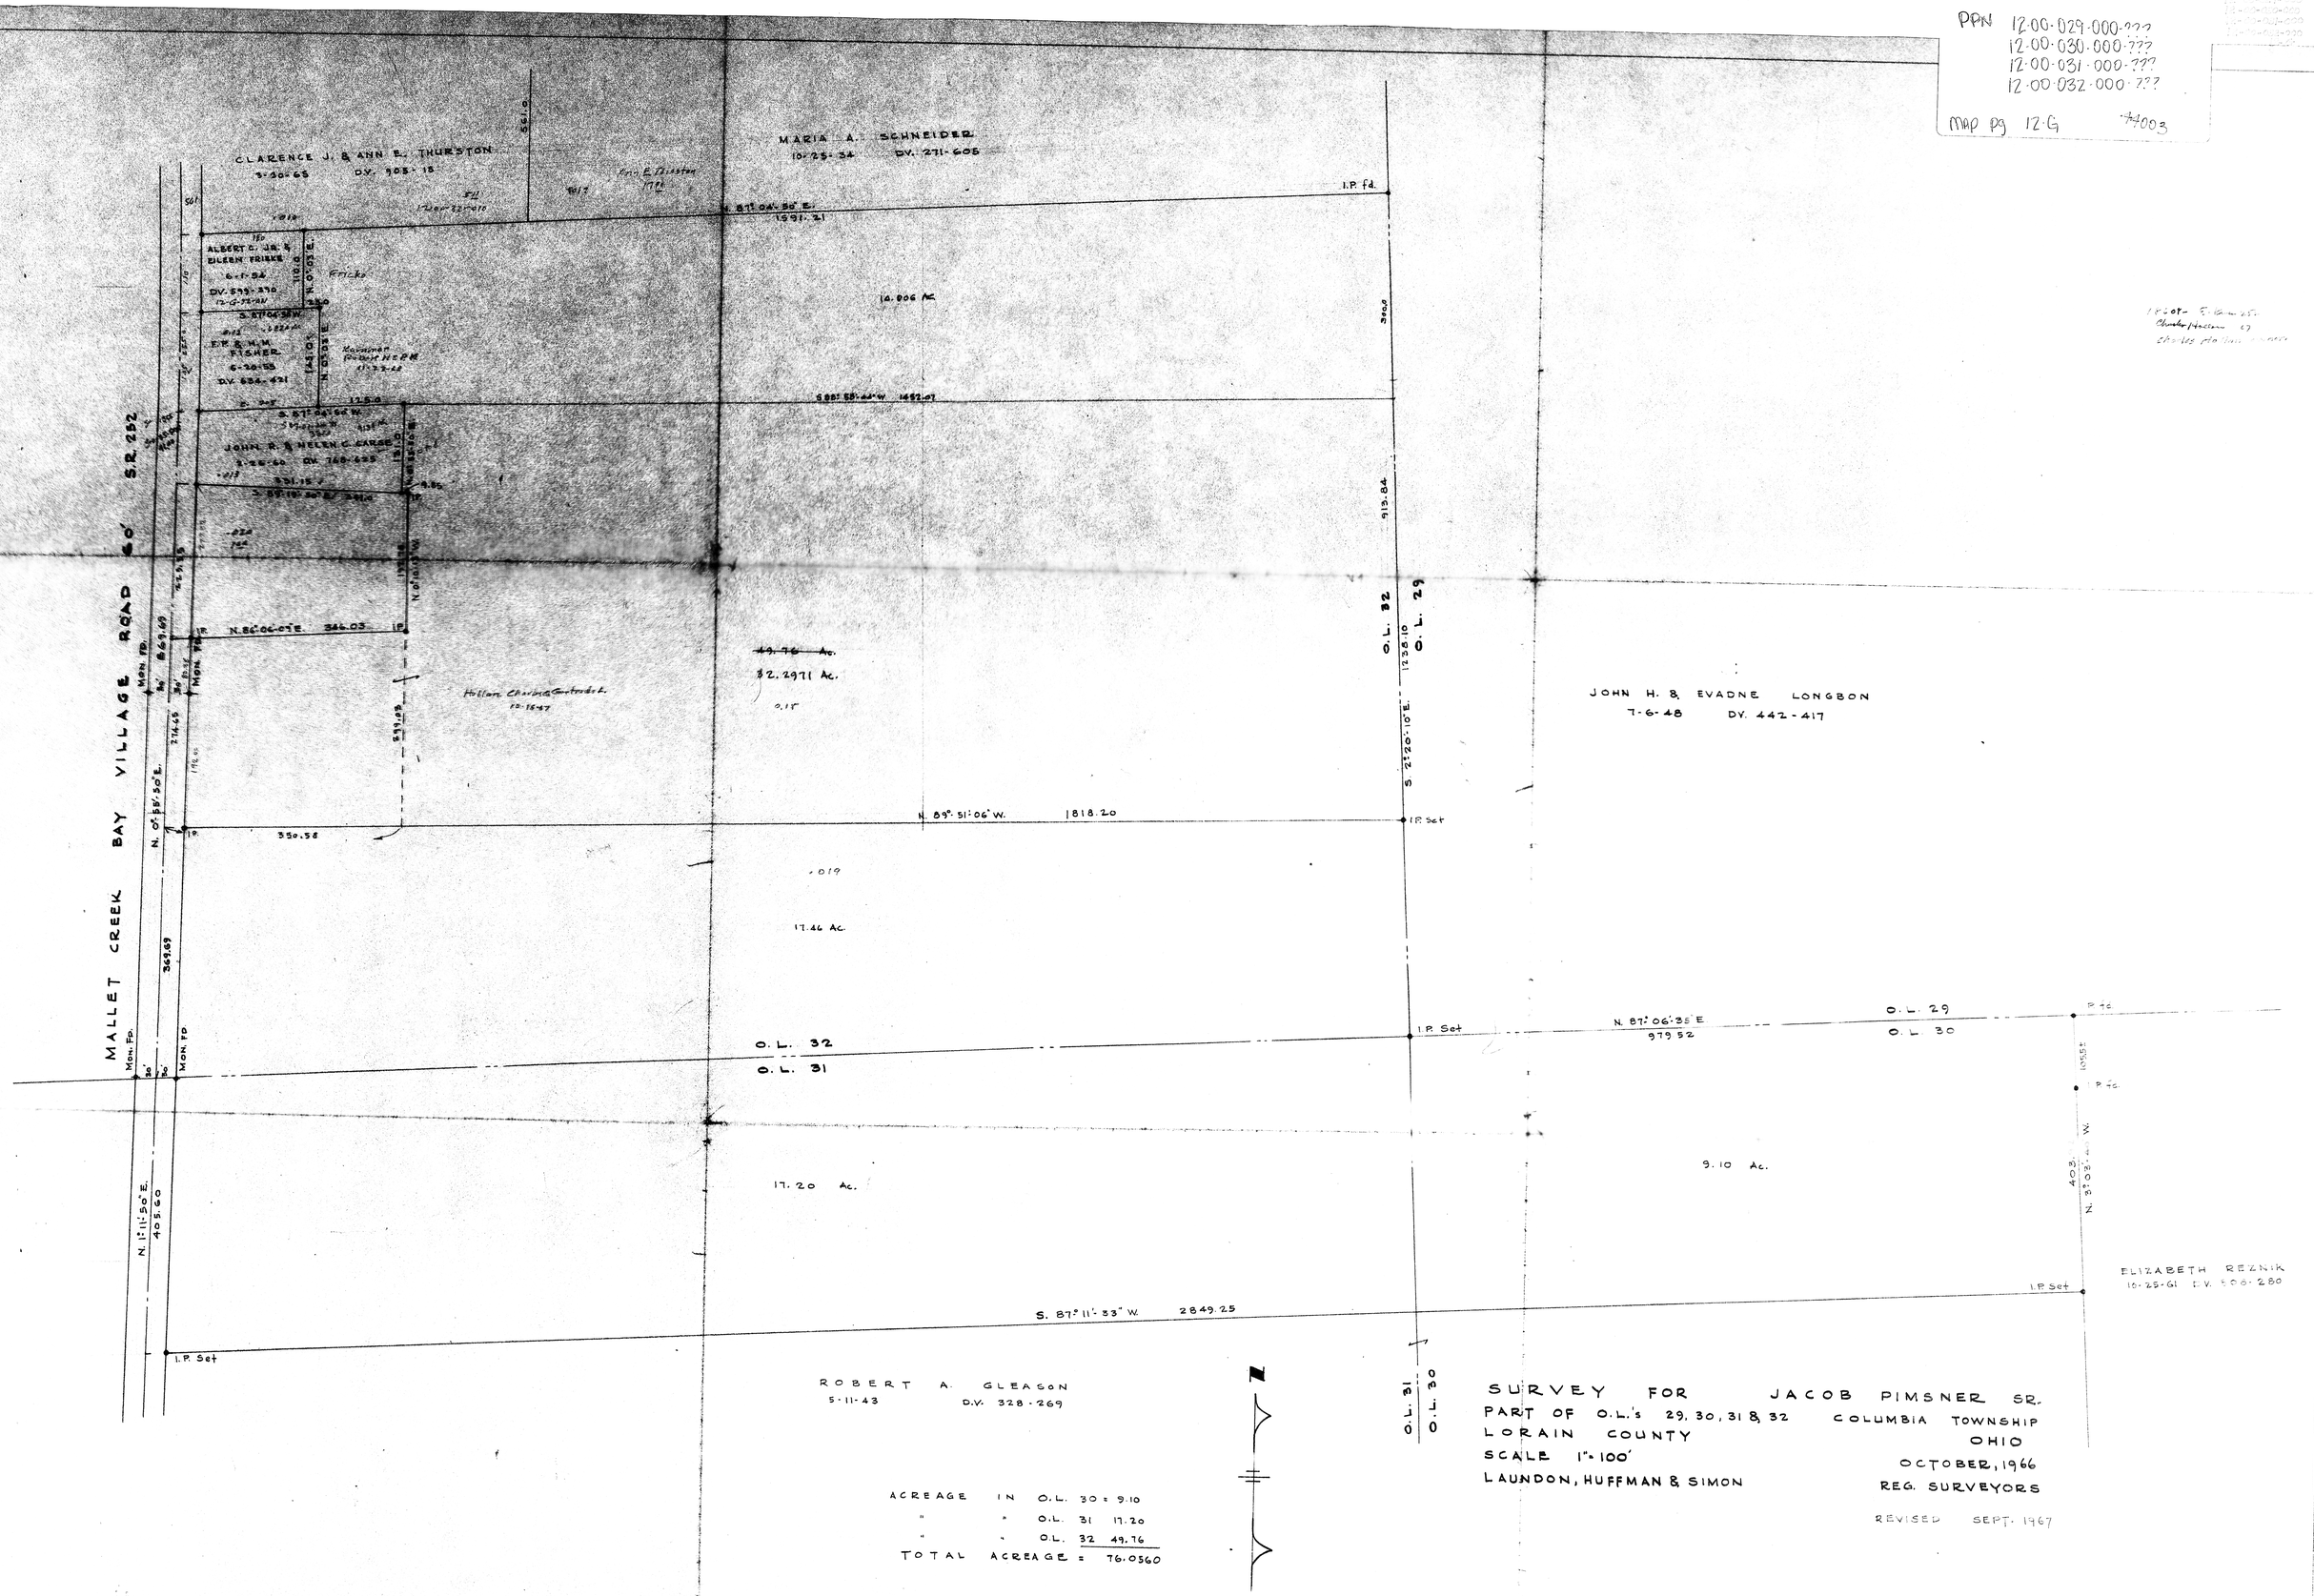

ACREAGE IN O.L. 30 = 9.10
" " O.L. 31 17.20
" " O.L. 32 49.76
TOTAL ACREAGE = 76.0360

SURVEY FOR JACOB PIMSNER SR.
PART OF O.L.'s 29, 30, 31 & 32 COLUMBIA TOWNSHIP
LORAIN COUNTY OHIO
SCALE 1" = 100'
LAUNDON, HUFFMAN & SIMON
OCTOBER, 1966
REG. SURVEYORS

REVISED SEPT. 1967