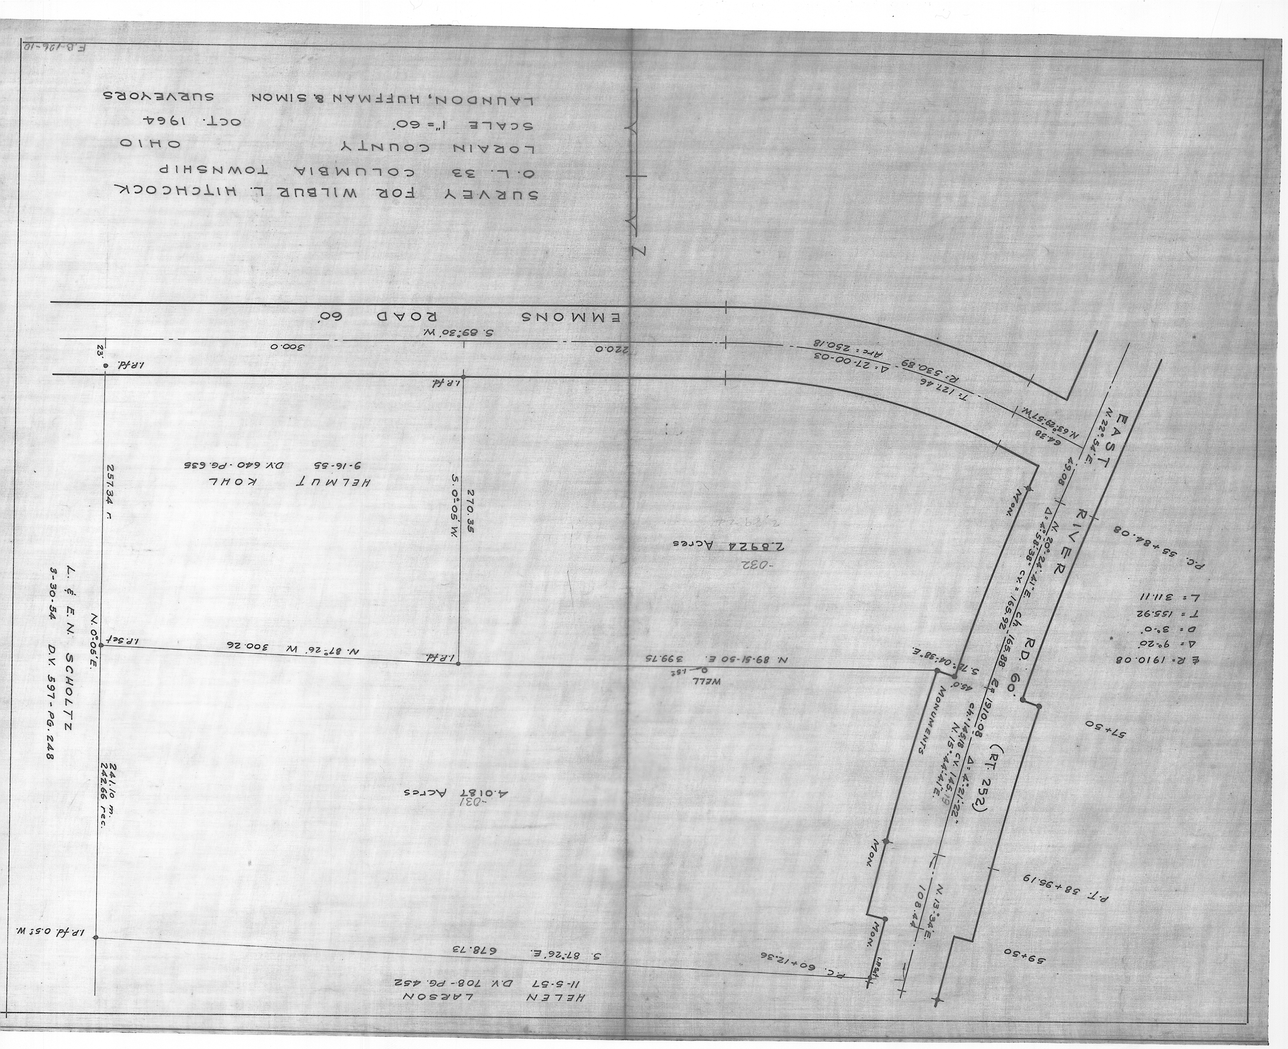

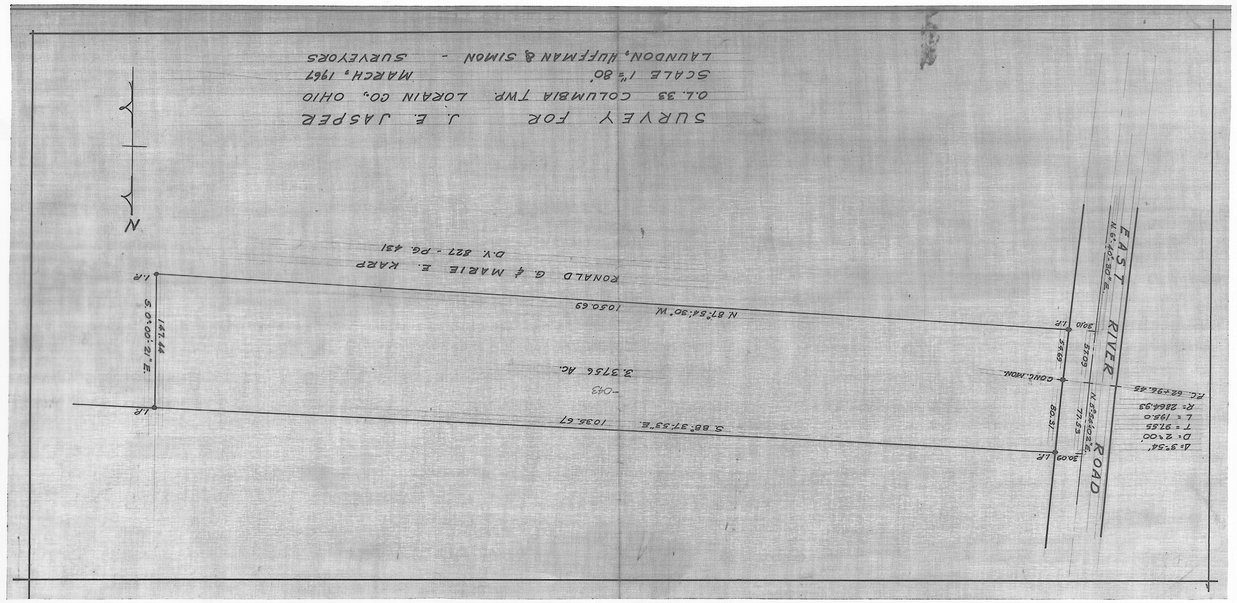

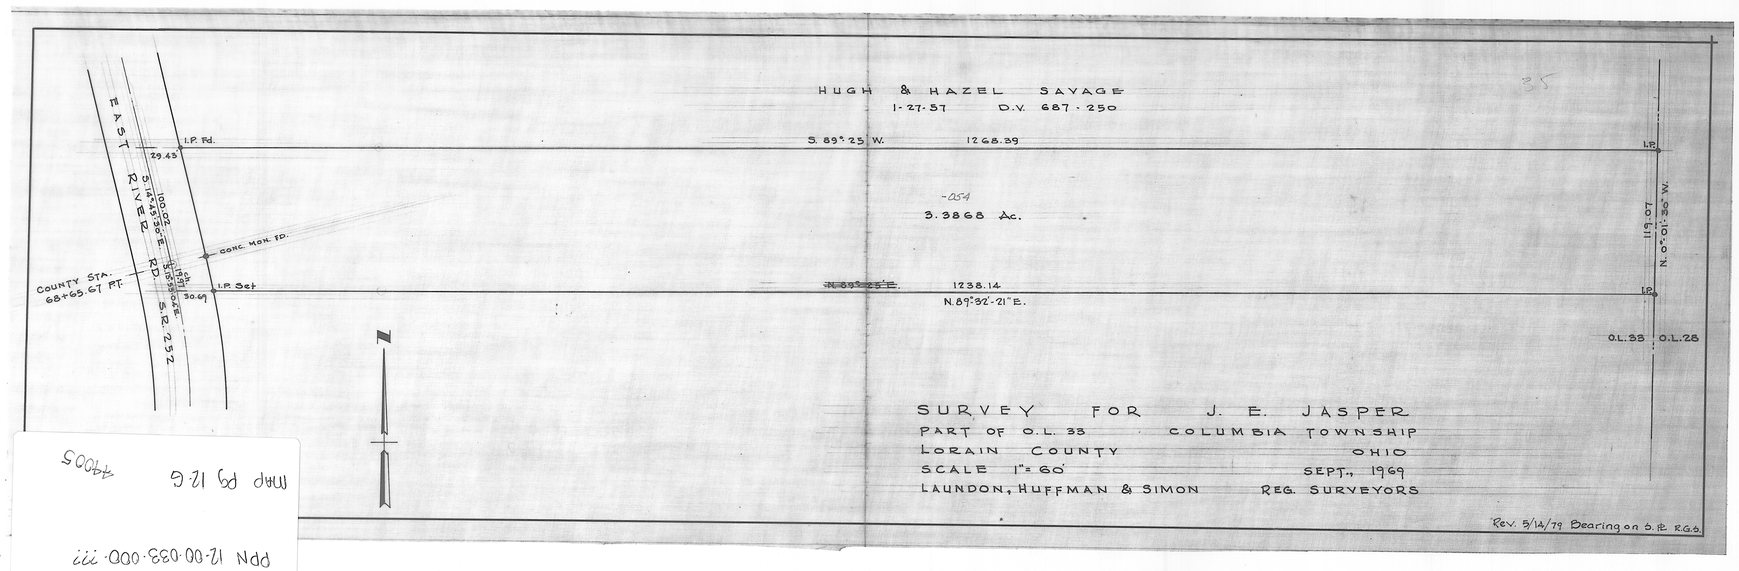

PPN 12-00-038-000-???
12-G
MAP PG 12-G
44005
12-00-038-000-
12-G