11-00-089-000-015
11-00-089-000-016
11-00-089-000-017
11-00-089-000-039
11-00-089-000-040
11-00-089-000-049
11-00-089-000-050
11-00-089-A

PPN 11-00-089-000-015
016
017
039
040
049
050

44007

MAP PG 11-00-089-A

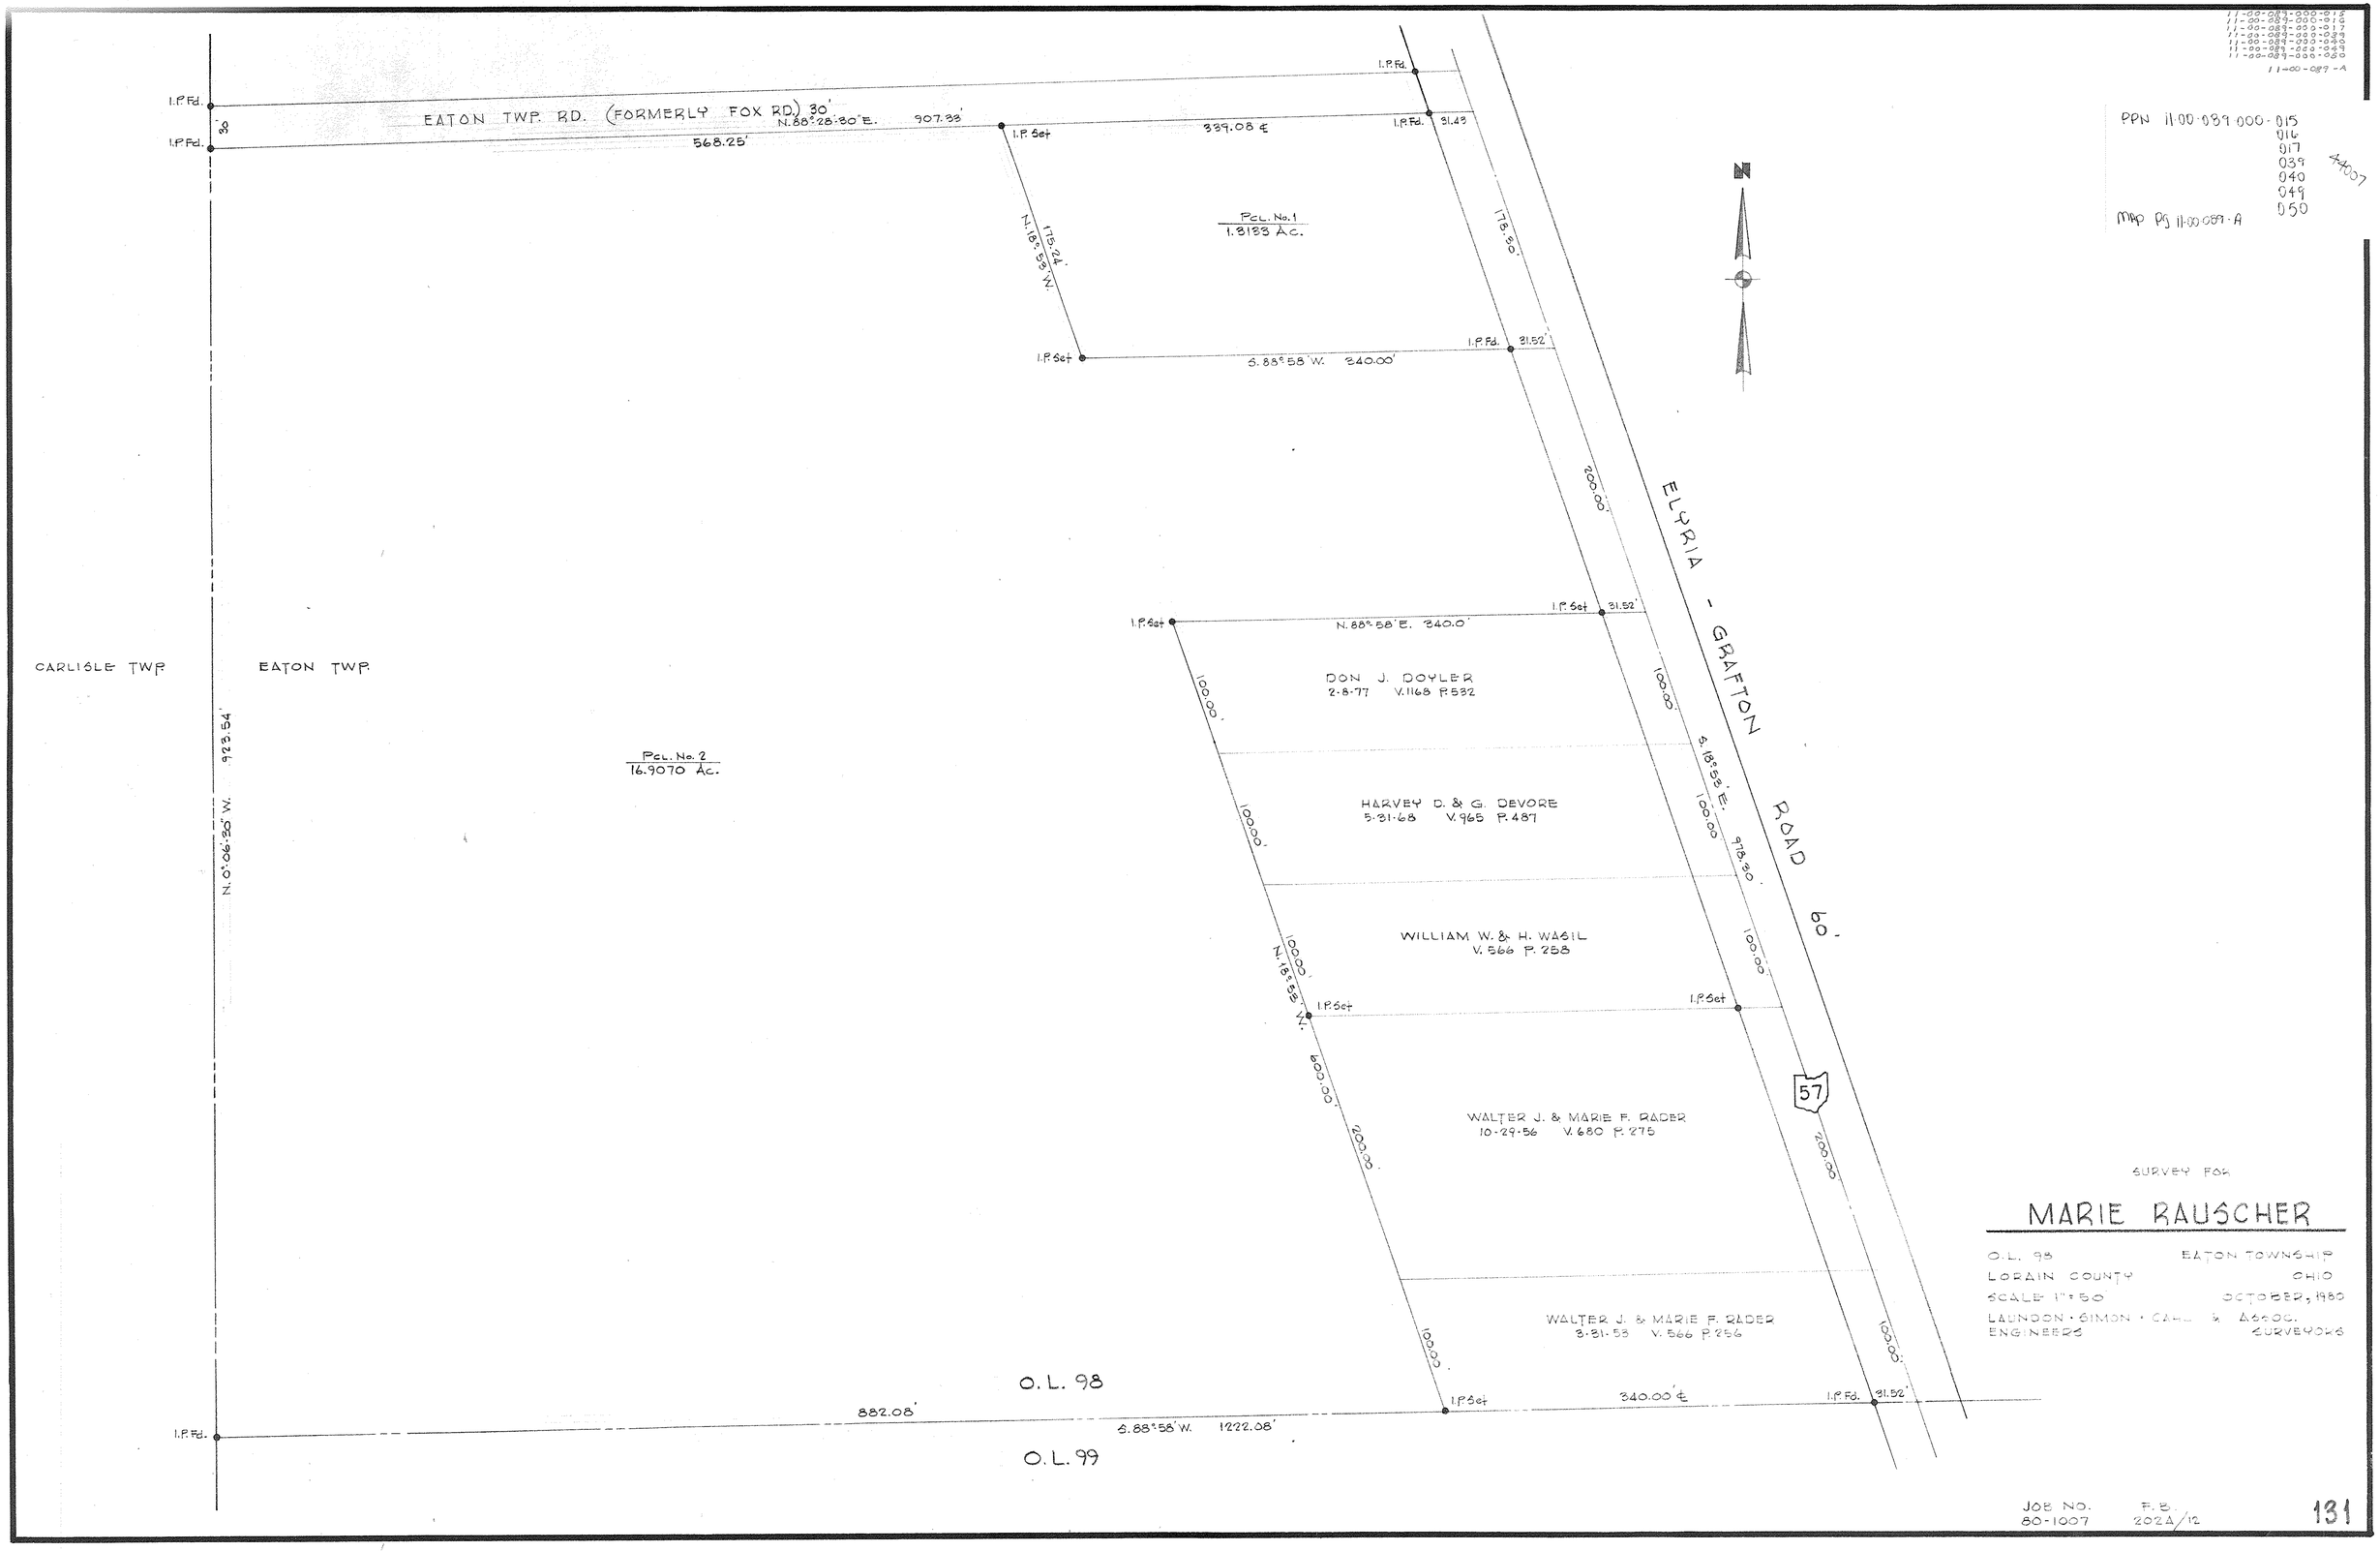

SURVEY FOR

MARIE RAUSCHER

O.L. 98 — EATON TOWNSHIP
LORAIN COUNTY — OHIO
SCALE 1"=50 — OCTOBER, 1980
LAUNDON · SIMON · CAHILL & ASSOC.
ENGINEERS — SURVEYORS

JOB NO. 80-1007 — F.B. 2024/12