12-00-033-000-024
12-00-033-000-037
12-G

PPN 12-00-033-000-024
037

MAP PG 12-G
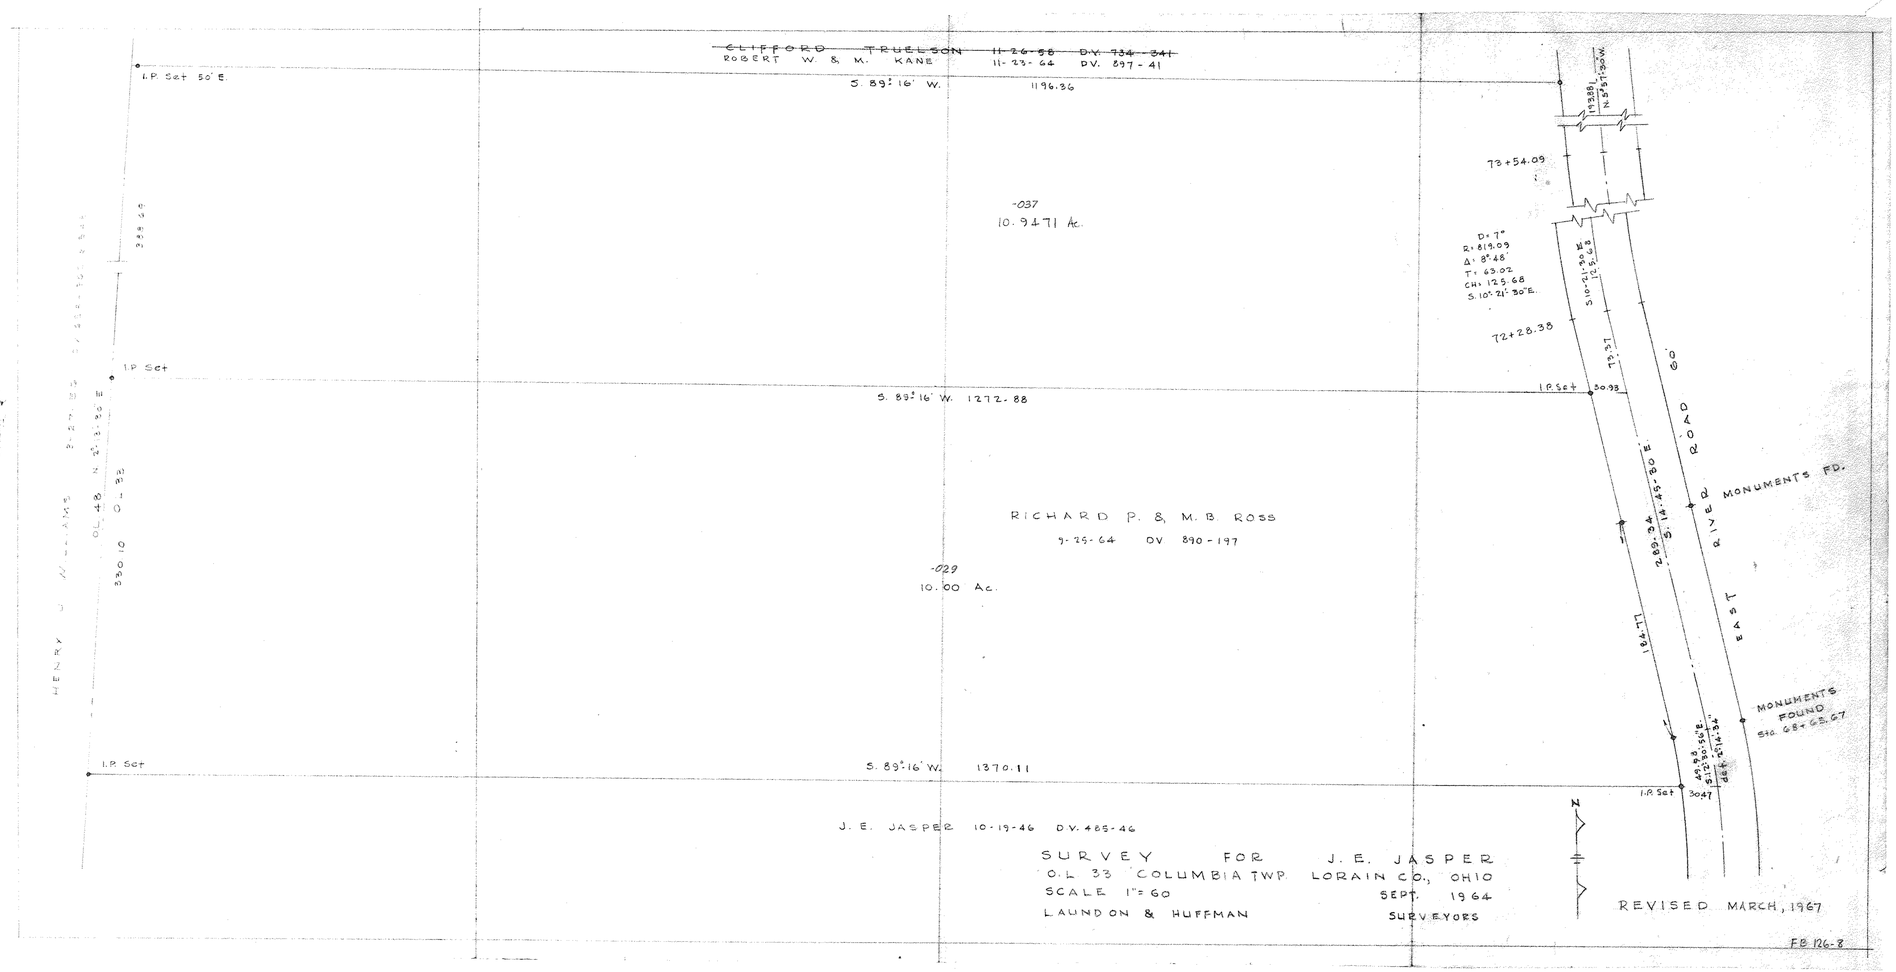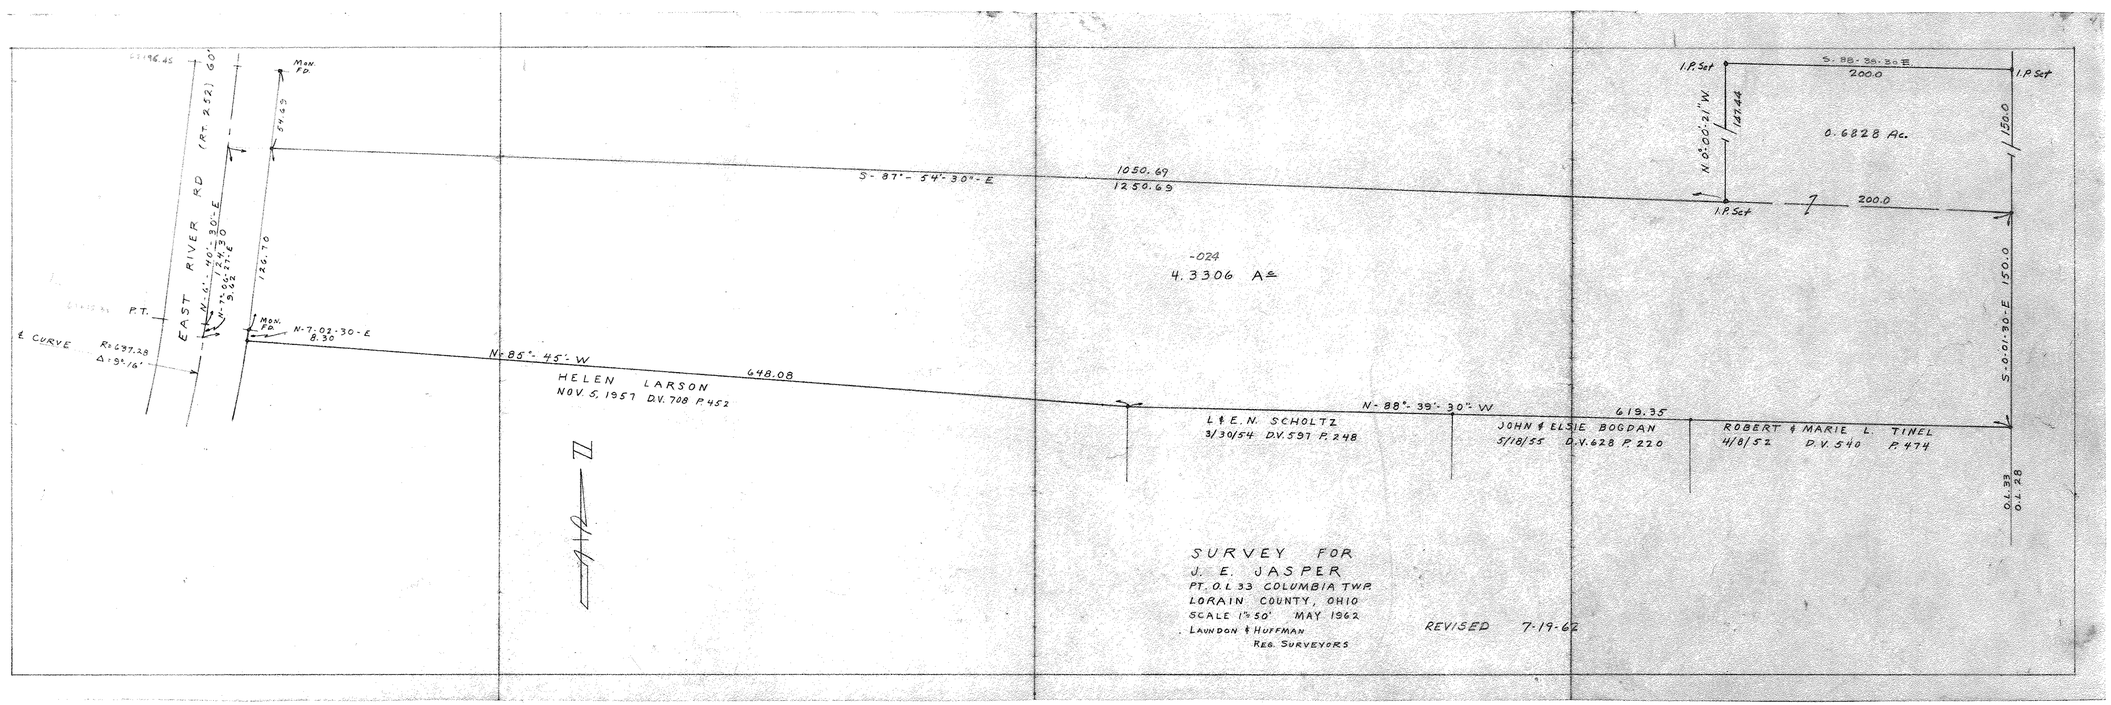
44-011