PPN 05-00-031-000-019 44019
09-00-005-000-012, 014
09-00-006-000-002, 011, 012
MAP pg 9-B, 9-C, 05-00-031-A

5-00-031-000-019
5-00-031-A
5-00-031-B
9-00-005-000-012
9-00-005-000-014
9-00-006-000-002
9-00-006-000-011
9-00-006-000-012
9-B
9-C

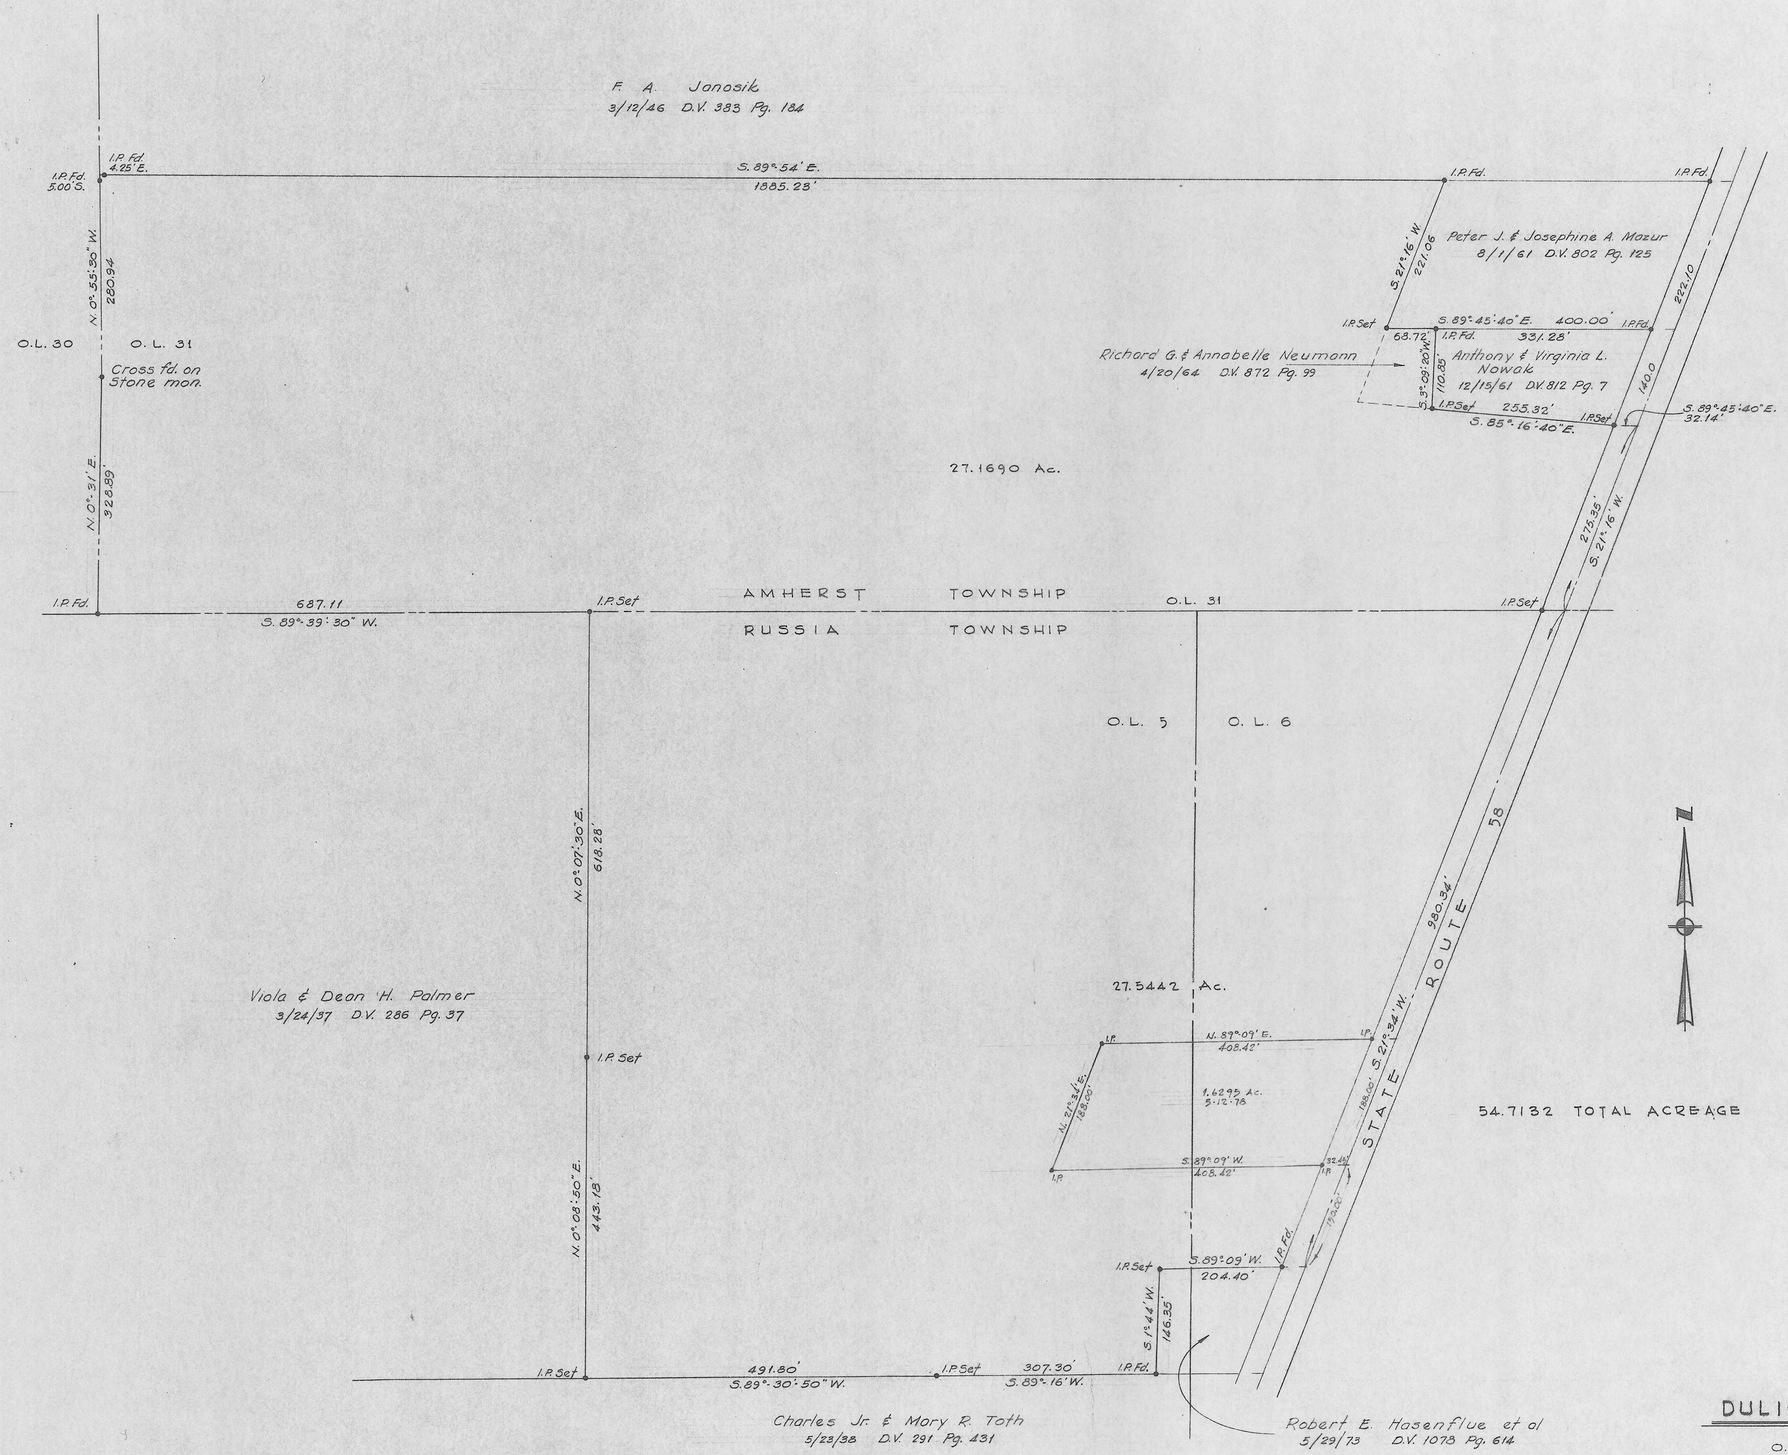

SURVEY FOR

DULIO GOLF ENTERPRISES INC.

O.L. 31 AMHERST TOWNSHIP
O.L.'s 5 & 6 RUSSIA TOWNSHIP
LORAIN COUNTY OHIO
SCALE 1"=100' SEPT. 1973
LAUNDON · SIMON · CAHL & ASSOC.
ENGINEERS & SURVEYORS

REVISED 5-12-78 1.6295 ACRE PARCEL CUT

Job Nº 73-159