PPN 05 00 016 102 222
05 00 023 115 222
05 00 043 000 222

Imp PP 5 00 016 B 44020
5 00 023 A
5 00 043 A

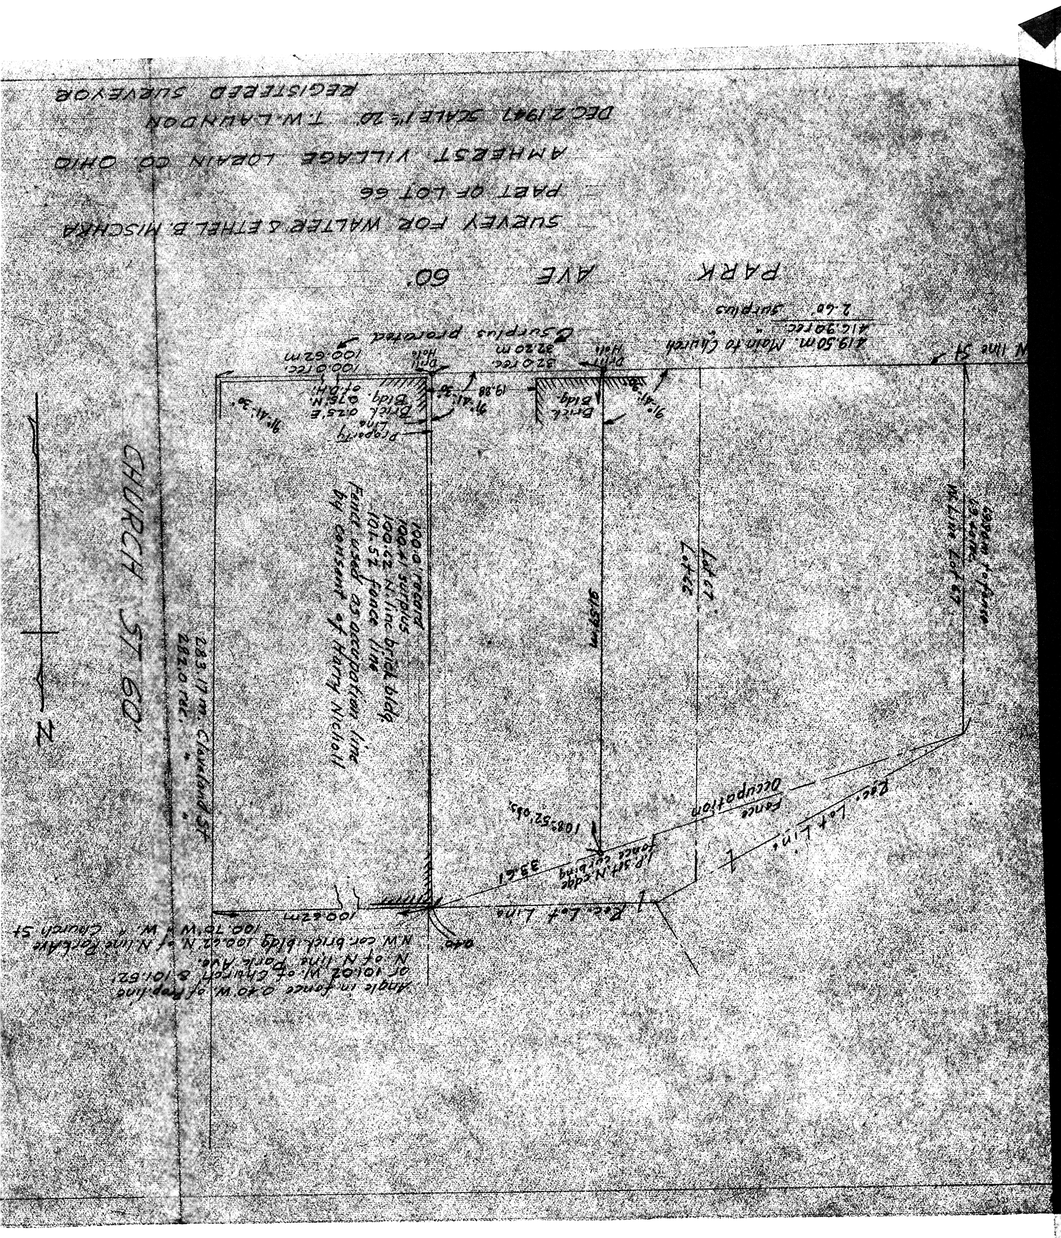
PARK AVE 60'
SURVEY FOR WALTEE & ETHEL B. MISCHKA
PART OF LOT 66
AMHERST VILLAGE LORAIN CO. OHIO
DEC 2, 1941 SCALE 1"=20' T.W. LAUNDON
REGISTERED SURVEYOR
N
Bldg. 0.25 E 0.75 N.
Brick Bldg. 0.25 E 0.75 N.
Frame
Brick Bldg.
Fence used as occupation line by consent of Harry Nicholl
Fence Occupation
Fence Lot Line
Lot Line
Surplus promised
Surplus
Main to Church
Church
Main St.
Lot Line
Lot Line
Lot Line