05-00-032-000-
5-00-032-B

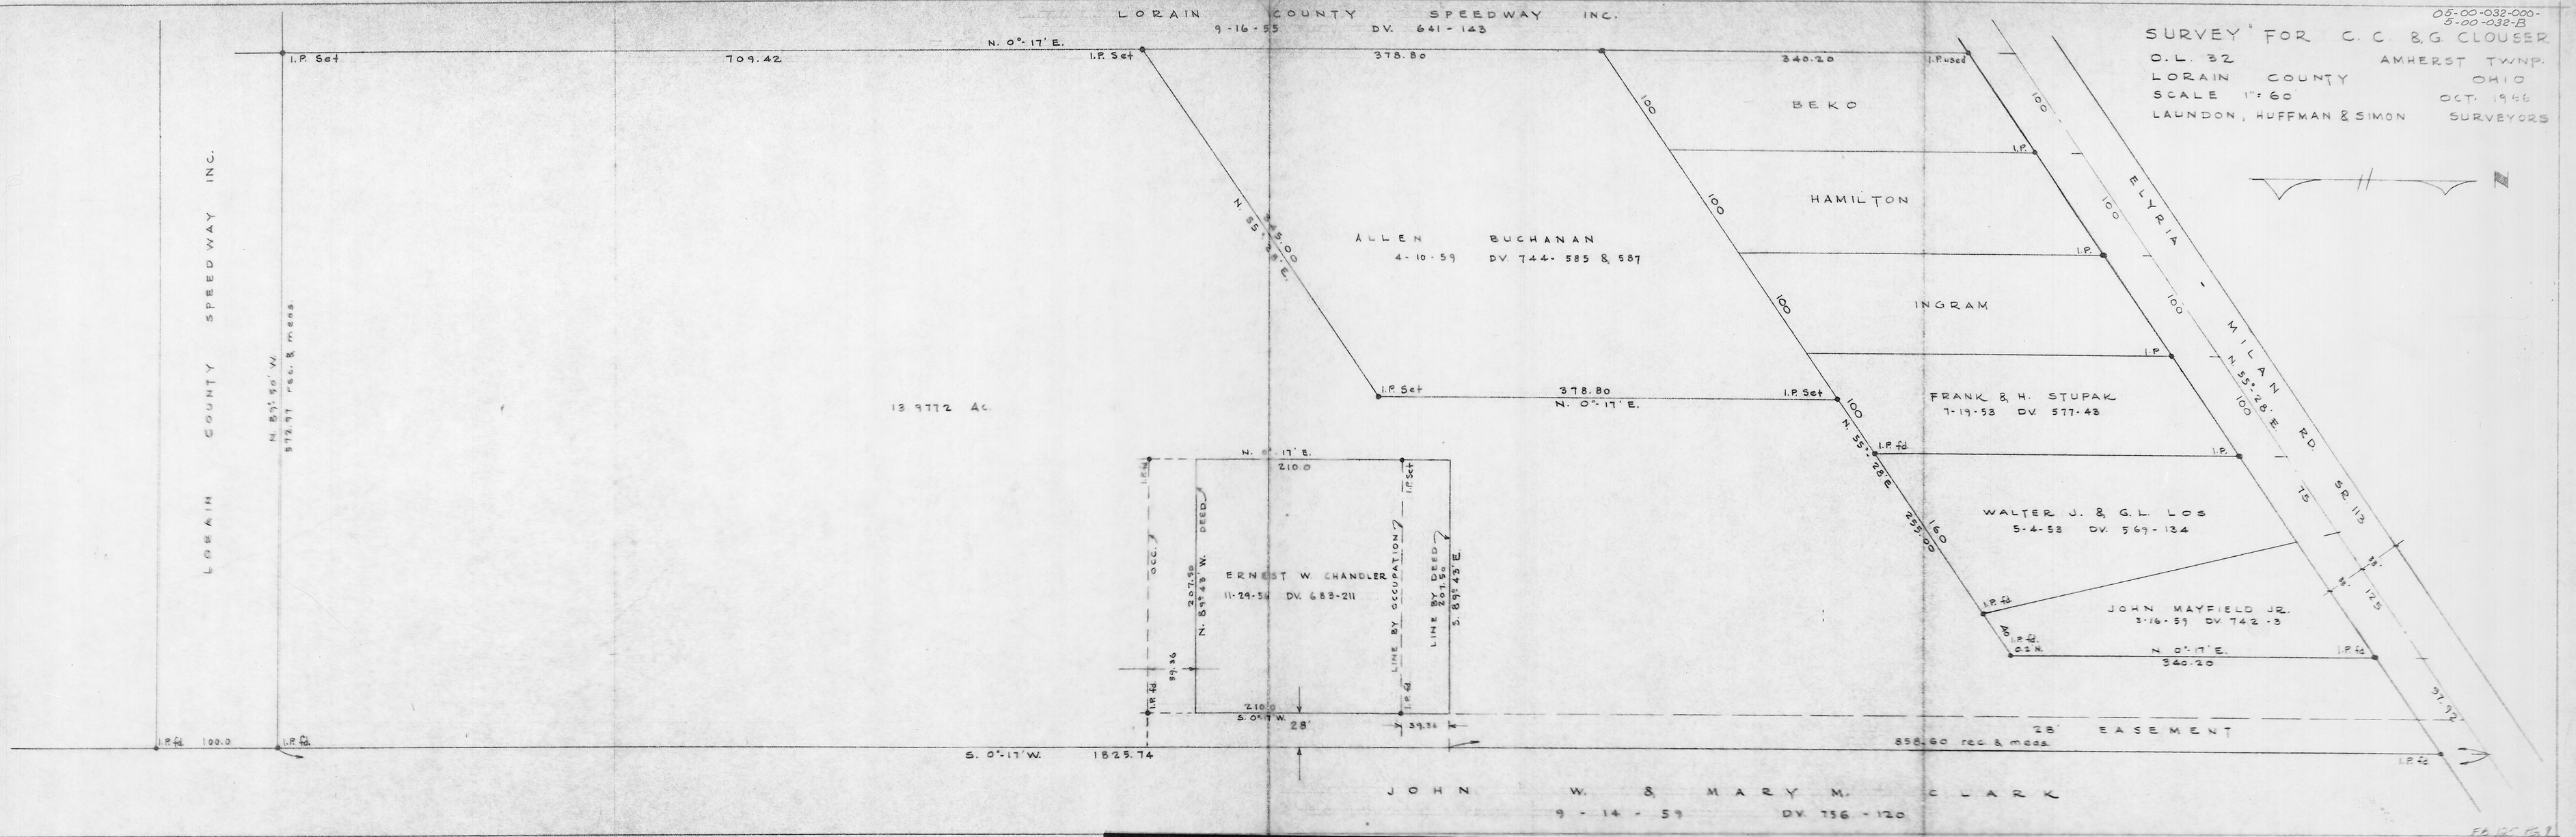

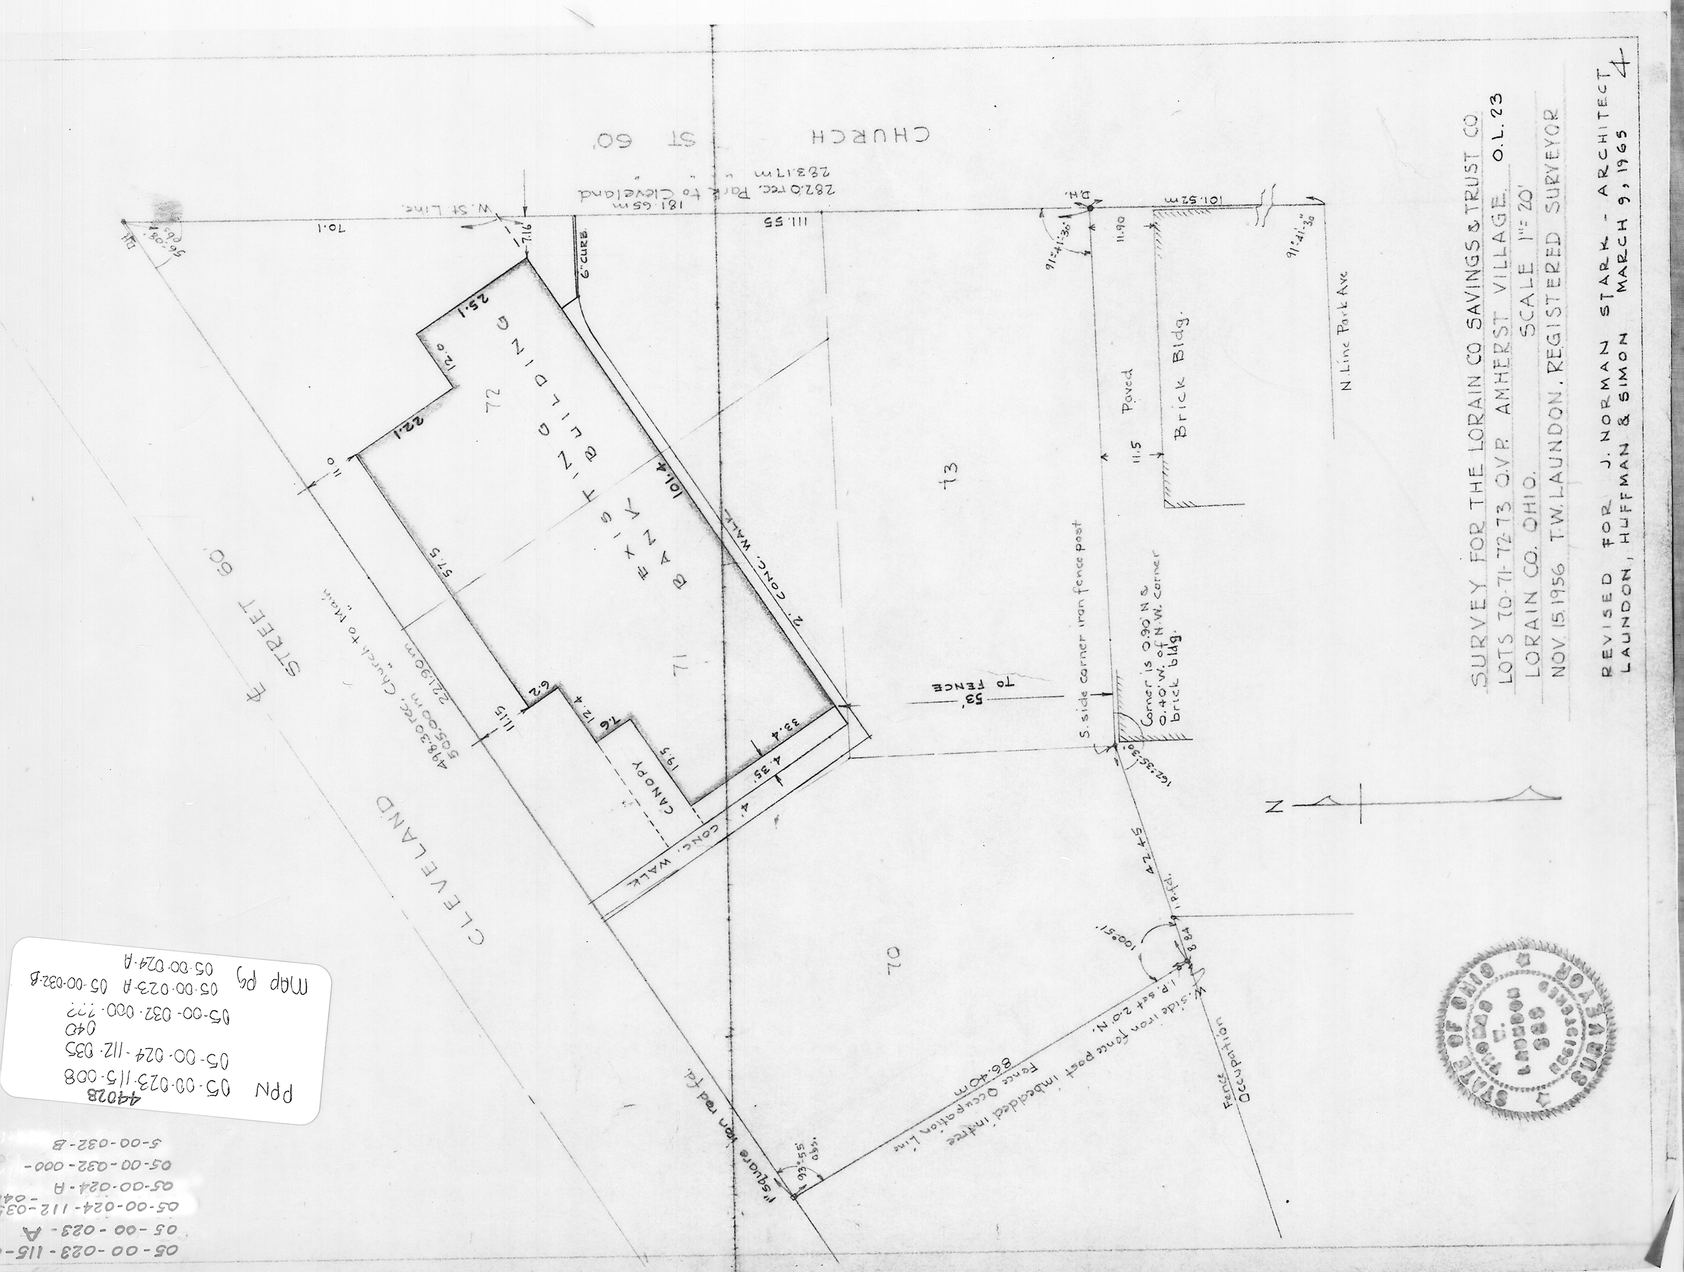
SURVEY FOR THE LORAIN CO. SAVINGS & TRUST CO.
LOTS 70-71-72-73 O.V.P. AMHERST VILLAGE O.L. 23
LORAIN CO. OHIO. SCALE 1" = 20'
NOV. 15 1956 T.W. LAUNDON, REGISTERED SURVEYOR
REVISED FOR J. NORMAN STARK - ARCHITECT
LAUNDON, HUFFMAN & SIMON MARCH 9, 1965
CHURCH ST 60'
CLEVELAND STREET 80'
BANKING BUILDING
CANOPY
Brick Bldg.
N. Line Park Ave.
N. St. Line
