05-00-023-116
5-00-023-A
05-00-023-117
5-00-023-B

PPN 05-00-023-116-???
05-00-023-117-???

Map PS 05-00-023-B
44029

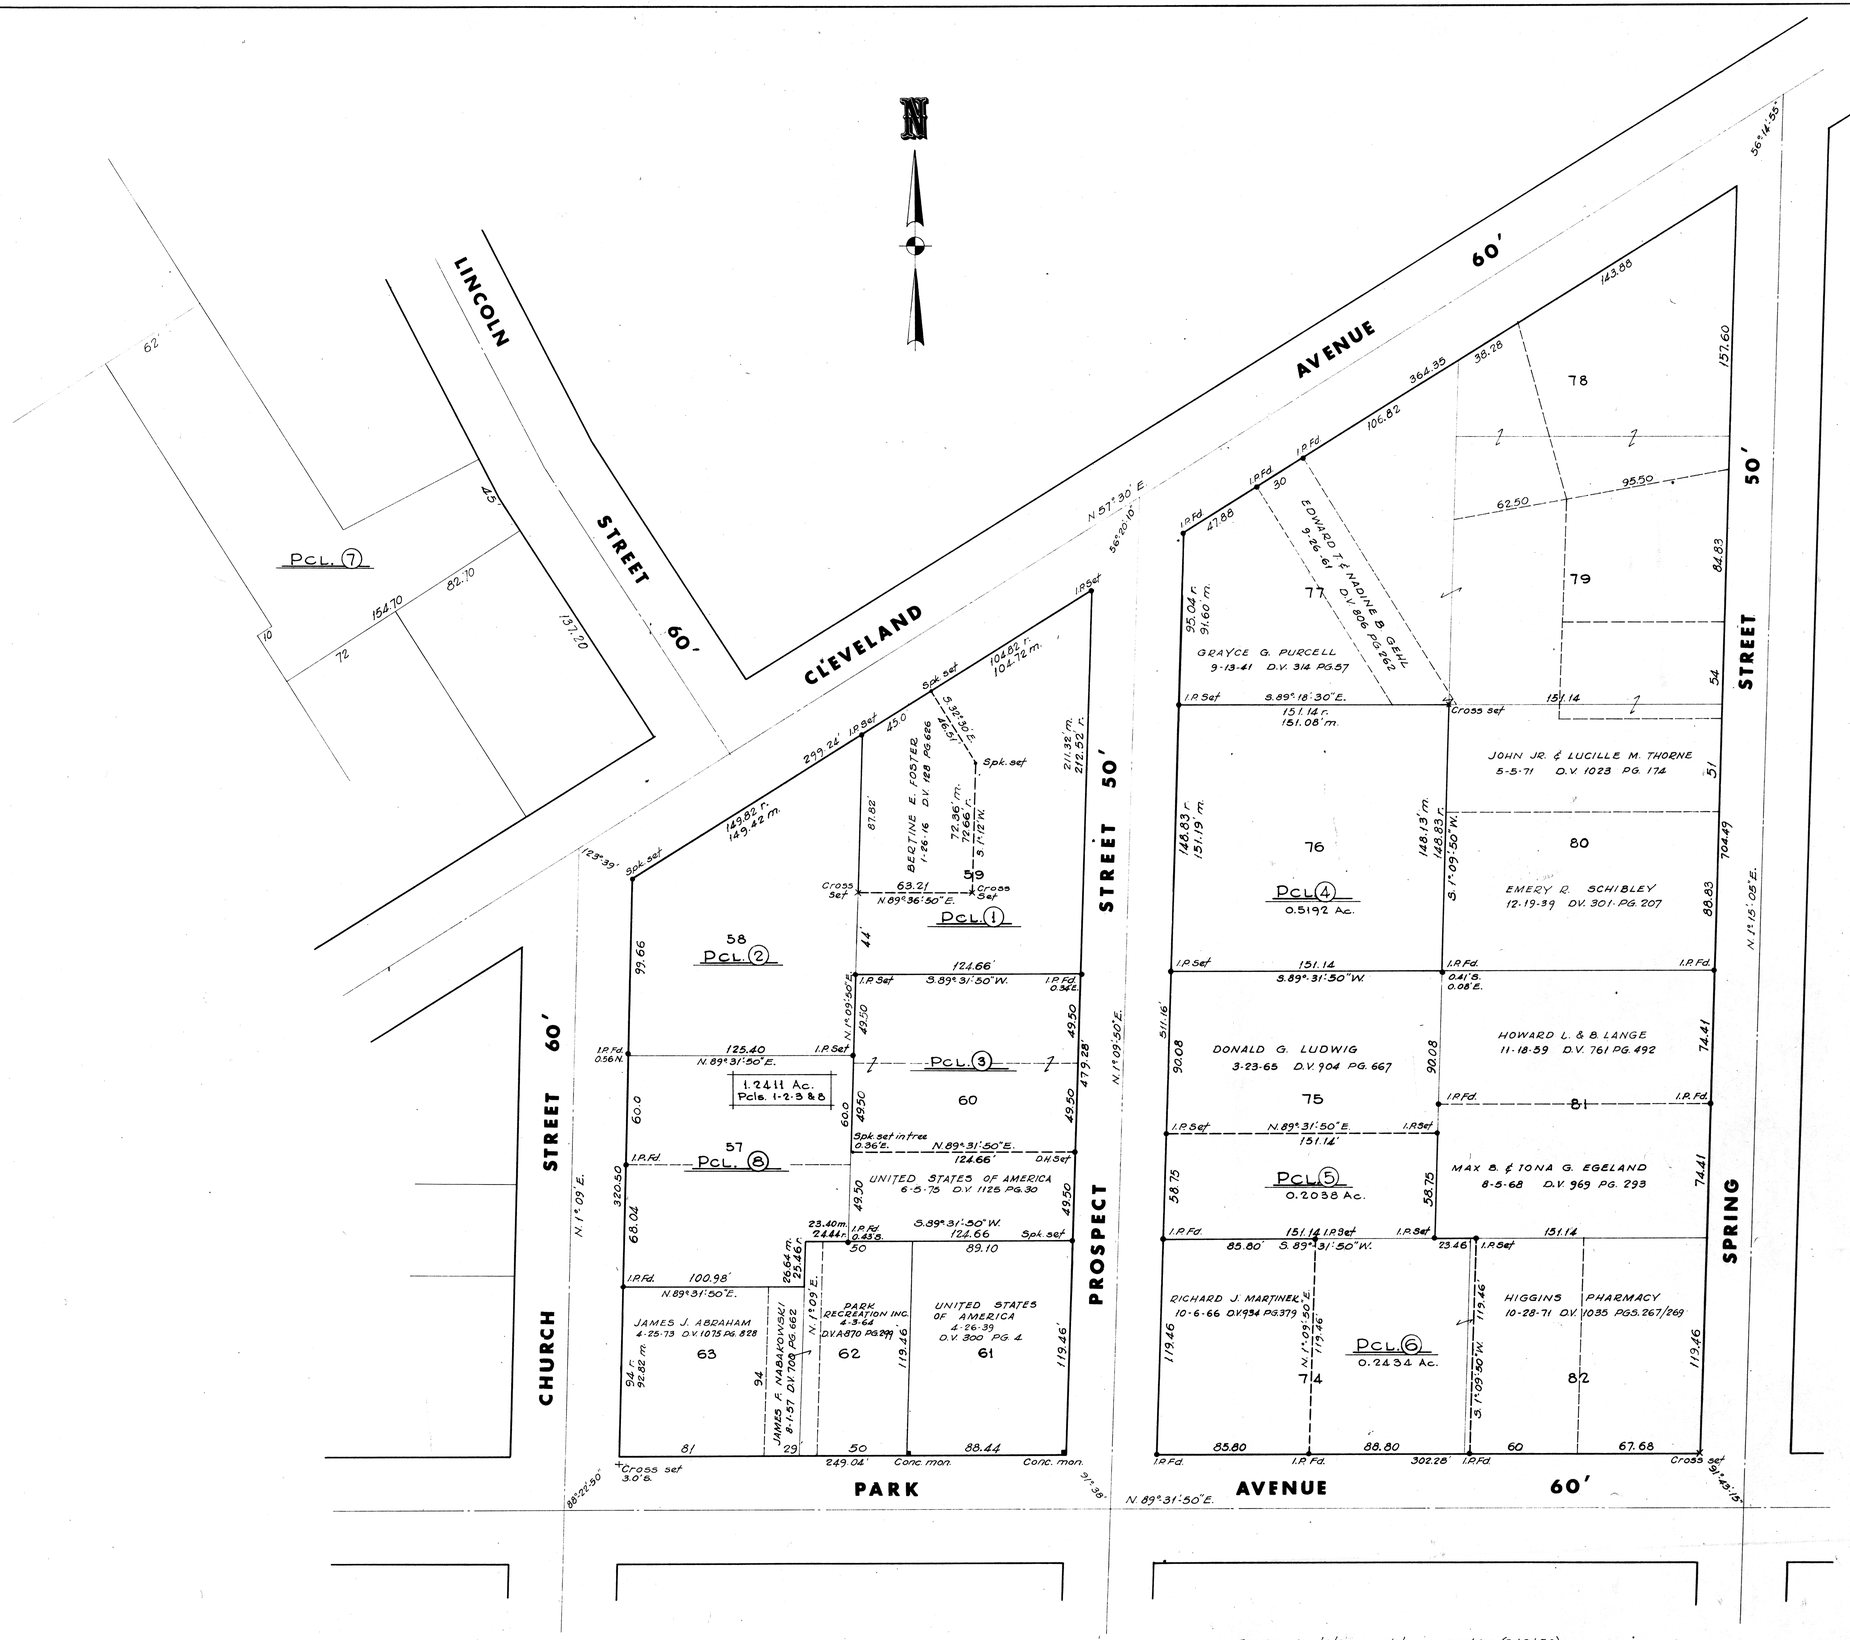

ONSTINE'S ADDITION
P.V. 1 PG. 5

PARCEL	DEED VOLUME	PAGE
1	153	149
	469	503
2	1063	514
3	1120	754
4	912	657
5	796	28
6	1036	180
7	795	423
8	1094	591

LANDS OF THE

AMHERST HOSPITAL ASSOCIATION

CITY OF AMHERST — OHIO
APRIL 1975 — 1" = 40'
LAUNDON·SIMON·CAHL & ASSOC. INC.
engineers — surveyors