05-00-024-104
5-00-024-B

PPN 05-00-024-104-???

MAP PG 05-00-024-B
44031

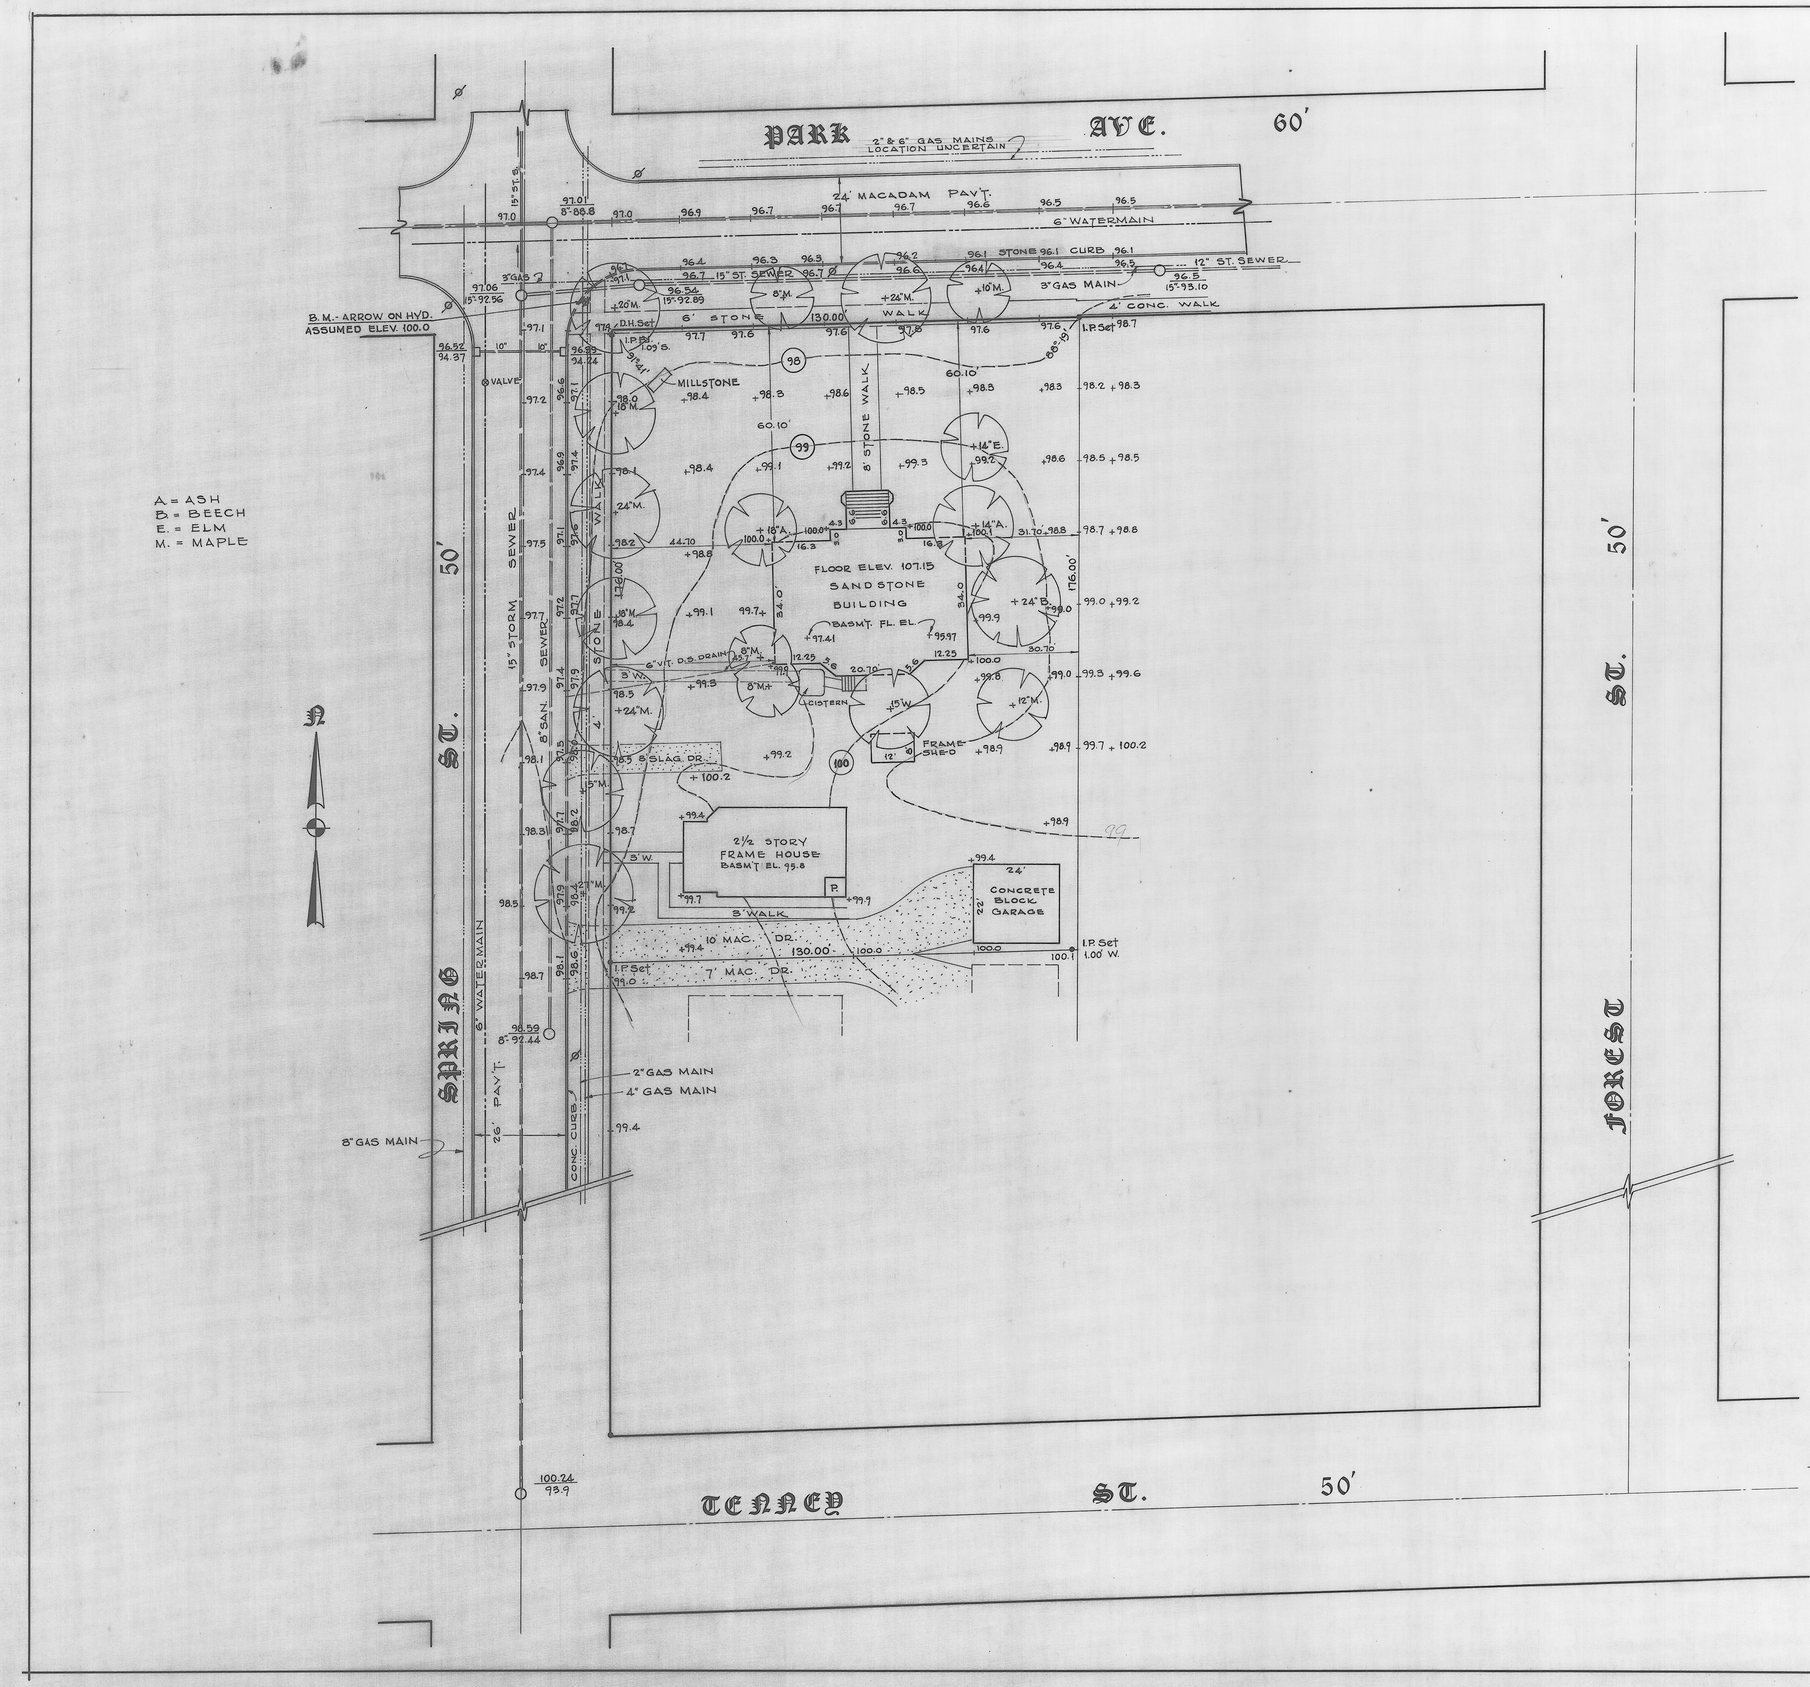

survey and topography

AMHERST PUBLIC LIBRARY

lot 134 and part of lot 137 in M.C. Seeley's Add.
city of amherst lorain co. ohio
scale 1" 20' june 1974
laundon · simon · cahl and assoc. inc.
engineers surveyors

74-303

46