11-00-076-101-001
11-00-076-101-002
11-00-076-101-027
Pt. 11-00-076-101-057
11-00-076-A

PPN 11-00-076-101-001
002
027
057

MAP PG 11-00-076-A
44033

NOTE: LOCATION & SIZES OF STORM SEWER and LATERALS ALONG MAPLE STREET DERIVED FROM DRAWING INFO. BY LAUNDON, HUFFMAN & SIMON DATED JAN. 1971

NOTE: TYP. SAN. SEWER WYES. LOCATION DERIVED FROM LAUNDON, HUFFMAN & SIMON DRWG. DATED JAN., 1971

NOTE: PER COLUMBIA G&S Co. DRWG. INFO., A 3" M.P. GAS LINE EXISTS ON THE EAST SIDE OF N. PLEASANT ST.; ALONG THE SOUTH SIDE OF MAPLE AVE. and ALONG THE EAST SIDE OF N. MAIN ST. ~

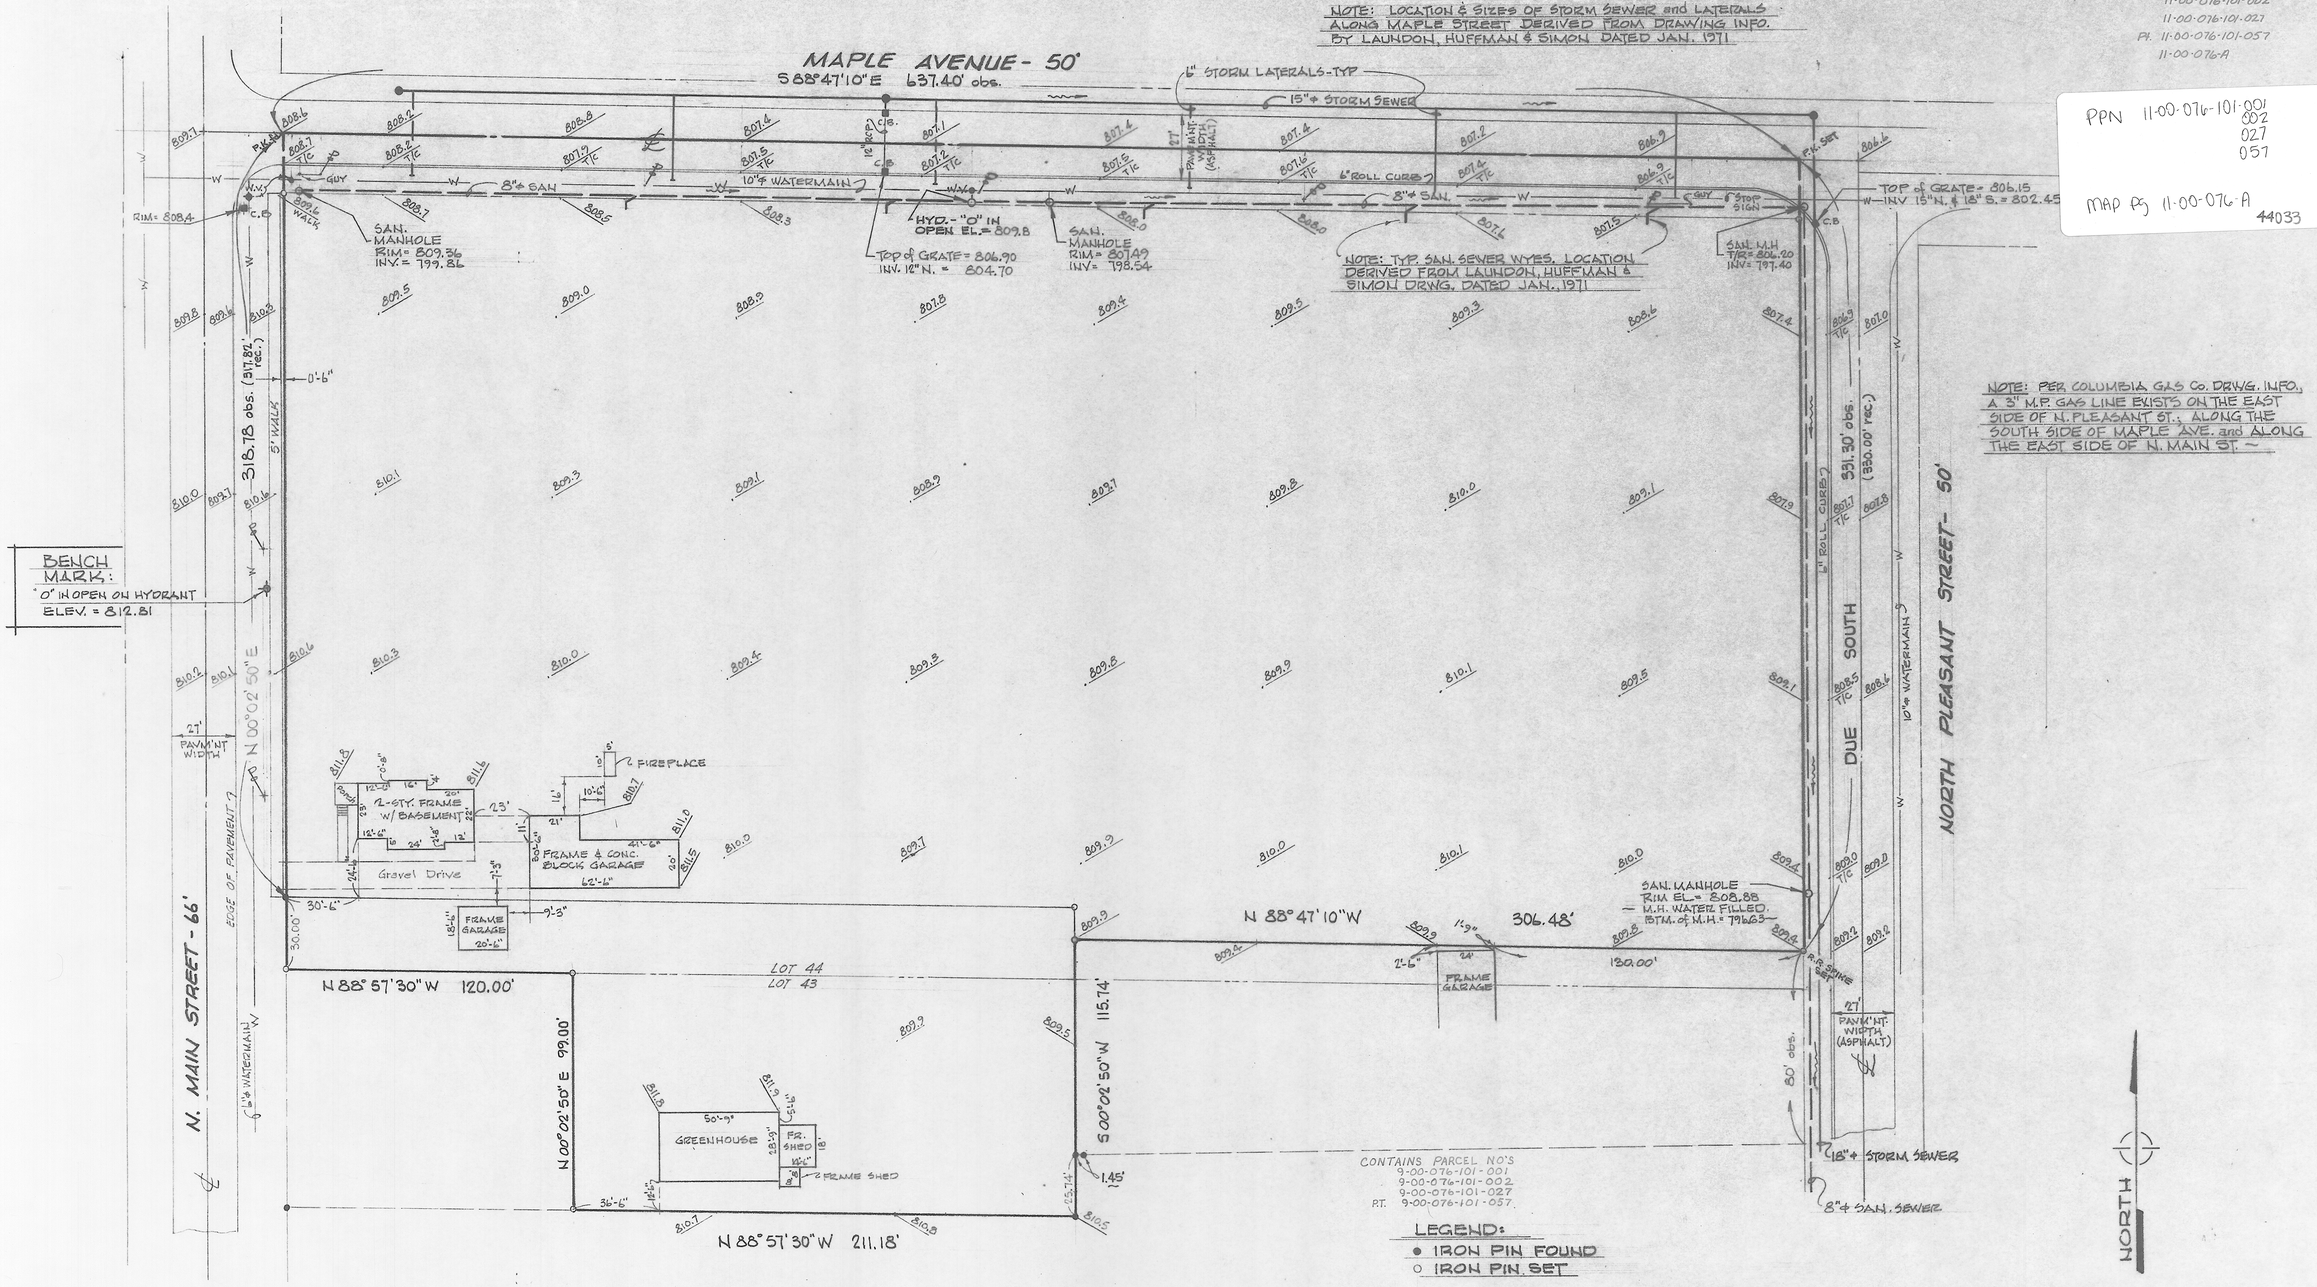

CONTAINS PARCEL NO'S
9-00-076-101-001
9-00-076-101-002
9-00-076-101-027
P.T. 9-00-076-101-057.

LEGEND:
- ● IRON PIN FOUND
- ○ IRON PIN SET

MAP of BOUNDARY and TOPOGRAPHIC SURVEY

PREPARED FOR CLARK and POST ARCHITECTS INC.

PART of LOT 43 and ALL of LOT 44 of ORIG. VILLAGE PLAT - VOL. 1, PG 20
PART of ORIGINAL RUSSIA TOWNSHIP LOT No. 76
NOW in CITY of OBERLIN, LORAIN COUNTY, OHIO

McGLINCHY AND ASSOCIATES
PROFESSIONAL ENGINEERS AND SURVEYORS
538 WEST BROAD ST. ELYRIA, OHIO

SCALE: 1" = 30' DRAWN BY: BOB
DATE: MAR. 1979 JOB NO: 794898

9-00-076-A